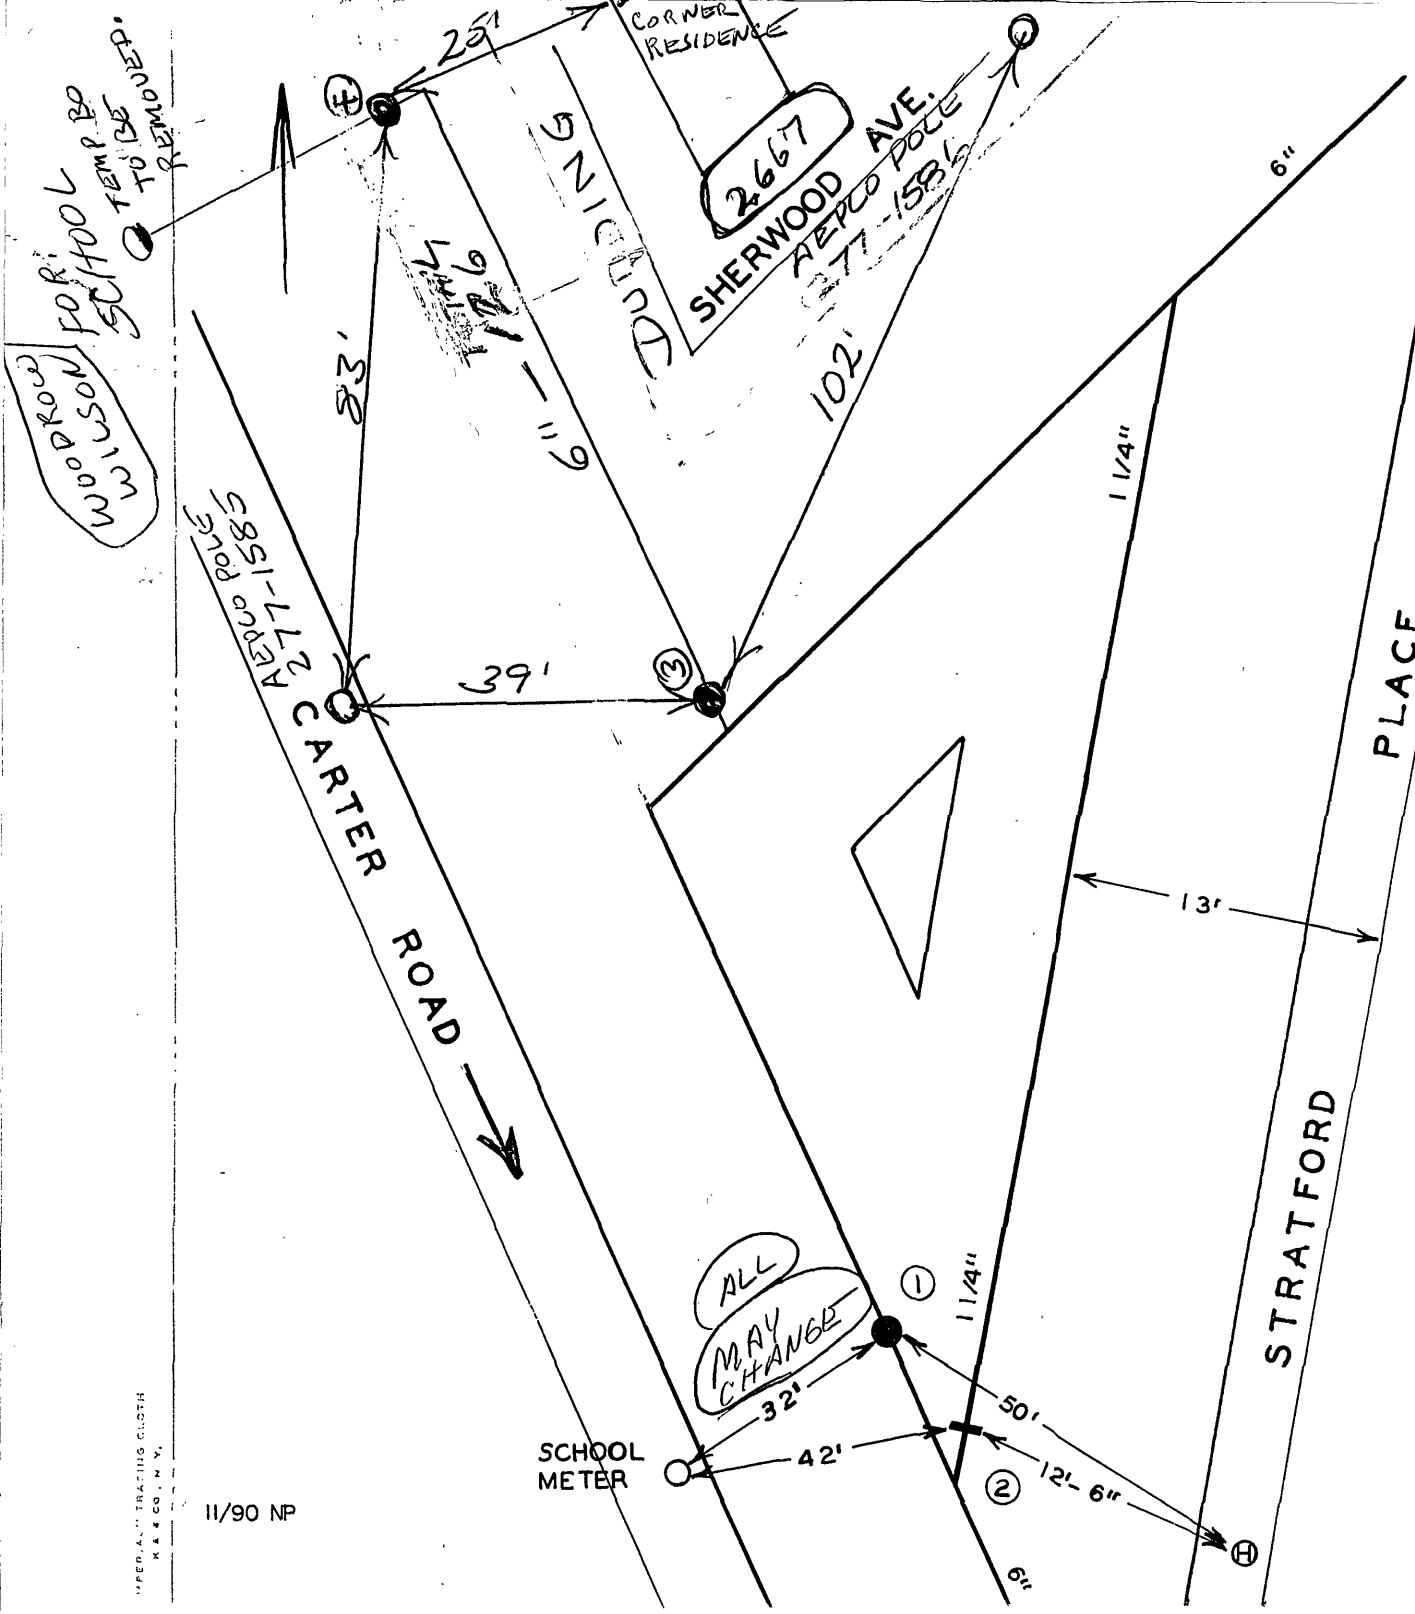


| DATE | NO. | SIZE | MAKE | OPEN | TURNS |
|---|---|---|---|---|---|
| 1924 | 1 | 6" | | R | 20 1/2 |
| 1922 | 2 | 1 1/4" | | R | 5 1/2 |
| 9-1997 | 3 | 6" | DARLING | R | 21 |
| 9-1997 | 4 | 6" | DARLING | R | 21 |
| | | | | | |
| | | | | | |
| | | | | | |
| | | | | | |
| | | | | | |
| | | | | | |
| | | | | | |
| | | | | | |
| ~~1~~ | ~~10'S~~ | ~~N.P.L.~~ | | | |
| ~~2~~ | ~~17'W.~~ | ~~E.P.L.~~ | | | |
| | | | | | |
| | | | | | |

CITY OF ROANOKE — WATER DEPT.

VALVE DIAGRAM

CARTER ROAD-SHERWOOD AVENUE & STRATFORD PLACE

DUDDING & CARTER RD.

SEC. MAP 144 S.W.

DATE PAGE NO.

11/90 NP

"PERLA" TRACING CLOTH K & E CO., N.Y.