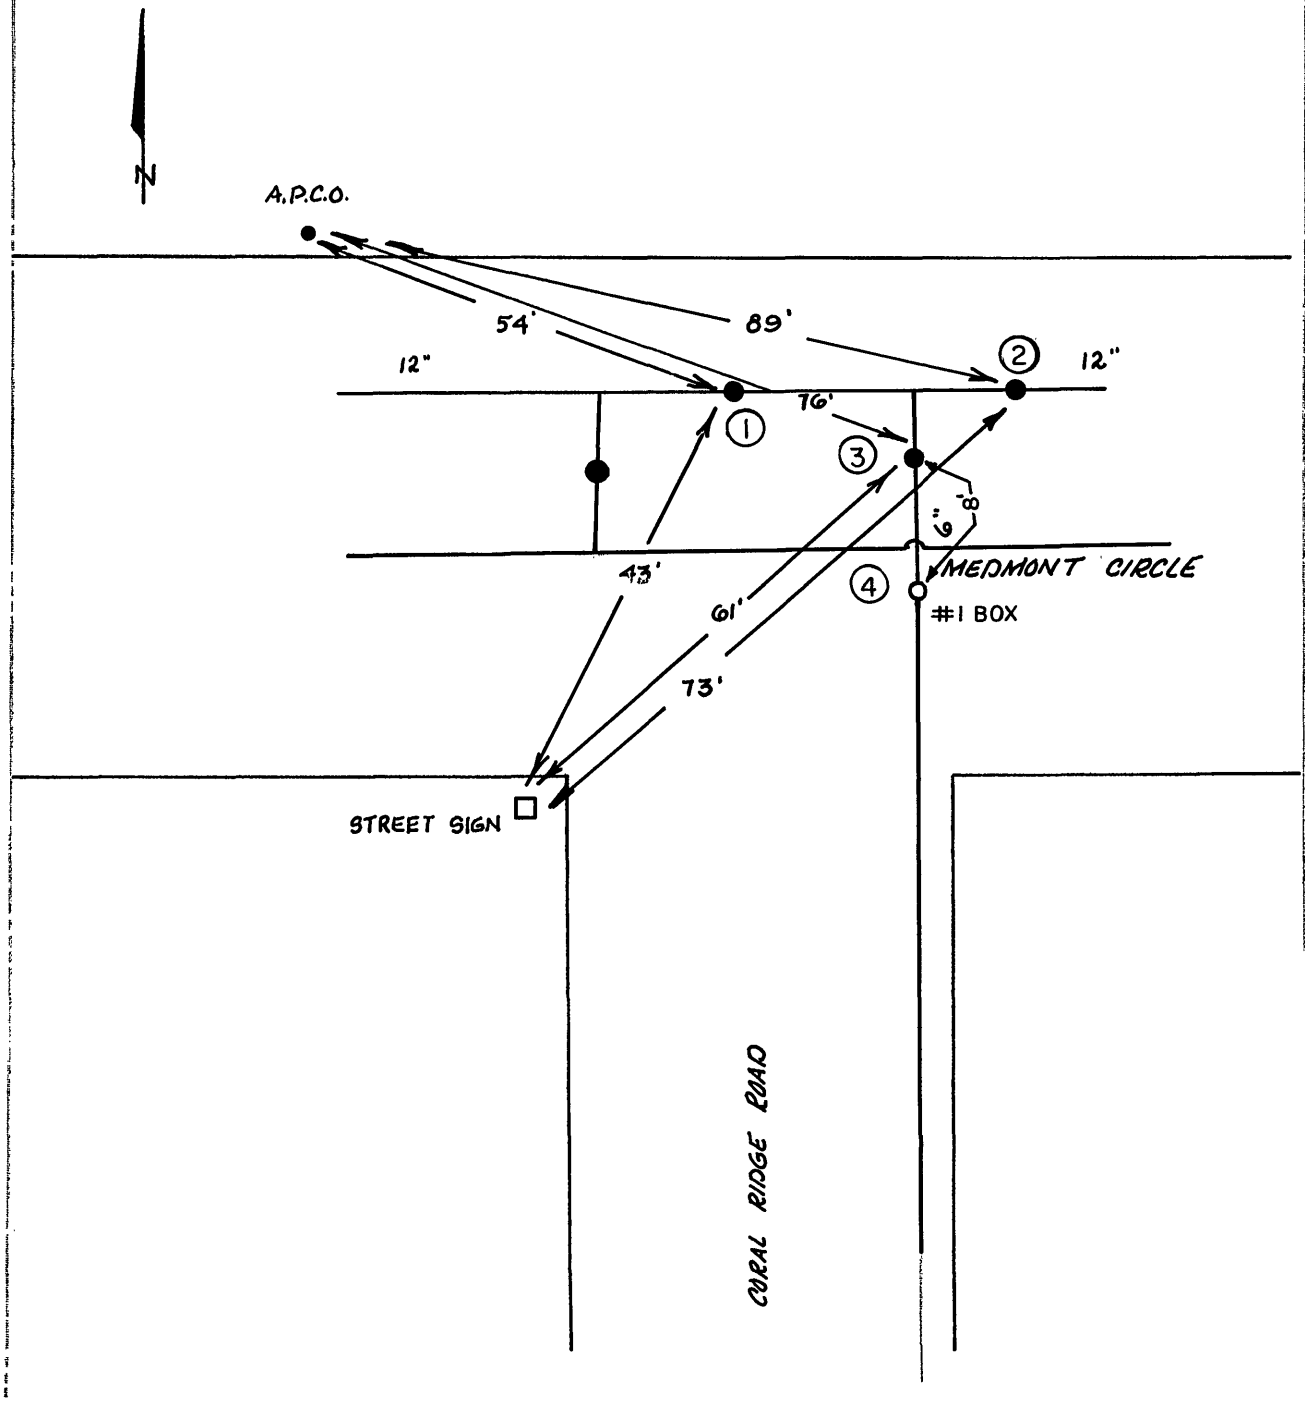

DATE	NO.	SIZE	MAKE	OPEN	TURNS
5-78	1	12"	MUELLER	R	
5-78	2	12"	MUELLER	R	
5-78	3	6"	MUELLER	R	
1986	4	6"		R	

CITY OF ROANOKE--WATER DEP'T

VALVE DIAGRAM

CORAL RIDGE ROAD AND

MEDMONT CIRCLE S.W.

DIG. MAP 513

DATE PAGE NO.

5/94 NP