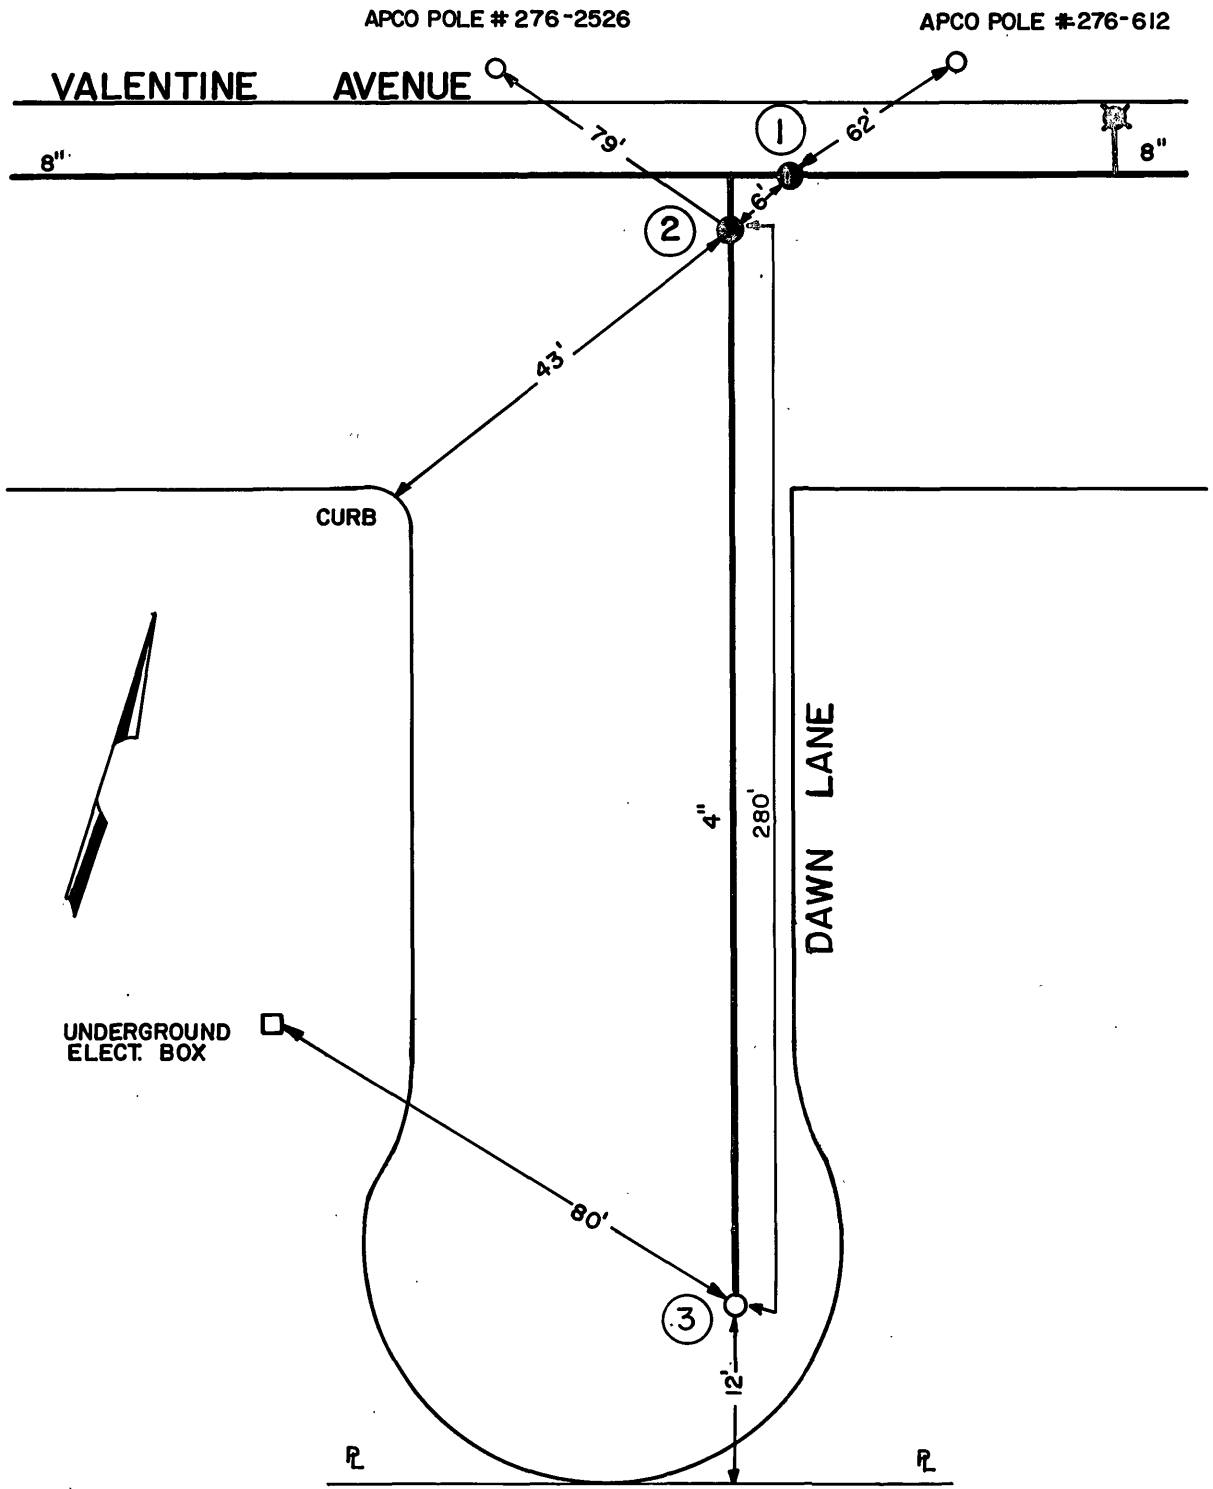

DATE	NO.	SIZE	MAKE	OPEN	TURNS
4-85	1	8"	MUELLER	R	27
4-85	2	4"	MUELLER	R	15
4-85	3	2"	MISCELLAN. BLOW OFF	L	

CITY OF ROANOKE—WATER DEP'T

VALVE DIAGRAM

DAWN LANE &

VALENTINE AVENUE

SEC. MAP 507, 518 S.W.

DATE PAGE NO.

8/88 NP