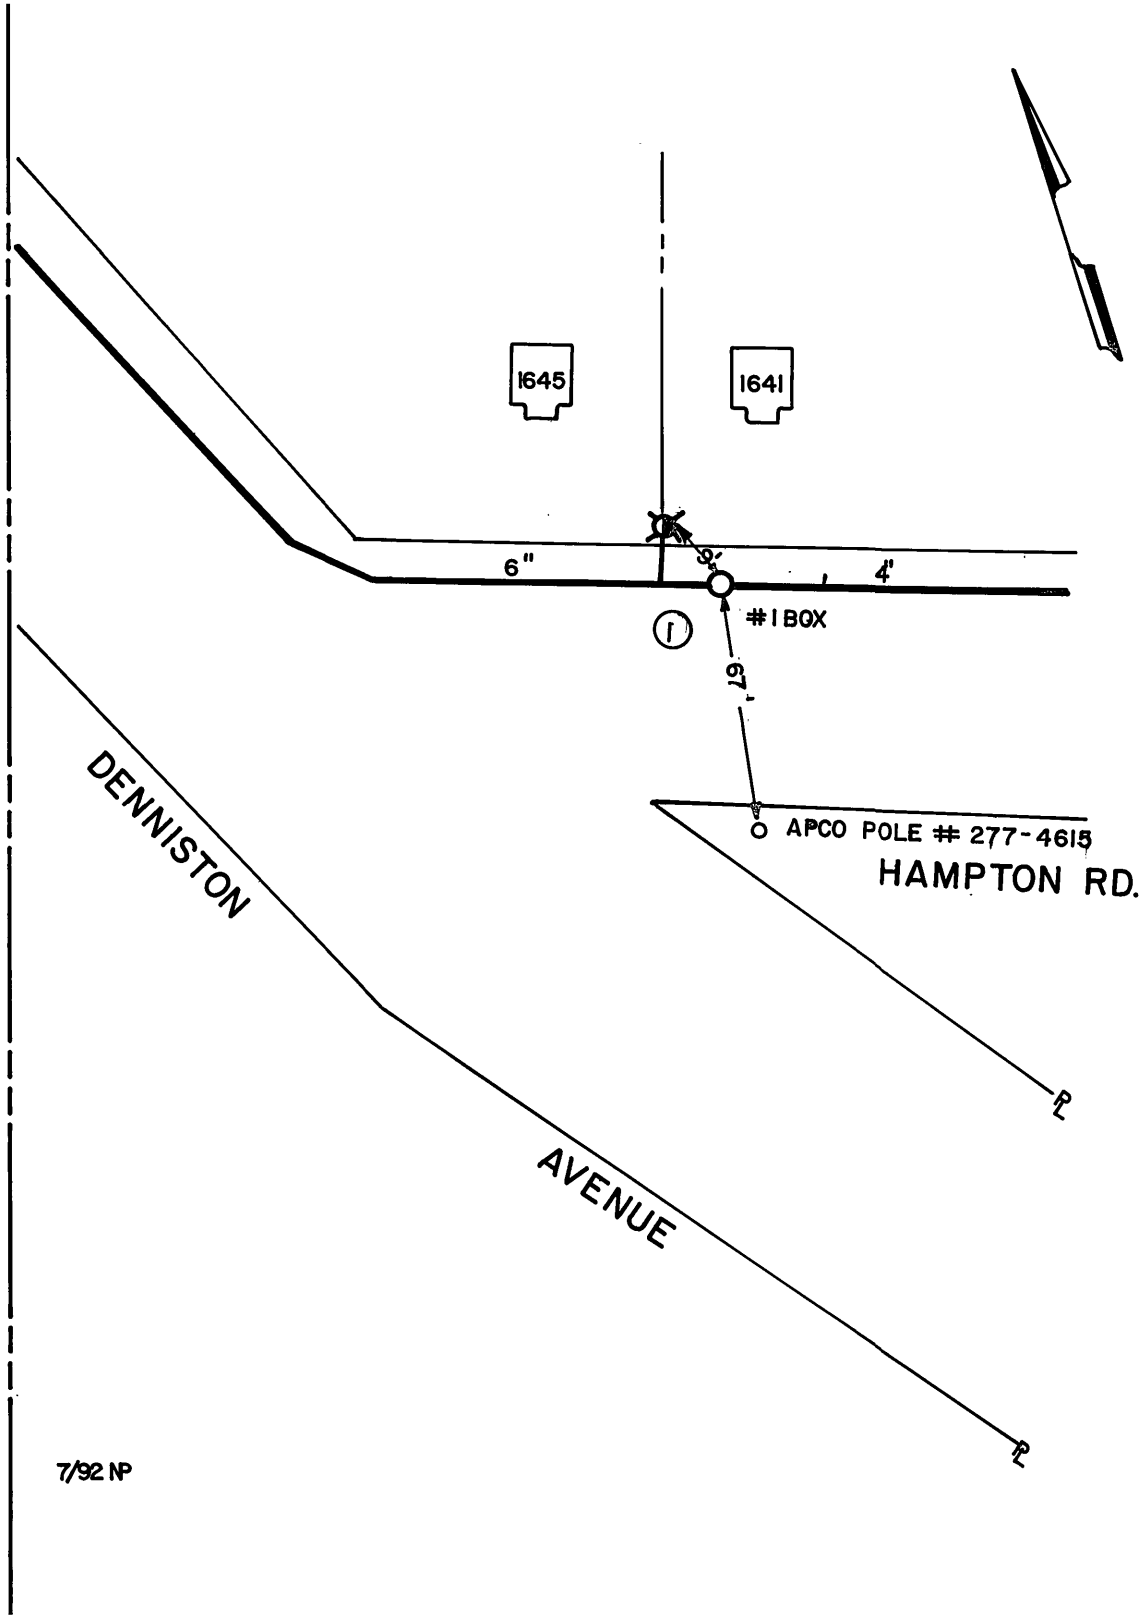

DATE	NO.	SIZE	MAKE	OPEN	TURNS
2-92	1	6"	DARLING	R	21

CITY OF ROANOKE - WATER DEP'T.

VALVE DIAGRAM

DENNISTON AVE. &

HAMPTON AVE.

SEC. MAP 133 S.W.

DATE: PAGE NO.