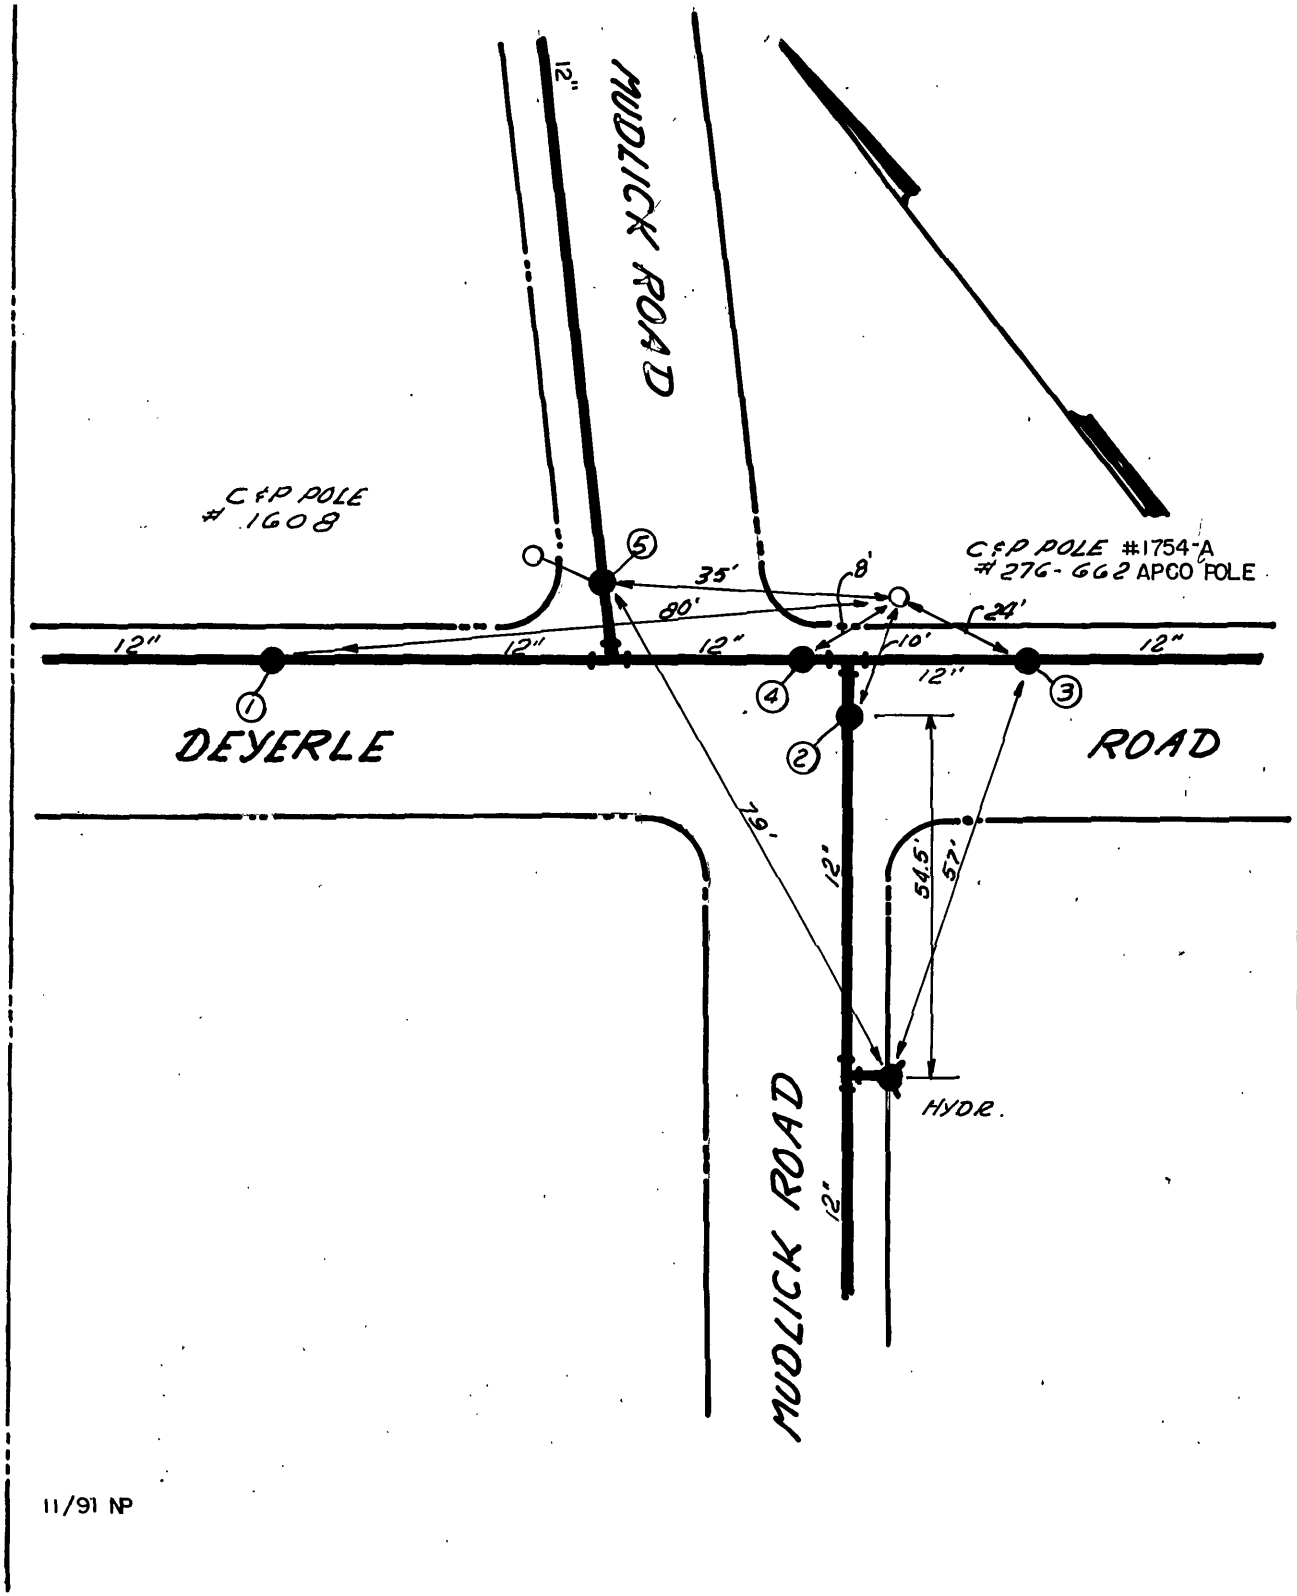

DATE	NO.	SIZE	MAKE	OPEN	TURNS
6/82	1	12"	KENNEDY	R	39
1979	2	12"	DARLING	R	39
1979	3	12"	DARLING	R	39
1979	4	12"	DARLING	R	39
6/82	5	12"	KENNEDY	R	39

CITY OF ROANOKE—WATER DEP'T

VALVE DIAGRAM

DEYERLE ROAD AND MUDLICK ROAD

SW

SEC. MAP 504, 507

DATE 6-25-84 PAGE NO. 1

11/91 NP