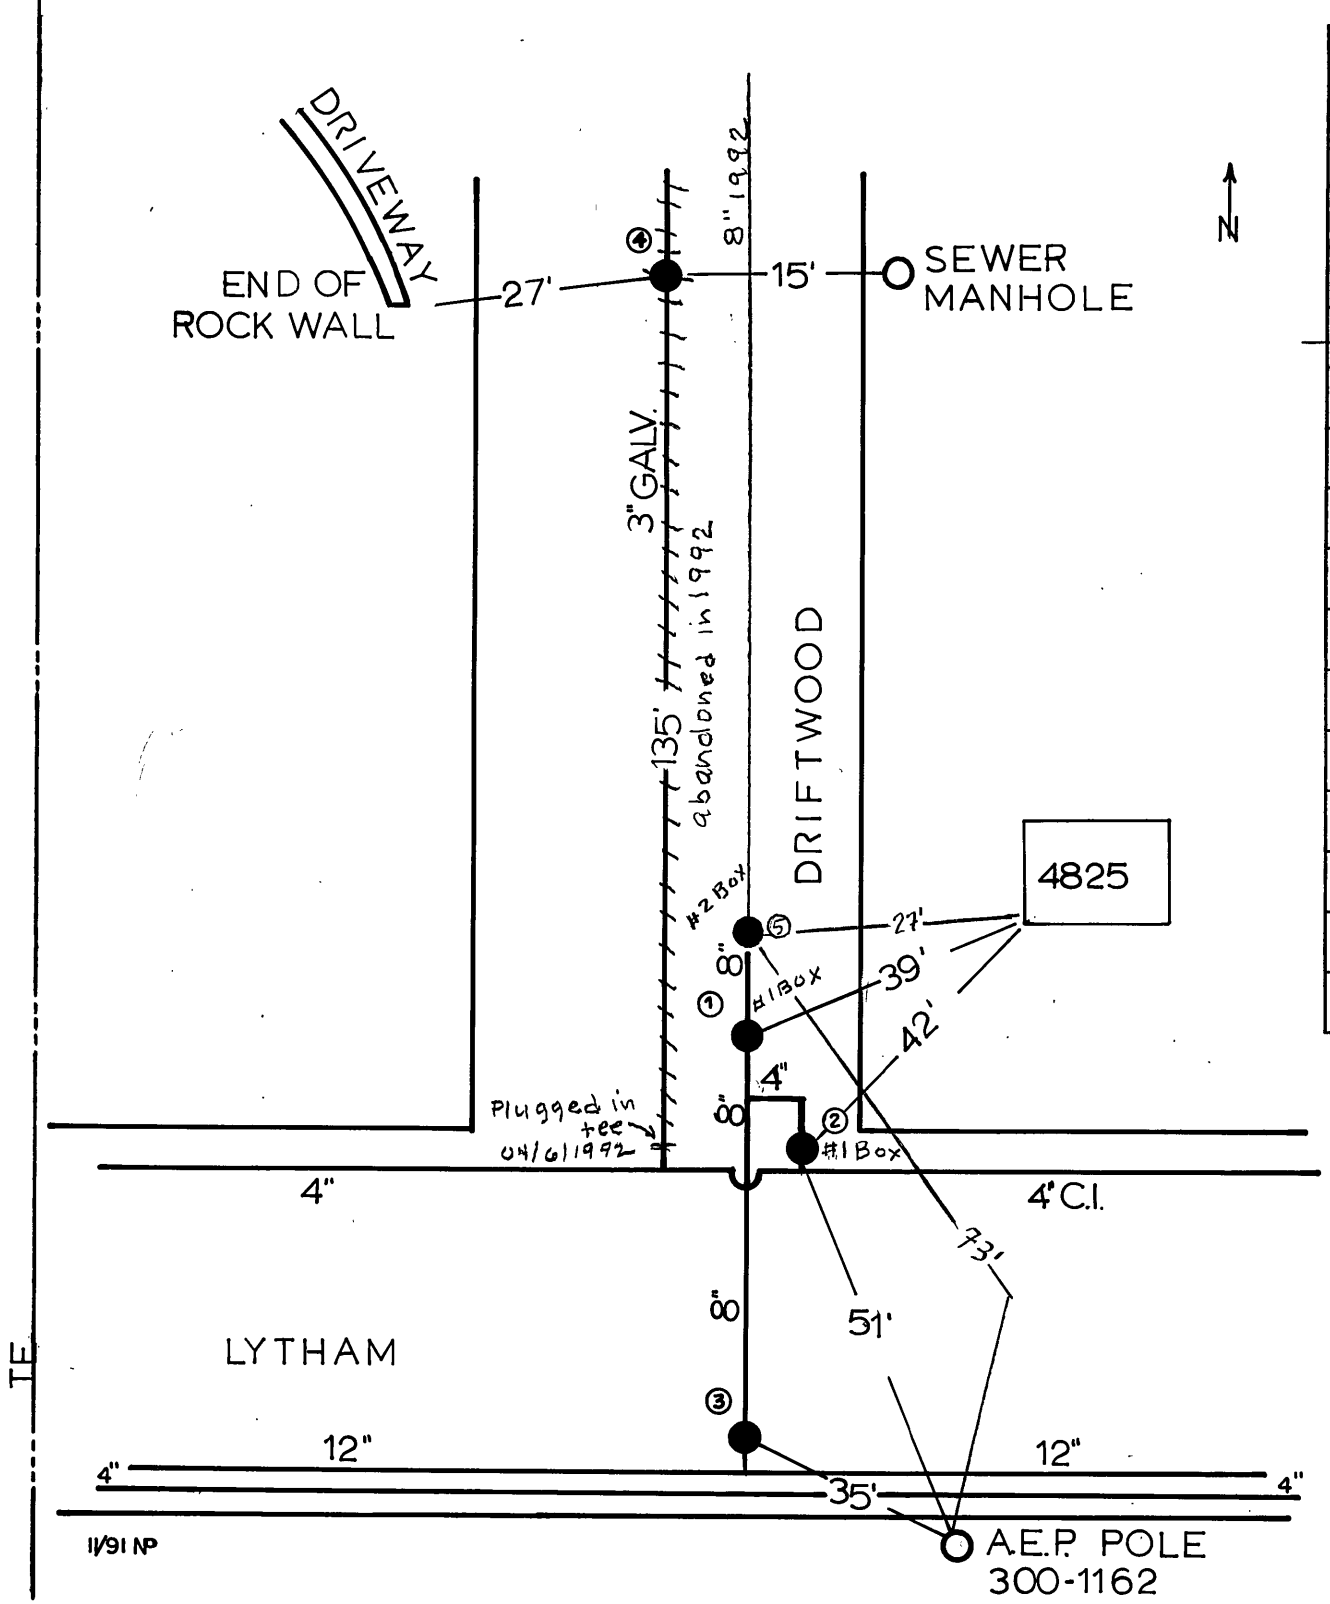

DATE	NO.	SIZE	MAKE	OPEN	TURNS
7/80	1	8"	MUL.	R	27
7/80	2	4"	MUL.	R	15
7/80	3	8"	MUL.	R	27
~~7/80~~	~~4~~	~~3"~~	~~MISC.~~	~~L~~	~~12~~
3/1992	5	3/4"	CORP. COCK	—	—

CITY OF ROANOKE—WATER DEP'T

VALVE DIAGRAM

DRIFTWOOD LANE

LYTHAM DRIVE

SEC. MAP 511,508 S.W.

DATE 4/81 PAGE NO.