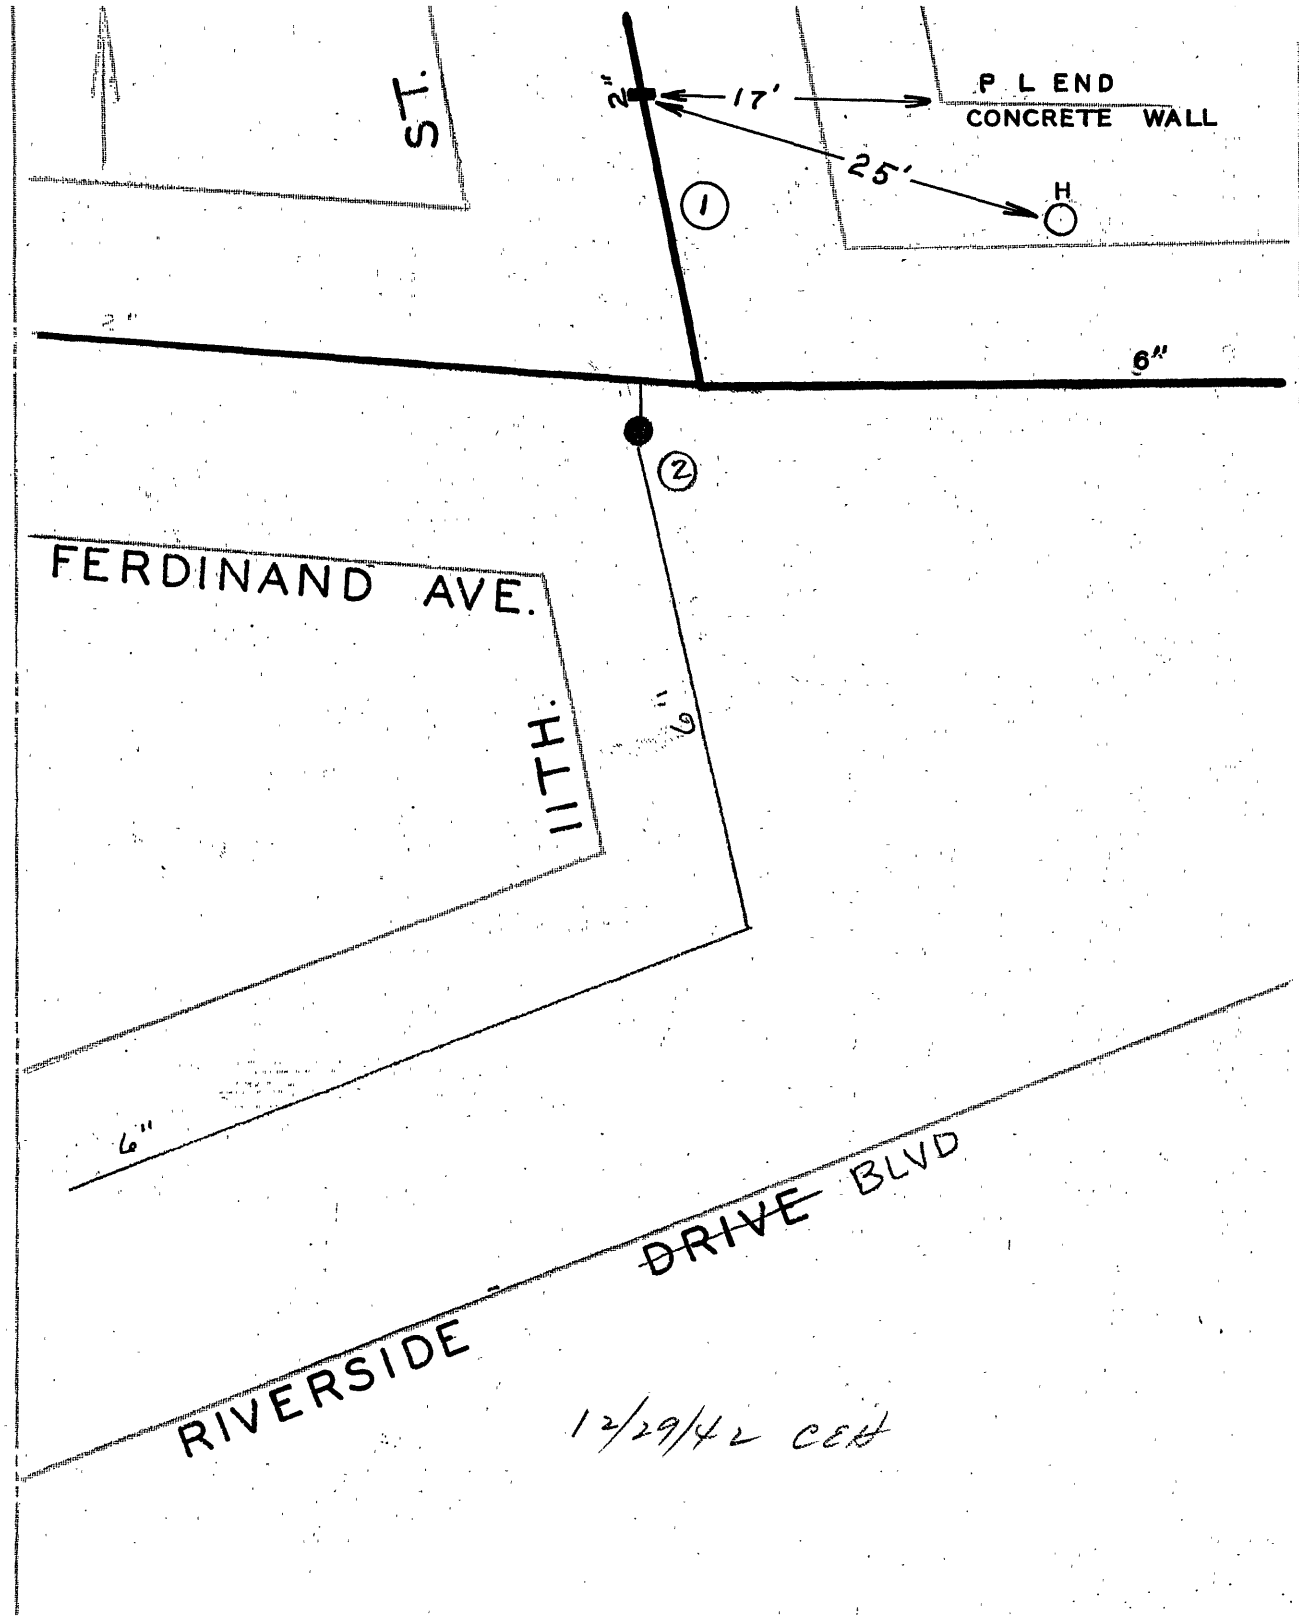

DATE	NO.	SIZE	MAKE	OPEN	TURNS
1927	1	2"		R	8
1994	2	6"			
	1	0	NPL		

CITY OF ROANOKE—WATER DEPT

VALVE DIAGRAM

FERDINAND AVE. 11TH.

ST. & RIVERSIDE ~~DRIVE~~. BLVD.

S. W.

SEC. MAP 111

DATE PAGE NO. S.W.149