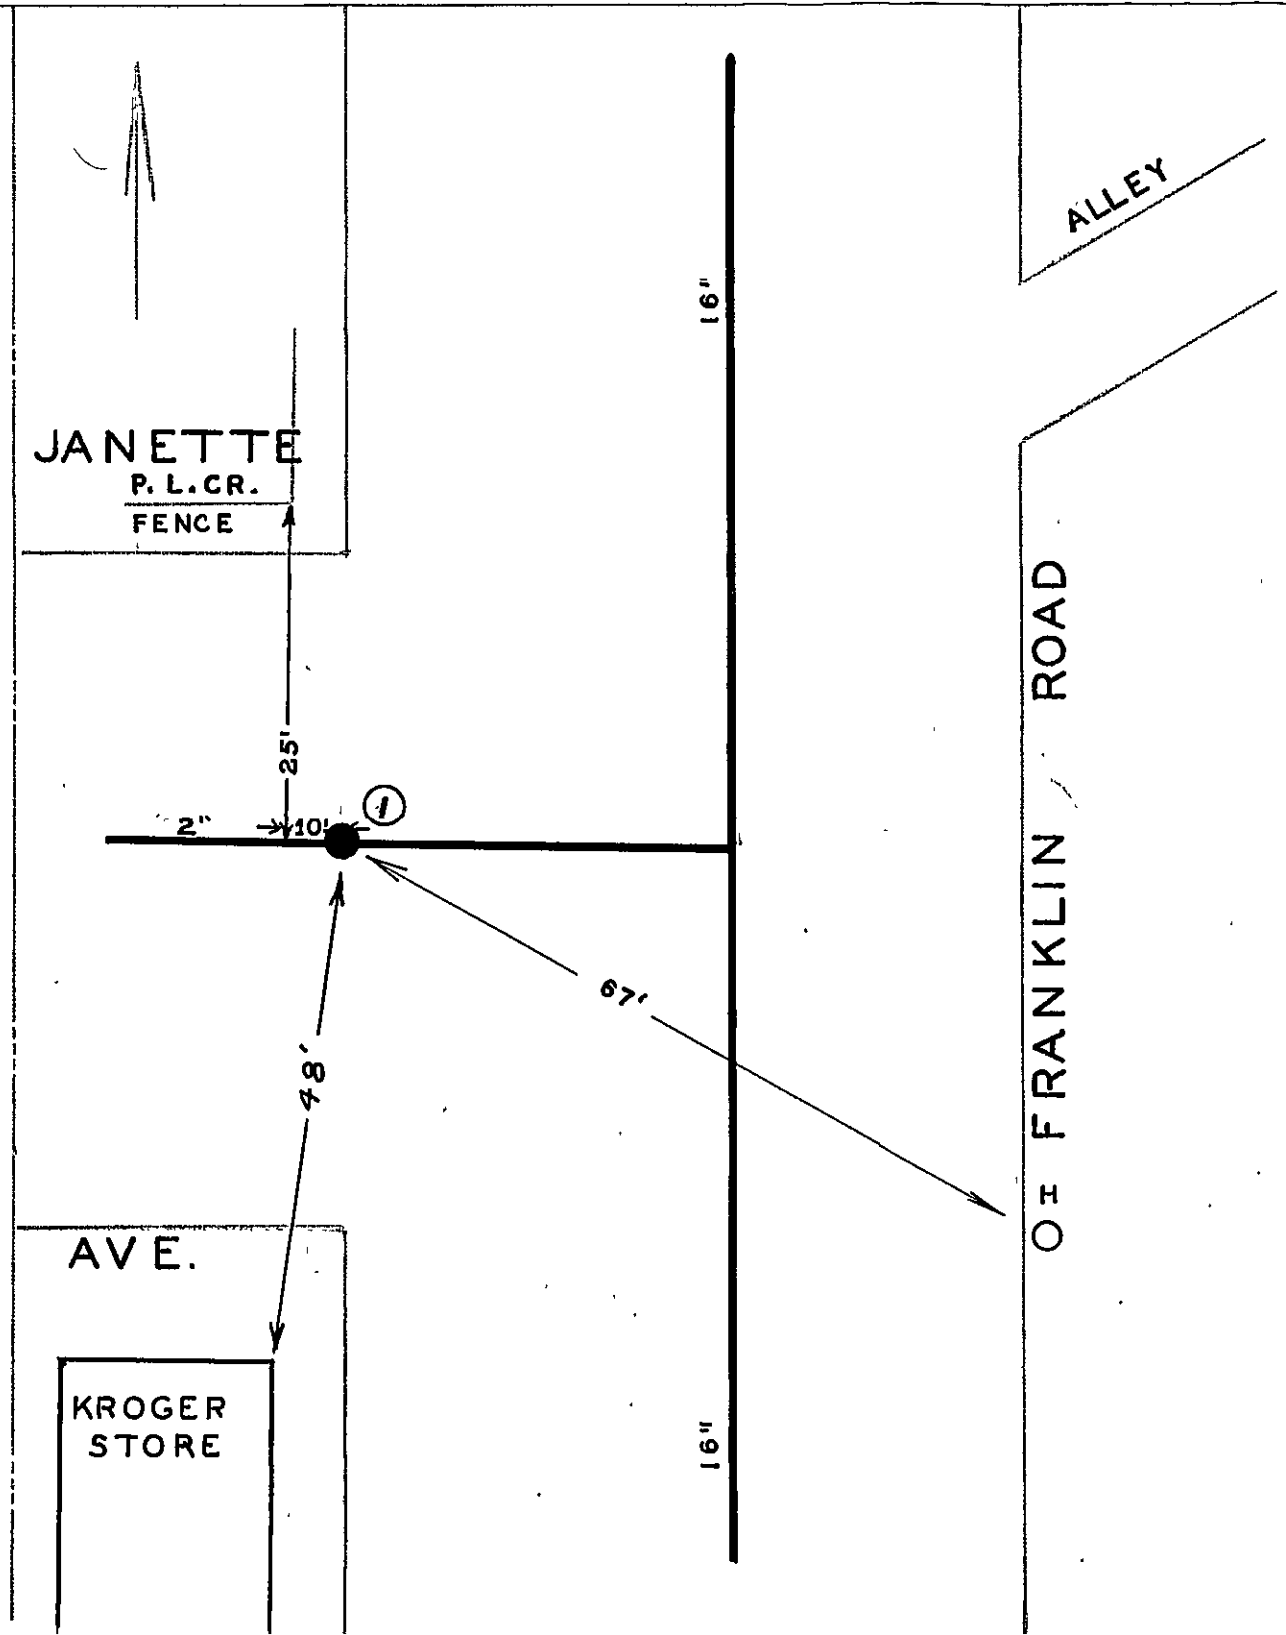

DATE	NO.	SIZE	MAKE	OPEN	TURNS
1923	1	2"		R	7
	1	10"-E	WPL		

CITY OF ROANOKE—WATER DEP'T

VALVE DIAGRAM

FRANKLIN RD. &

JANETTE AVE. S. W.

SEC. MAP 103

DATE PAGE NO S.W. 100