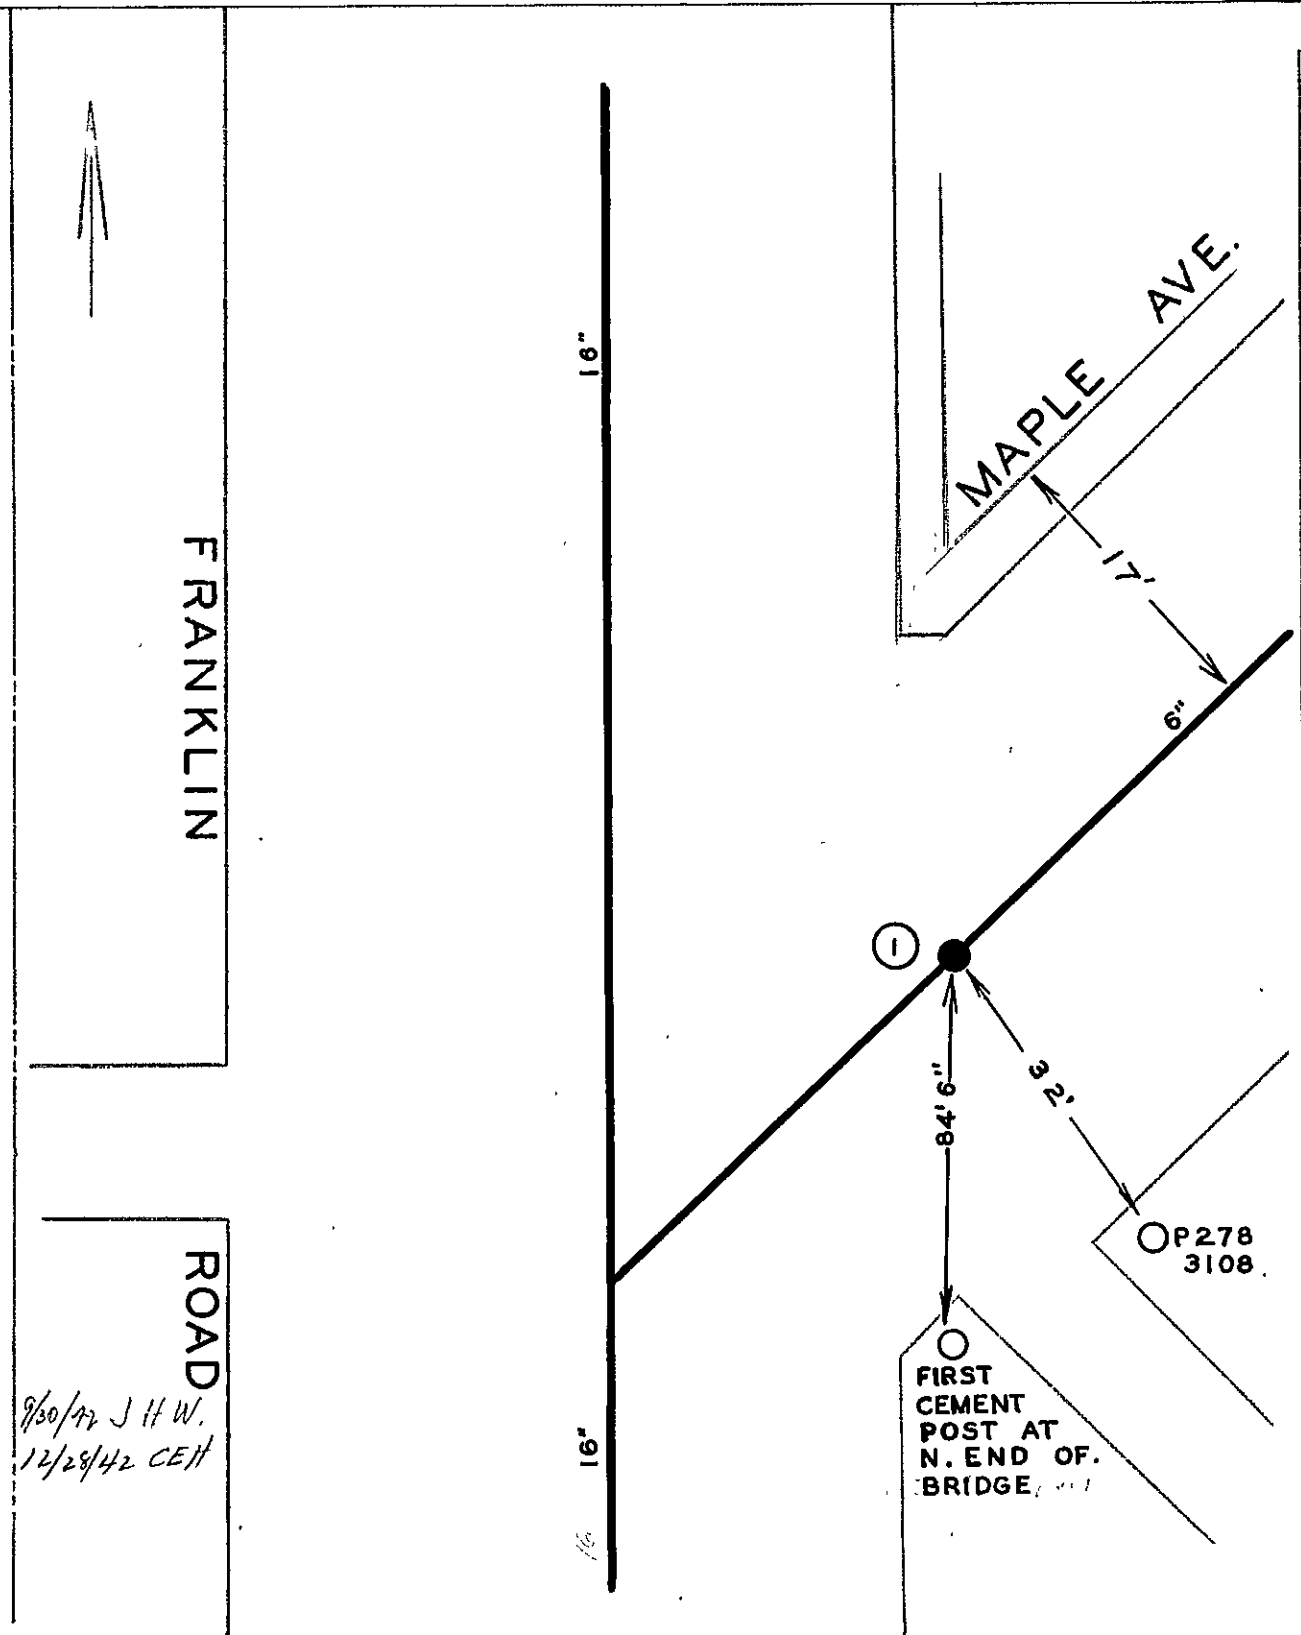

DATE	NO	SIZE	MAKE	OPEN	TURNS
1891	1	6"		R	21
	1	0	EPL		

CITY OF ROANOKE—WATER DEP'T

VALVE DIAGRAM

FRANKLIN ROAD &

MAPLE AVENUE S. W.

SEC. MAP 103

DATE

PAGE NO S.W.105