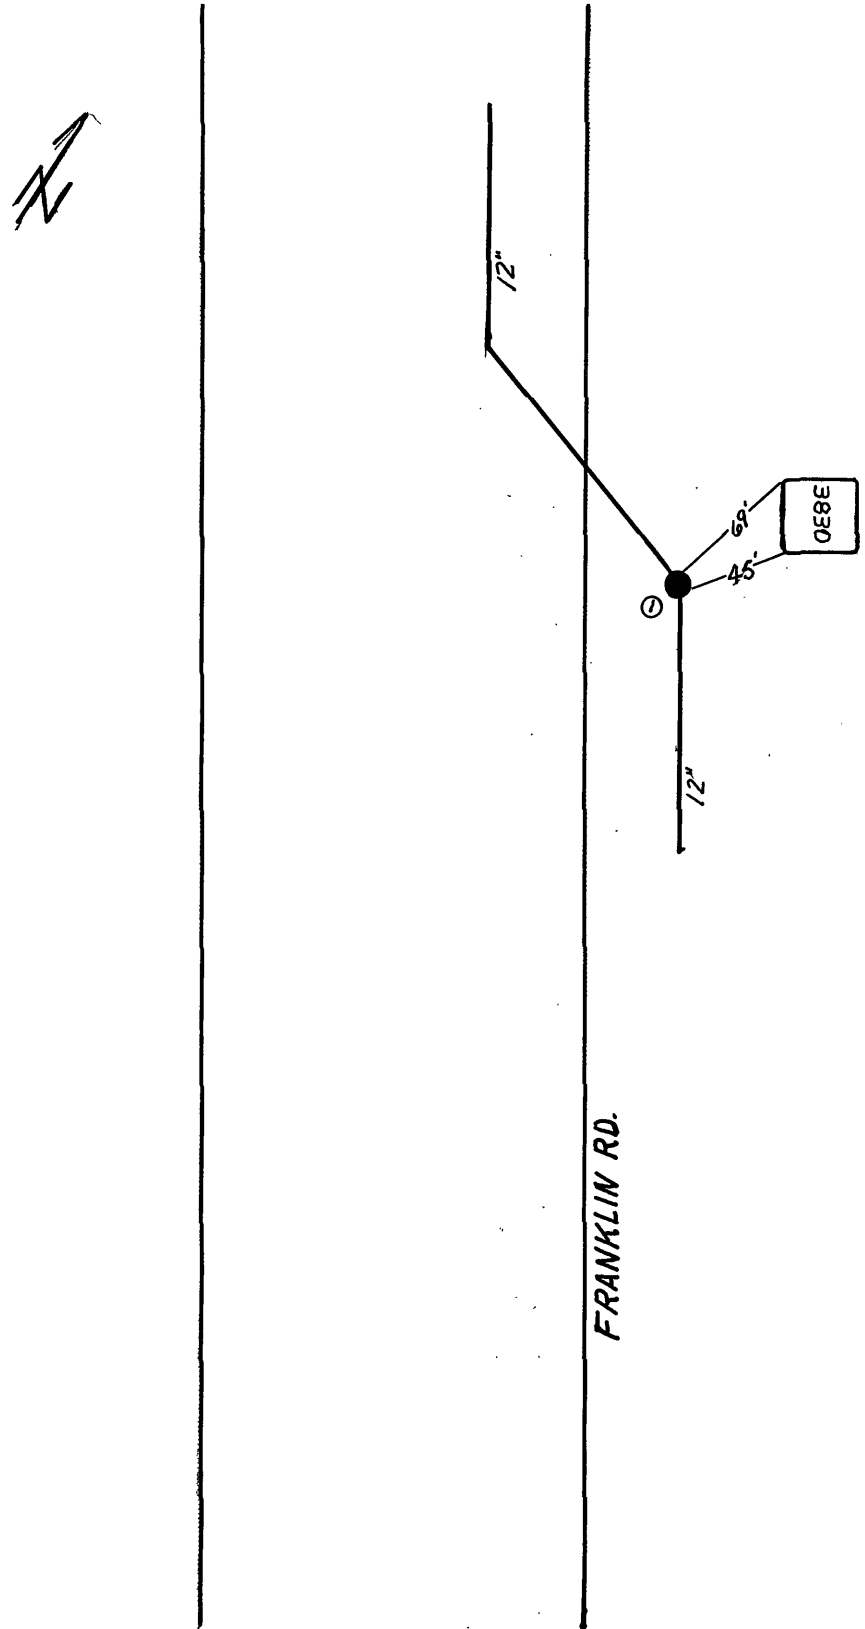

DATE	NO.	SIZE	MAKE	OPEN	TURNS
5-79	1	12"	MUELLER	R	

CITY OF ROANOKE - WATER DEP'T

VALVE DIAGRAM

IN FRONT 3830 FRANKLIN RD.

S.W.

SEC. & P

DATE PAGE NO.