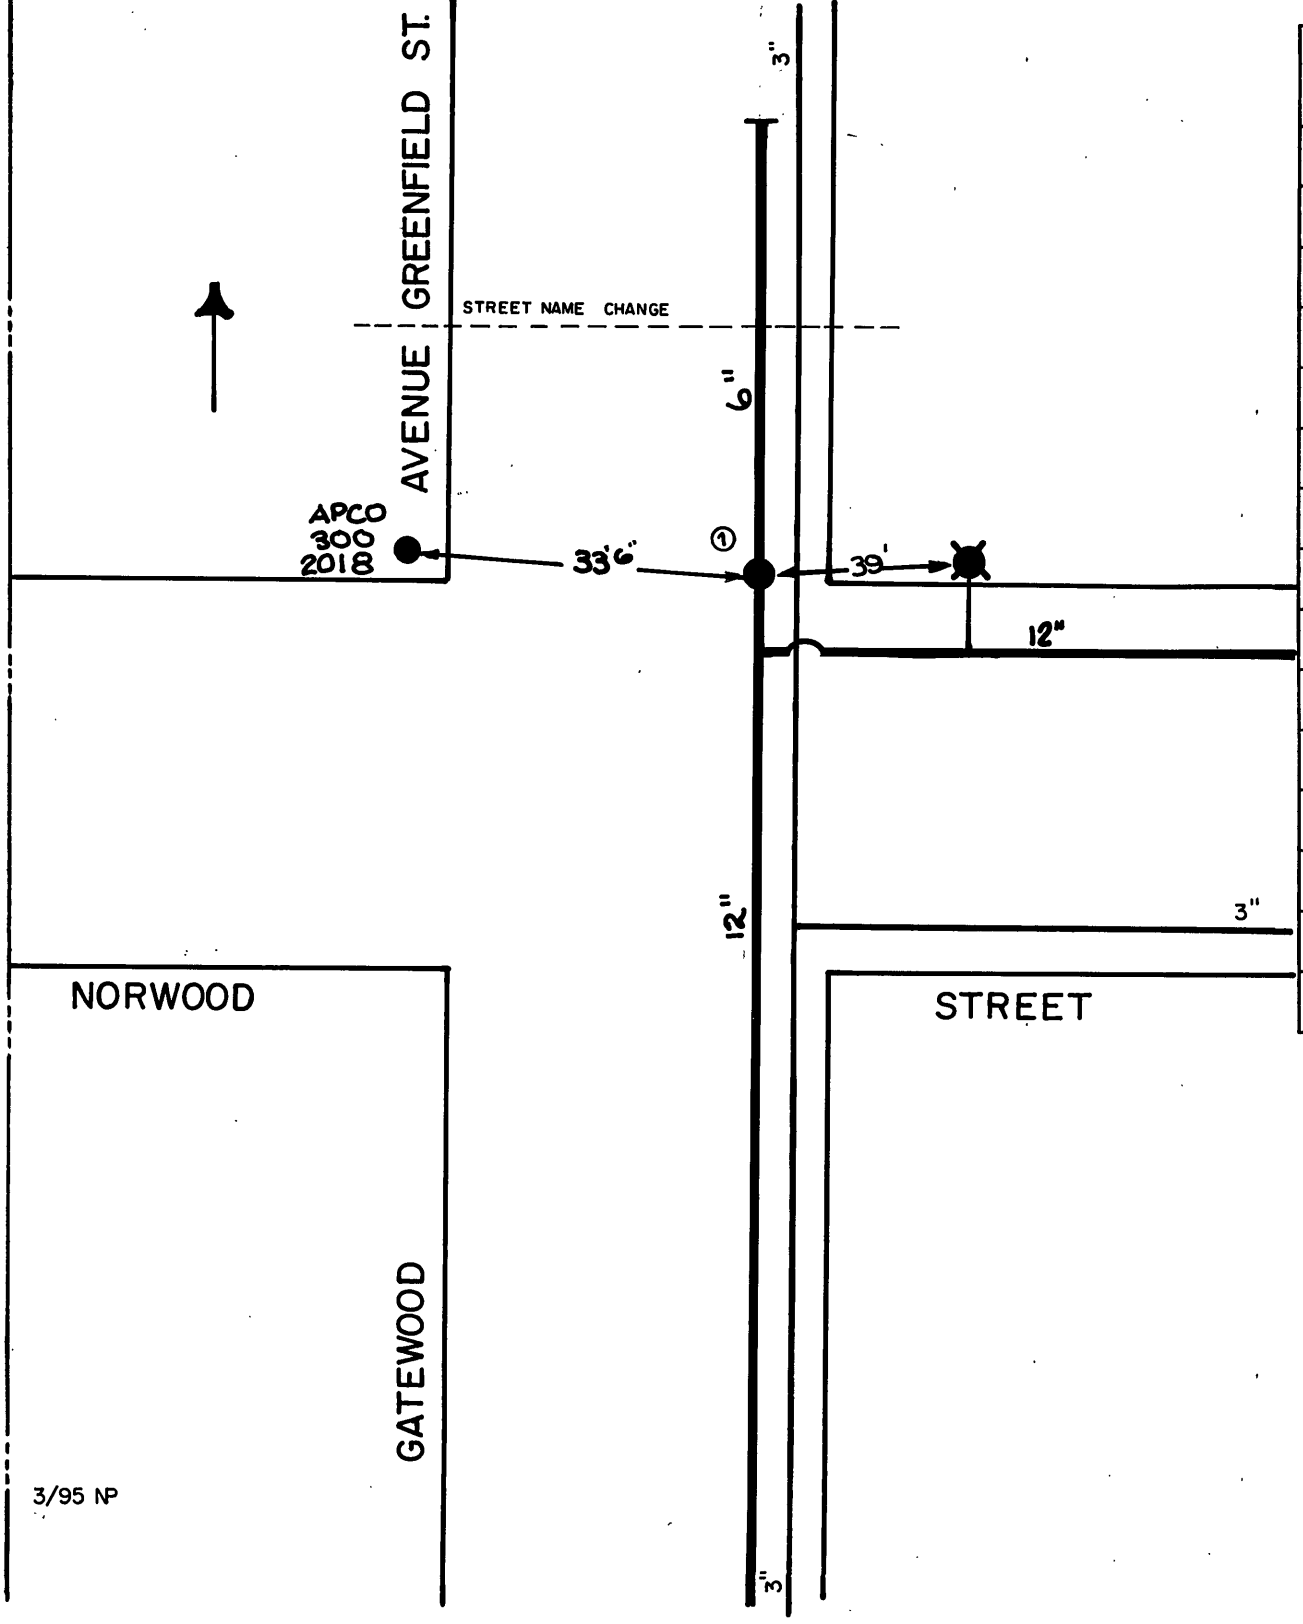

DATE	NO.	SIZE	MAKE	OPEN	TURNS
1979	1	6"	DARLING	R	

CITY OF ROANOKE—WATER DEP'T

VALVE DIAGRAM

GATEWOOD AVENUE

GREENFIELD STREET

NORWOOD STREET

SEC. MAP 510 S.W.

DATE 7/14/80 PAGE NO.

3/95 NP