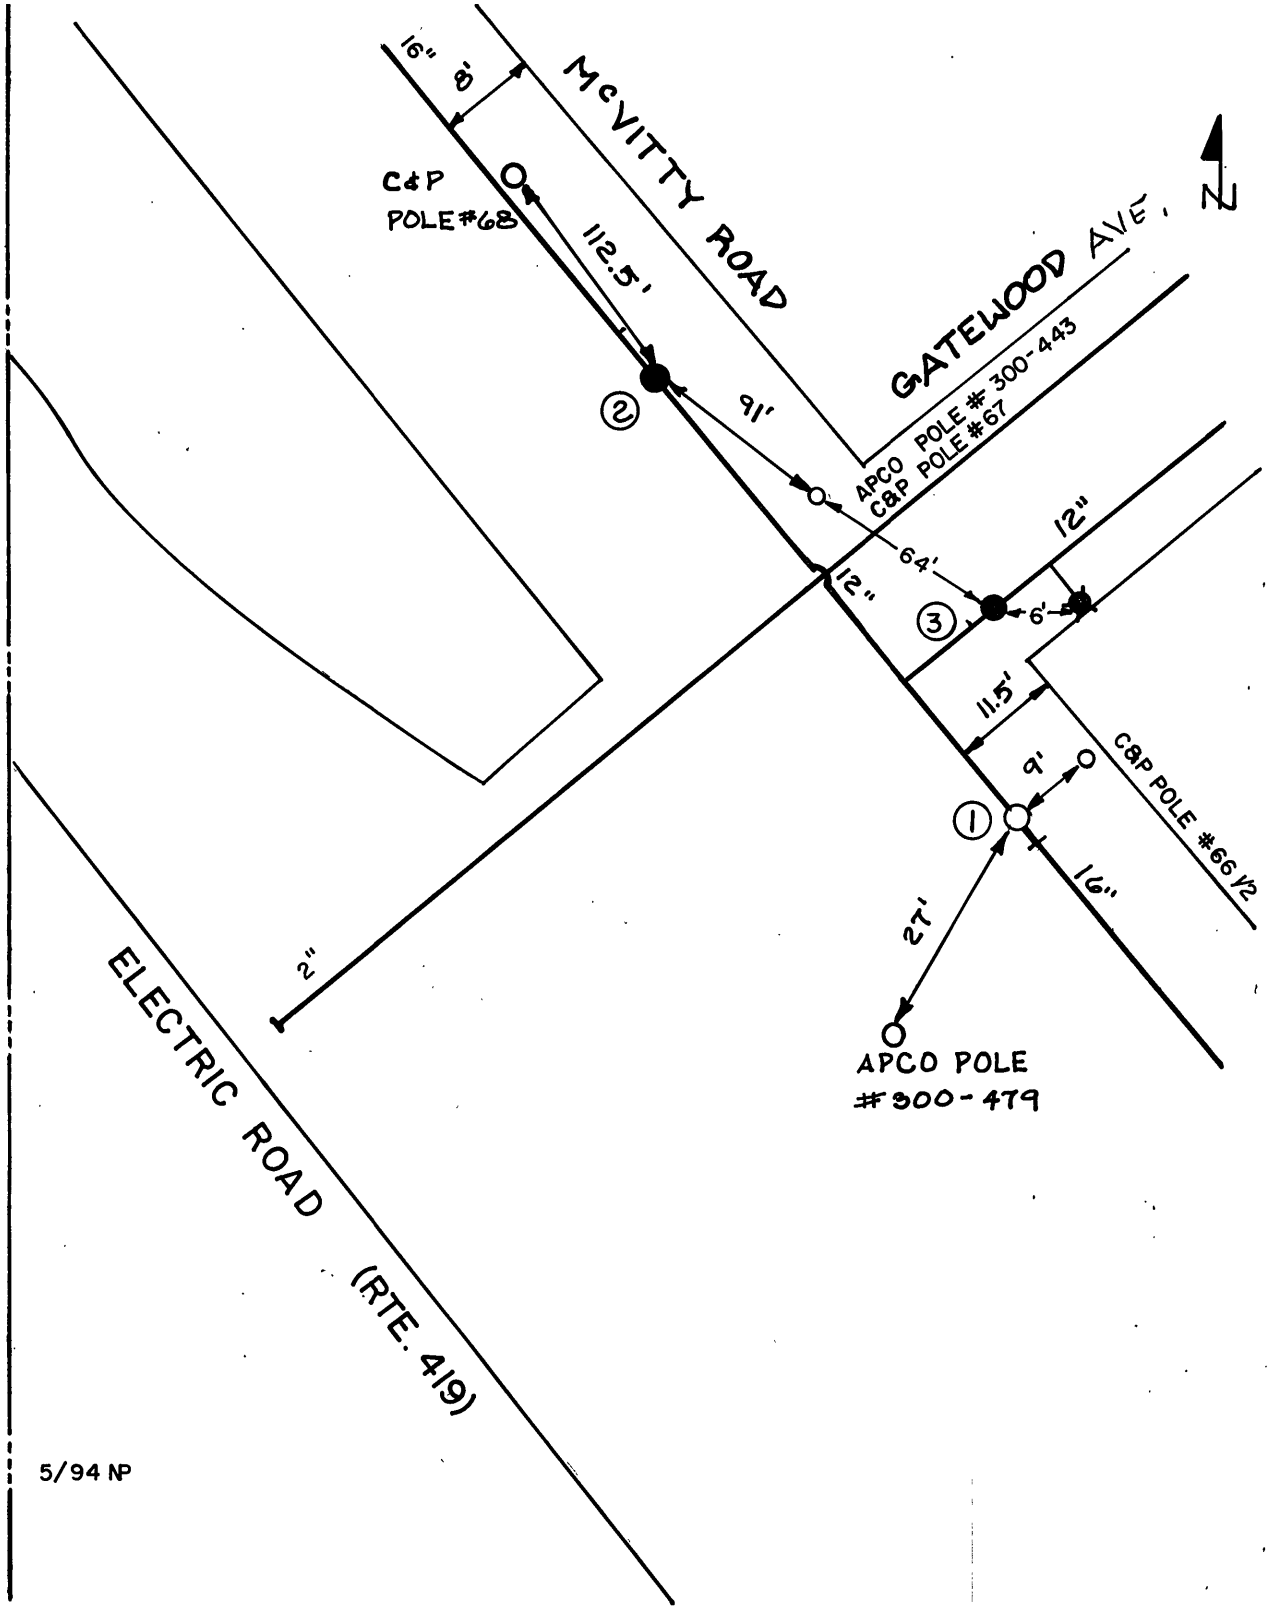

DATE	NO.	SIZE	MAKE	OPEN	TURNS
11-80	1	12"	MUELLER	R	
11-80	2	12"	MUELLER	R	
7-80	3	12"	DARLING	R	
#1	20'	S	S.P.L.		
#2	88'	N	N.P.L.		

CITY OF ROANOKE—WATER DEP'T

VALVE DIAGRAM

ELECTRIC RD. (RTE. 419)

GATEWOOD

McVITTY RD.

SEC. MAP 510 S.W.

DATE PAGE NO.

5/94 NP