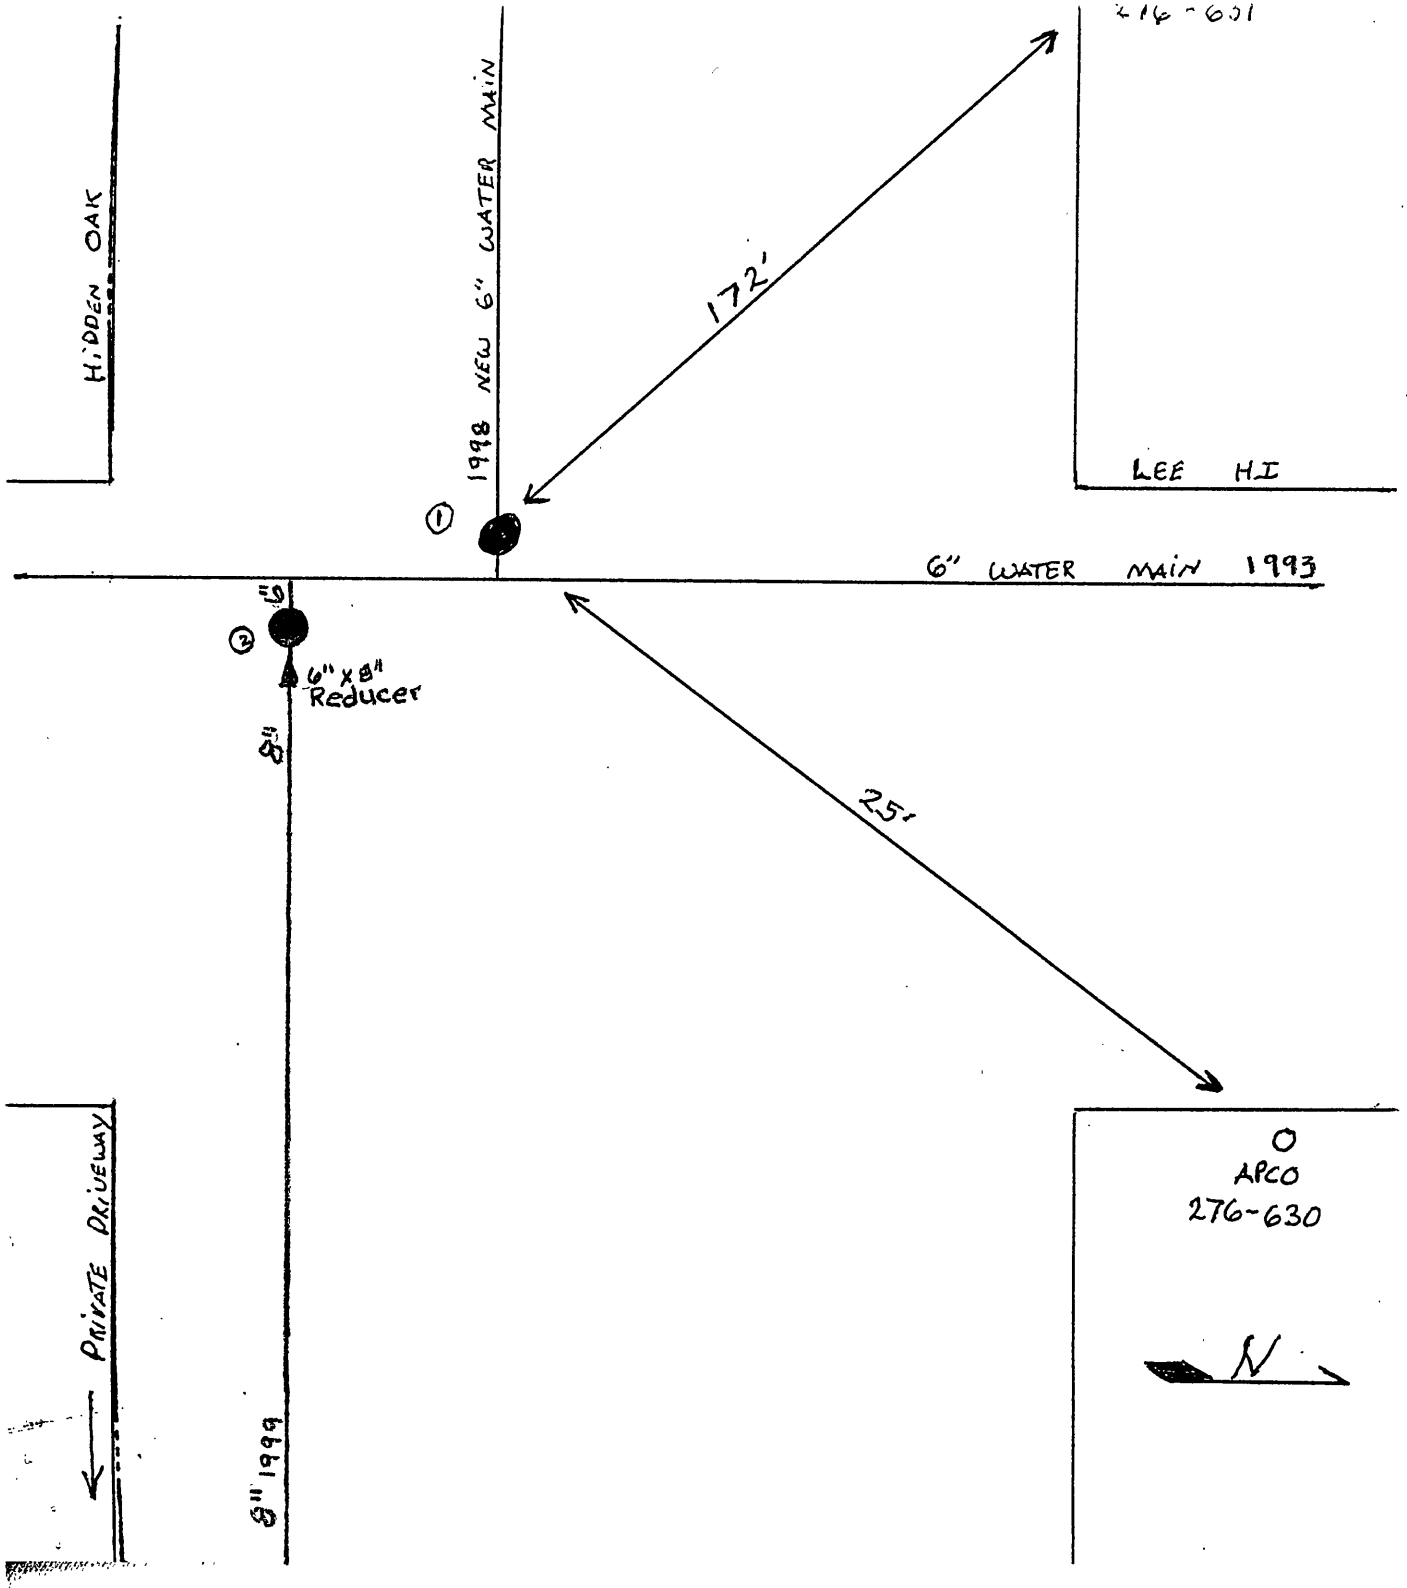

DATE	NO.	SIZE	MAKE	OPEN	TURNS
6/98	1	6"	Darling	R	21
1999	2	6"		R	21

CITY OF ROANOKE—WATER DEP'T

VALVE DIAGRAM

~~LEE HI~~ + HIDDEN OAK SW

Lee Hi

SEC. MAP 505

DATE 6-15-98 PAGE NO.