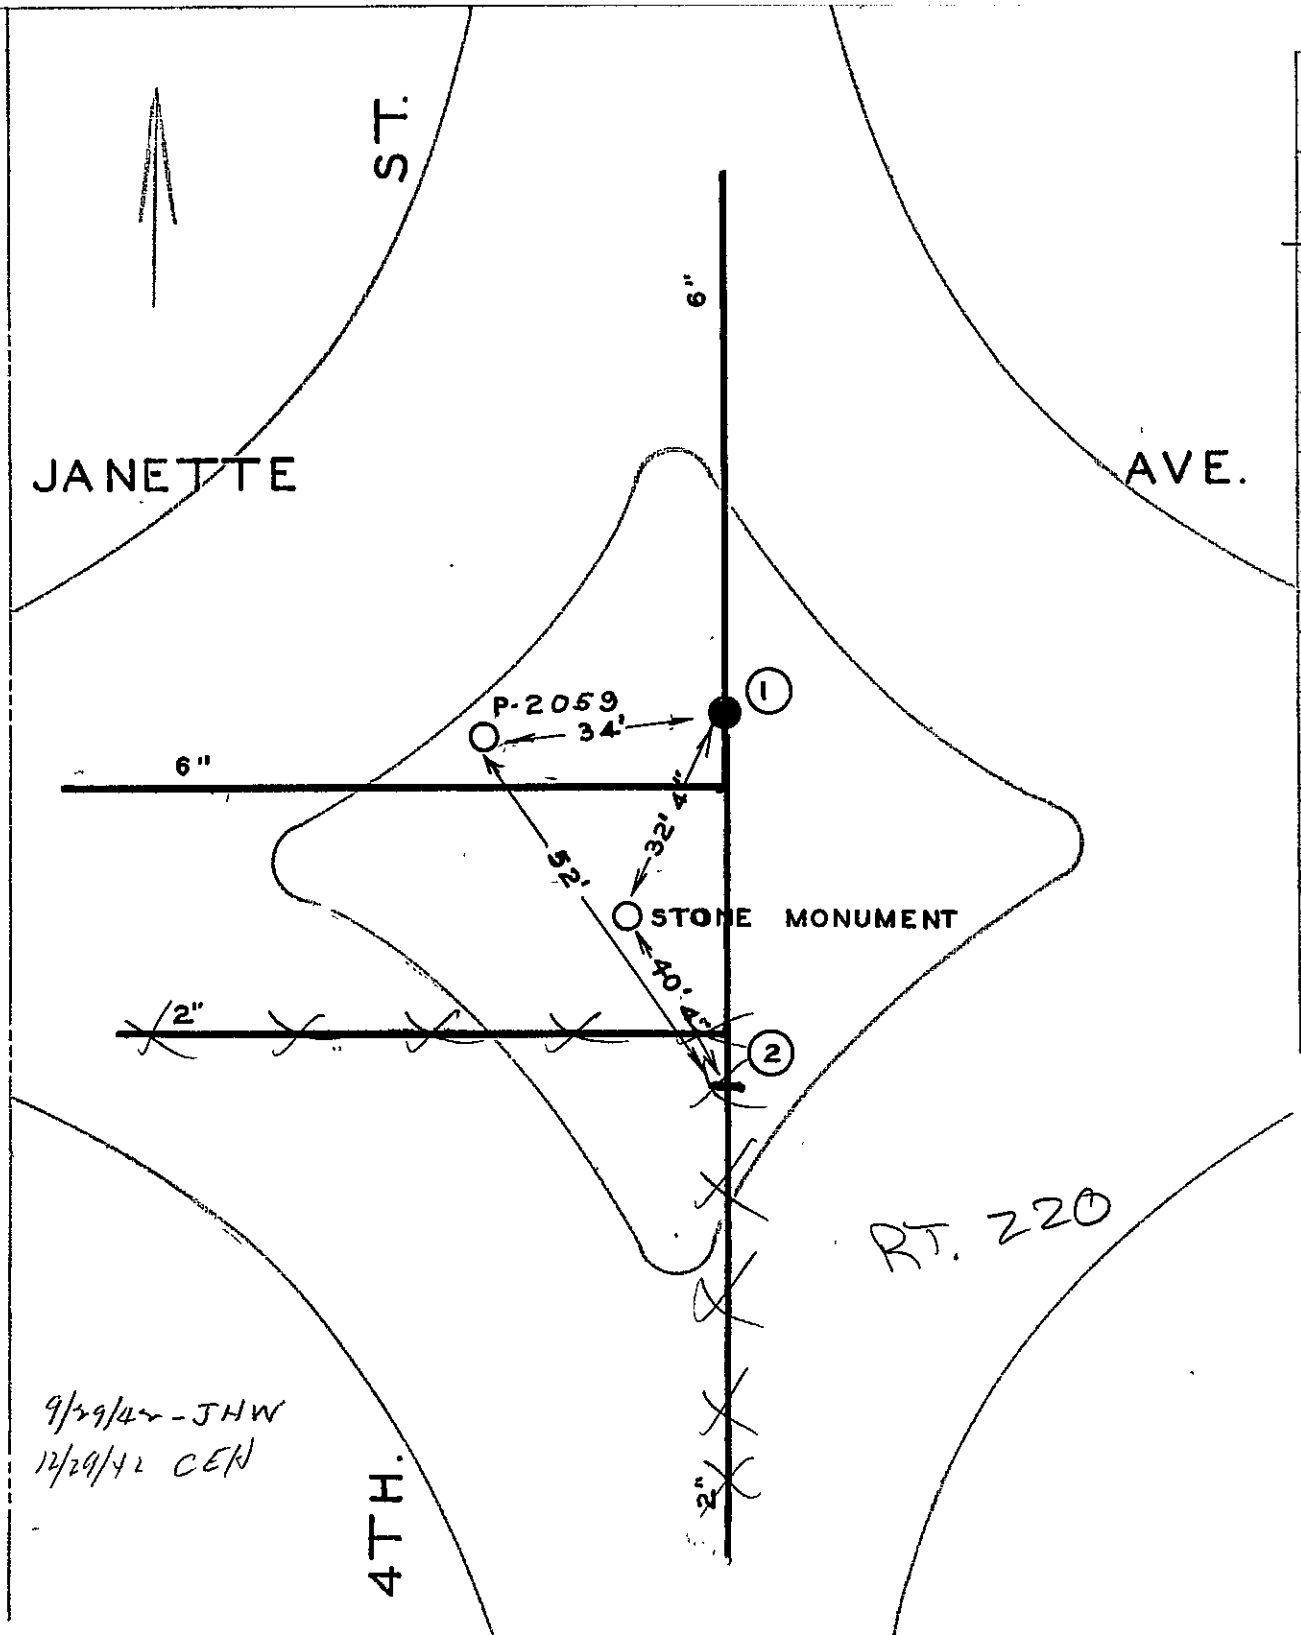

DATE	NO.	SIZE	MAKE	OPEN	TURNS
1892	1	6"		R	20
~~1935~~	~~2~~	~~1/2"~~	~~CURB COCK~~		

CITY OF ROANOKE—WATER DEP'T

VALVE DIAGRAM

JANETTE AVE. & 4TH. ST. S. W.

SEC. MAP 103

DATE

PAGE NO S.W.101