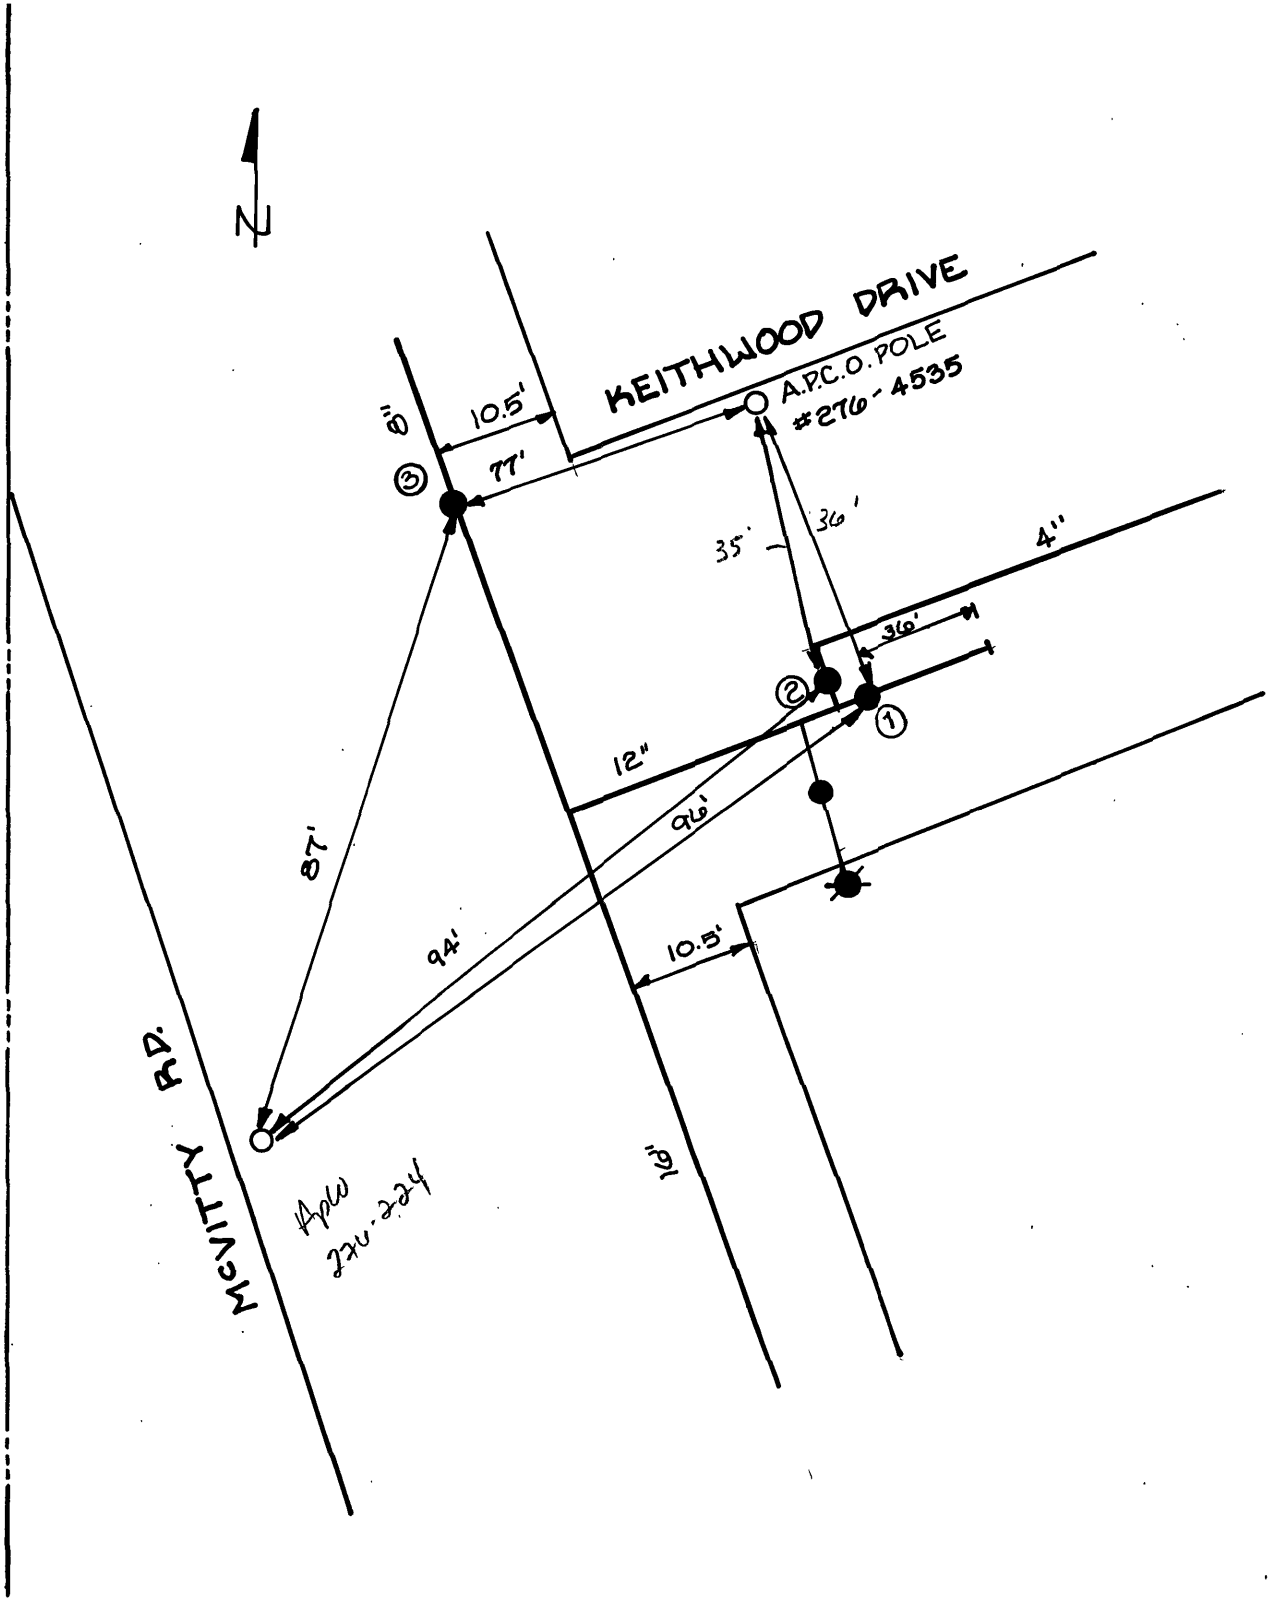

DATE	NO.	SIZE	MAKE	OPEN	TURNS
11-80	1	12"	MUELLER	R	
11-80	2	4"	MUELLER	R	
11-80	3	8"	MUELLER	R	
1	48'	E of	E.P.L.		
2	46'	E of	E.P.L.		
3	6'	N of	N.P.L.		

CITY OF ROANOKE—WATER DEP'T

VALVE DIAGRAM

KEITHWOOD DR. &

McVITTY RD.

S.W.

SEC. MAP 510

DATE 11-21-80 PAGE NO.