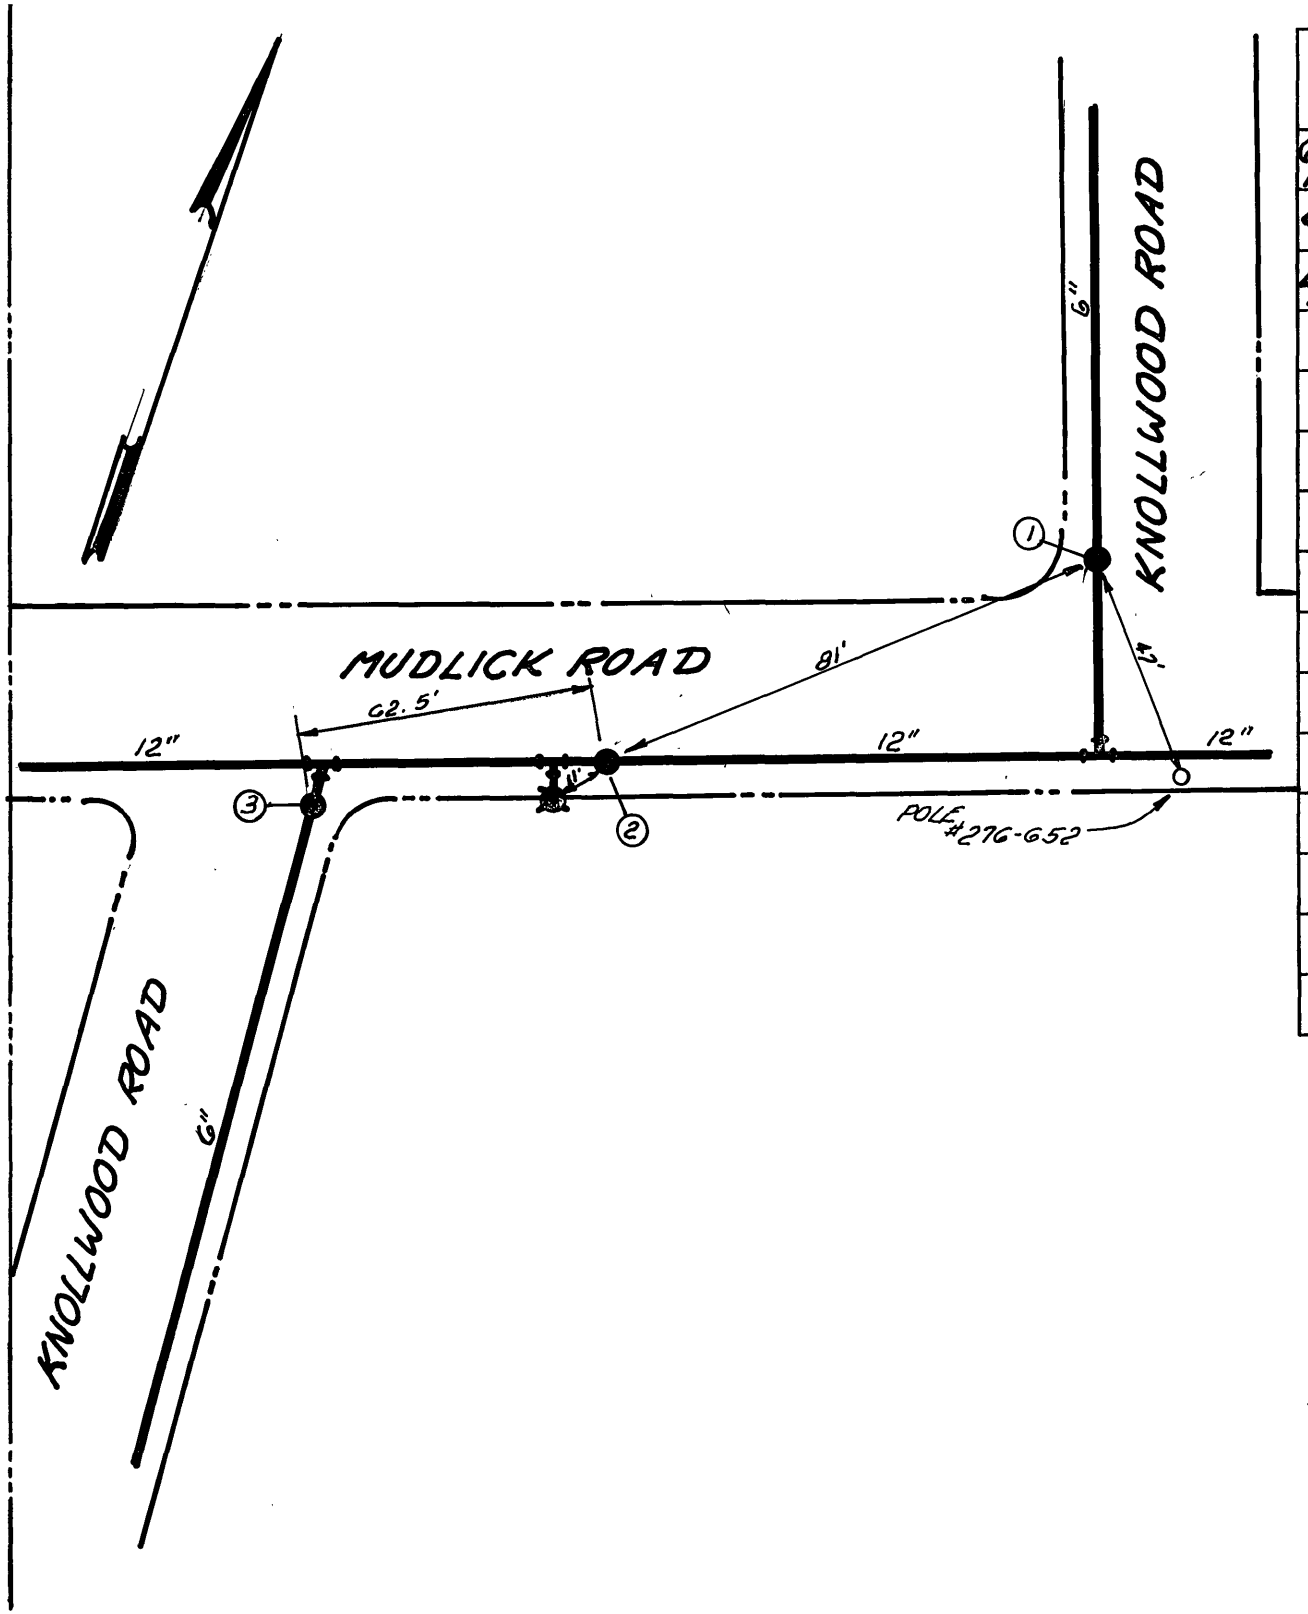

DATE	NO.	SIZE	MAKE	OPEN	TURNS
6/82	1	6"	MUL.	R	21
4/82	2	12"	MUL.	R	39
4/82	3	6"	KENEDY	R	21

CITY OF ROANOKE—WATER DEP'T

VALVE DIAGRAM

KNOLLWOOD ROAD

& MUDLICK ROAD

S.W.

SEC. MAP 505

DATE 6-24-85 PAGE NO. 1