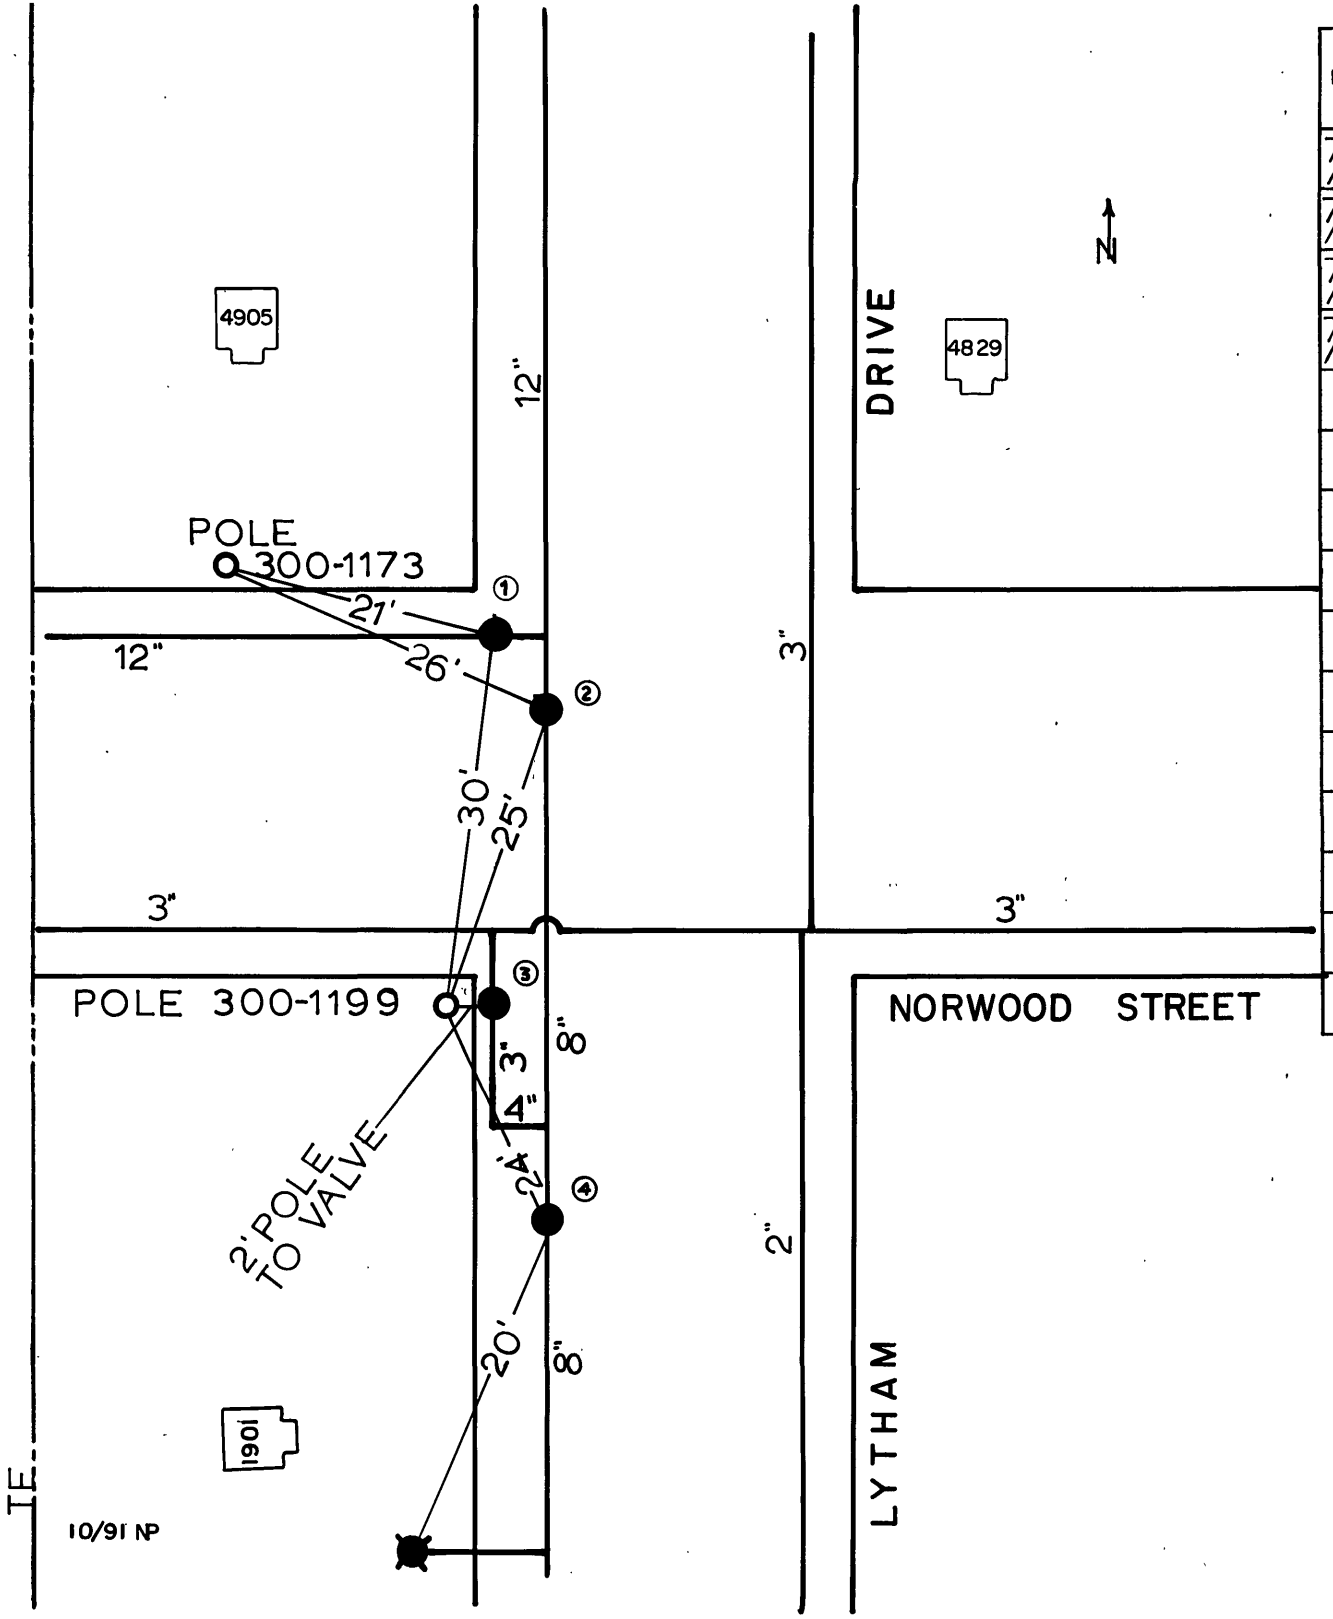

DATE	NO.	SIZE	MAKE	OPEN	TURNS
7/80	1	12"	MUL.	R	39
7/80	2	8"	MUL.	R	27
7/80	3	3"	MISC.	L	12
7/80	4	8"	MUL.	R	27

CITY OF ROANOKE—WATER DEP'T

VALVE DIAGRAM

LYTHAM DRIVE (1900 BLK)

NORWOOD STREET(4900 BLK)

SEC. MAP 510 S.W.

DATE 4/81 PAGE NO.