MC. CLANAHAN ~~PLACE~~ STREET

DATE	NO.	SIZE	MAKE	OPEN.	TURNS
1922	1	2"		R	7 1/2
1996	2	6"	MUELLER	R	21
	1	18"-N	SPL		

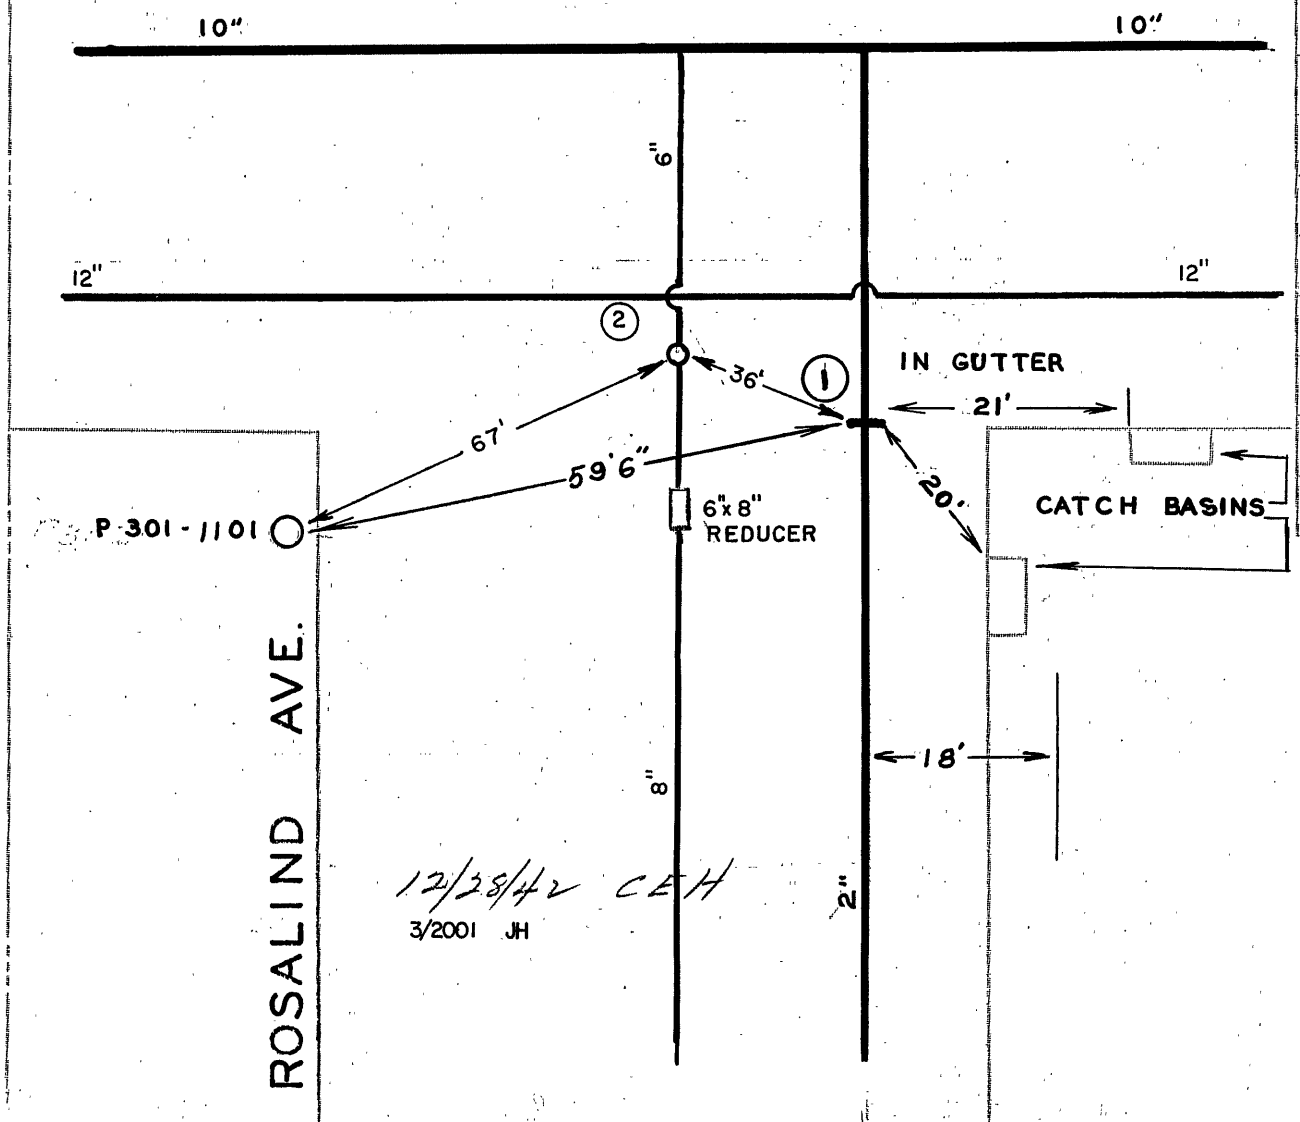

CITY OF ROANOKE—WATER DEP'T

VALVE DIAGRAM

MC. CLANAHAN ~~PLACE~~ STREET &

ROSALIND AVE.

SOUTHERN INTERSECTION

SEC. MAP 105 S.W.

DATE PAGE NO. S.W.244