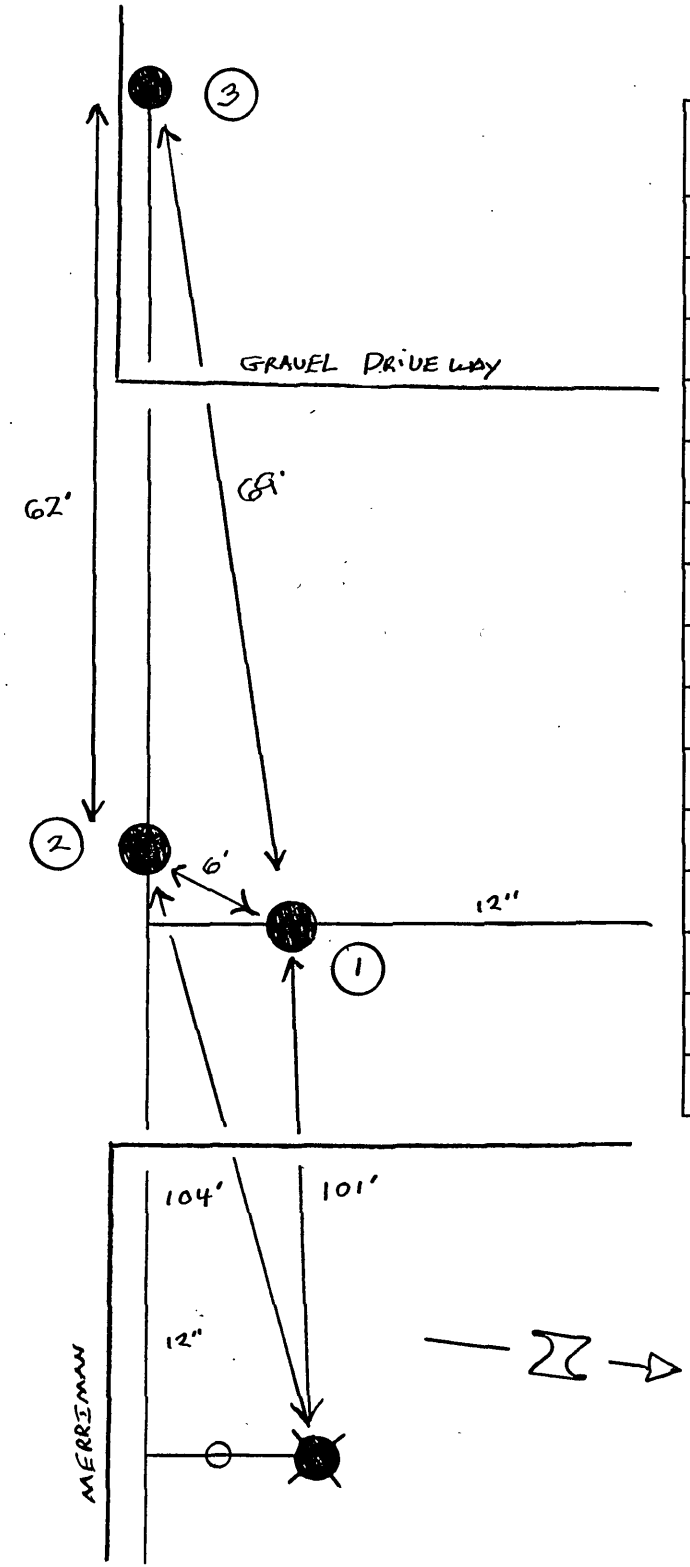

DATE	NO.	SIZE	MAKE	OPEN	TURNS
6/05	1	12"	DARLING	L	39
6/05	2	12"	DARLING	L	39
6/05	3	2"	DARLING	L	9

WESTERN VIRGINIA WATER AUTHORITY

VALVE DIAGRAM

6800 BLK MERRIMAN ROAD 700' WEST OF BRIDGE CROSSING OF BACK CREEK

SECT. MAP SW Co.

DATE 11-17-06