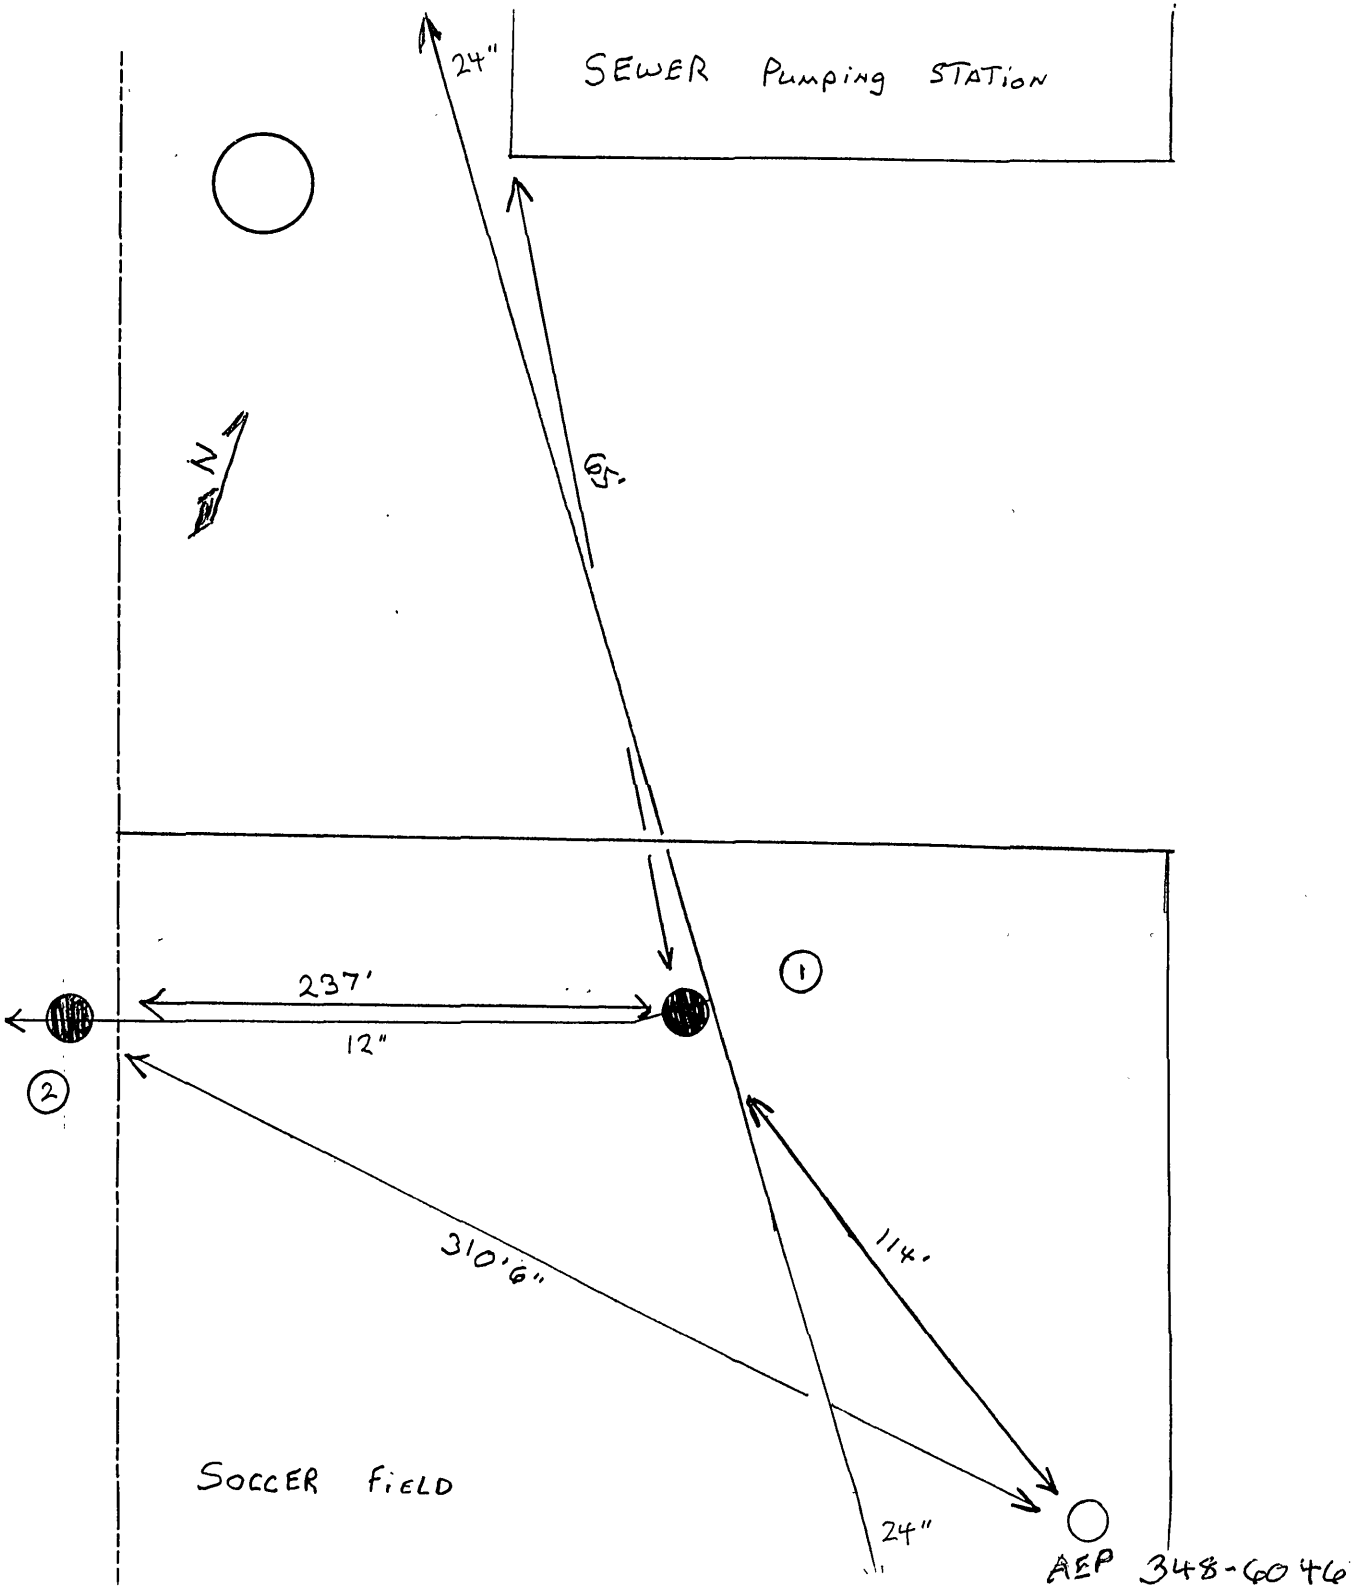

DATE	NO.	SIZE	MAKE	OPEN	TURNS
6/05	1	12	AUK	L	39
6/05	2		IN LINE BLOWOFF		

WESTERN VIRGINIA WATER AUTHORITY

VALVE DIAGRAM

MERRIMAN SOCCER COMPLEX

MERRIMAN ROAD

SECT. MAP SW CNTY SW CO.