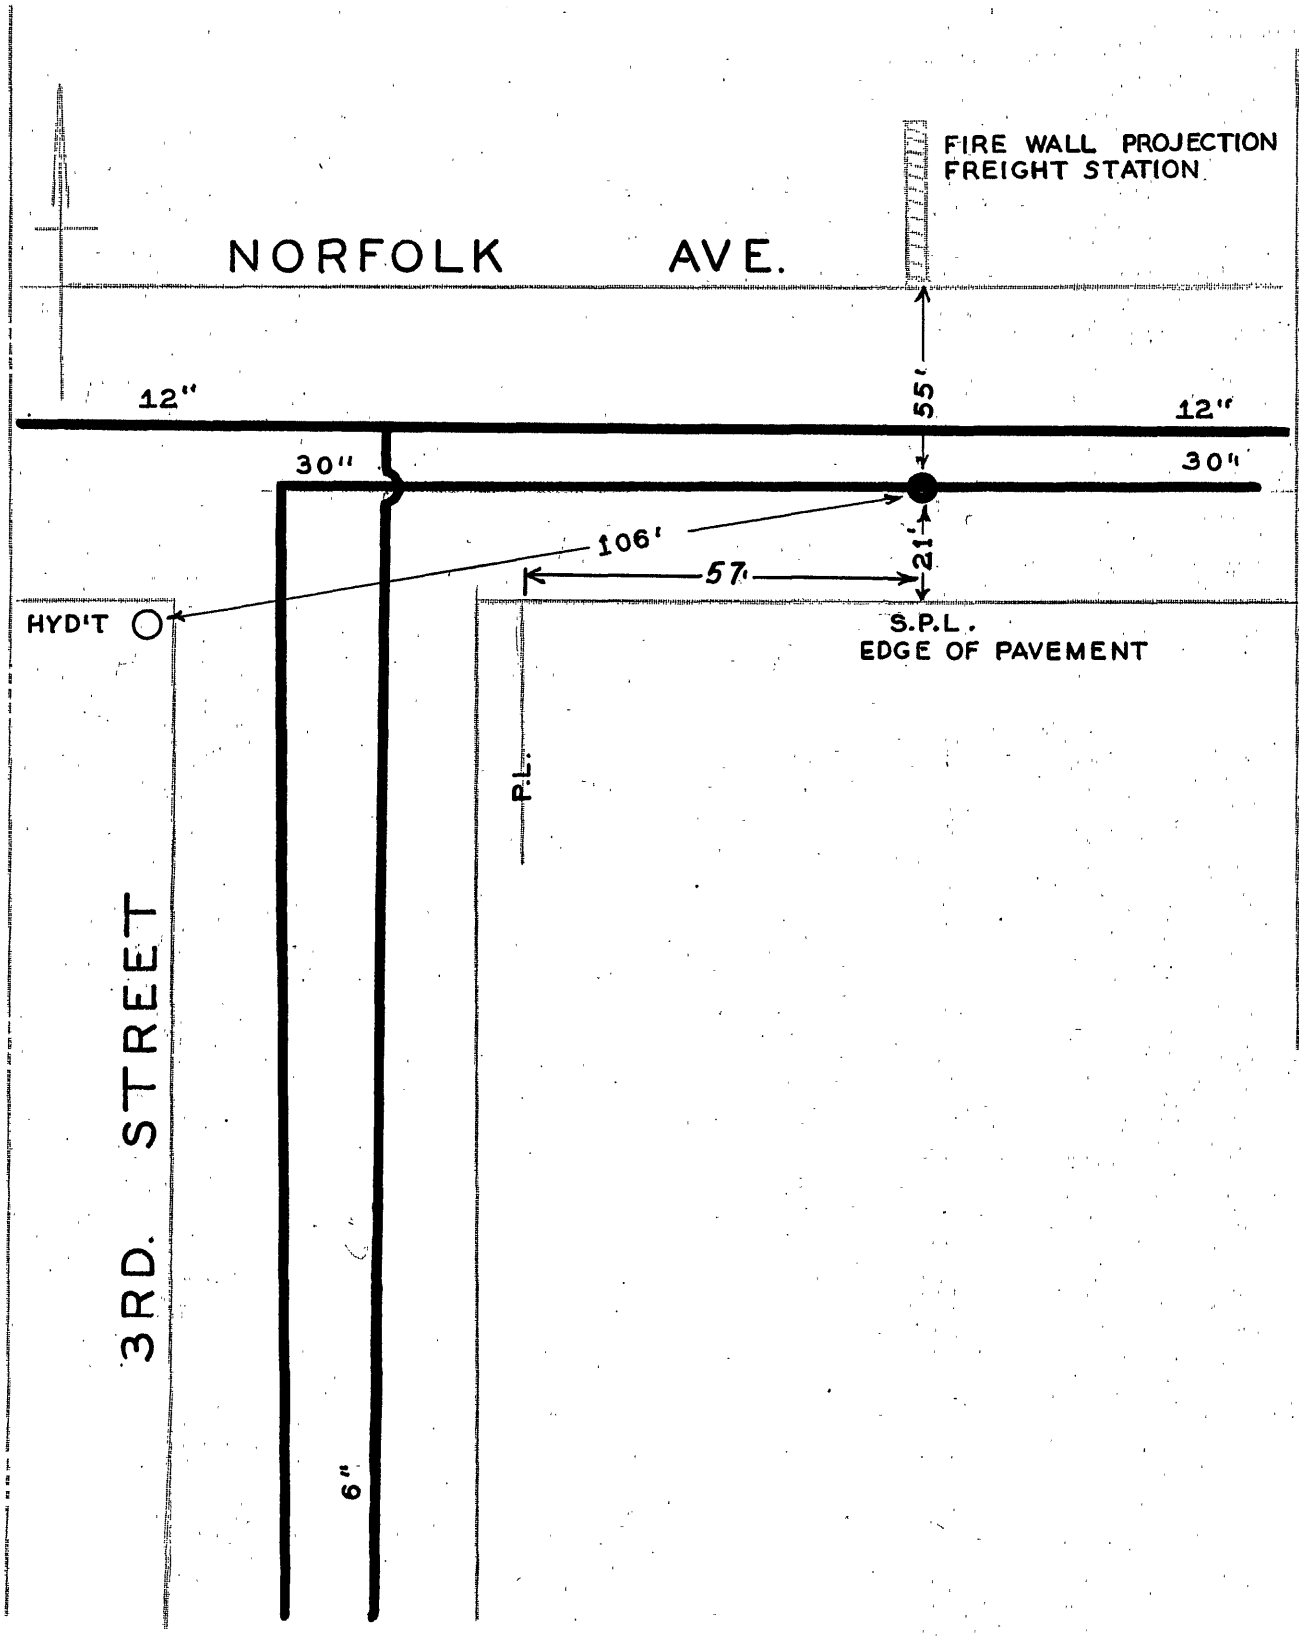

DATE	NO.	SIZE	MAKE	OPEN	TURNS
1946	1	1"	SIMPLEX	AIR	VALVE

CITY OF ROANOKE—WATER DEPT

VALVE DIAGRAM

NORFOLK AVENUE EAST

OF 3RD. STREET S.W.

SEC. MAP 101

DATE

PAGE NO S.W.5-A