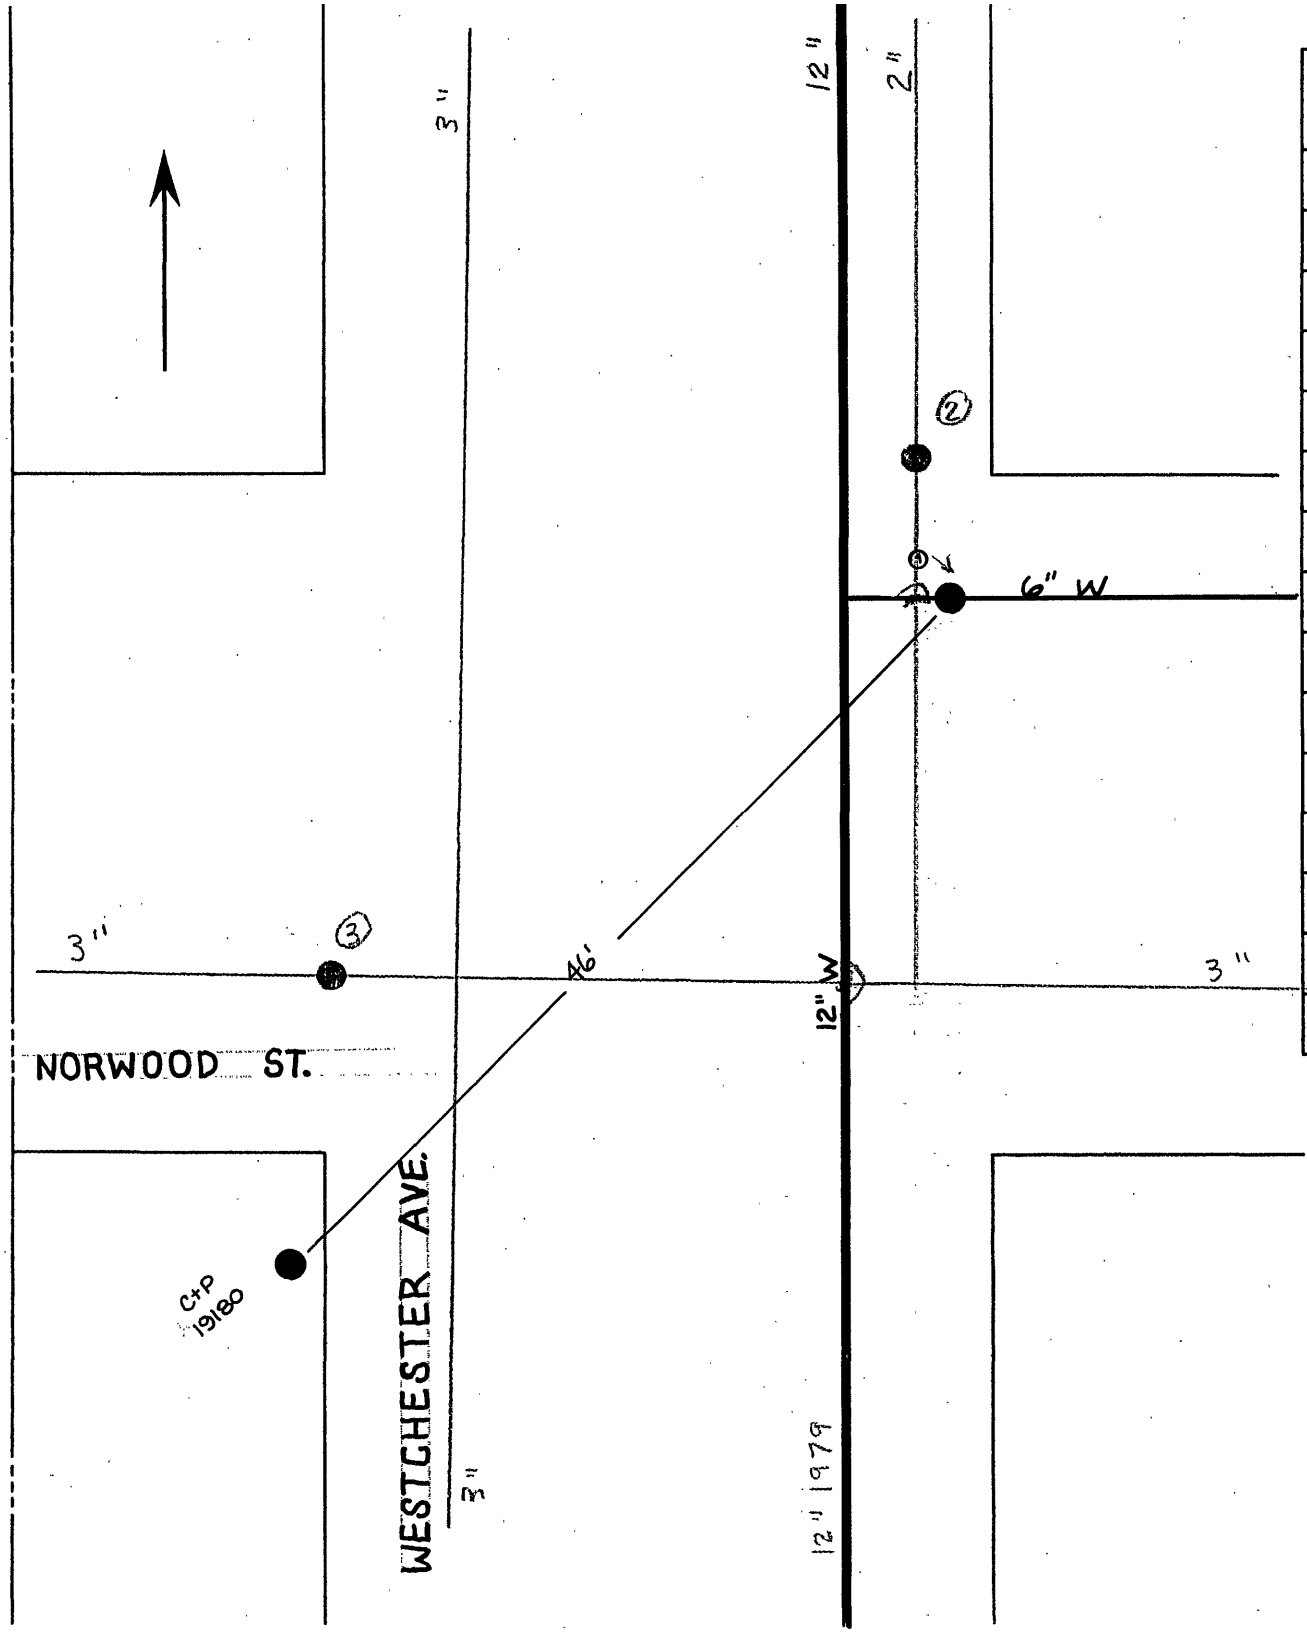

DATE	NO.	SIZE	MAKE	OPEN	TURNS
1979	1	6"			
	2				
	3				

CITY OF ROANOKE—WATER DEP'T

VALVE DIAGRAM

NORWOOD ST. AND

WESTCHESTER AVE. SW.

SEC. MAP 506

DATE 7/14/80 PAGE NO.