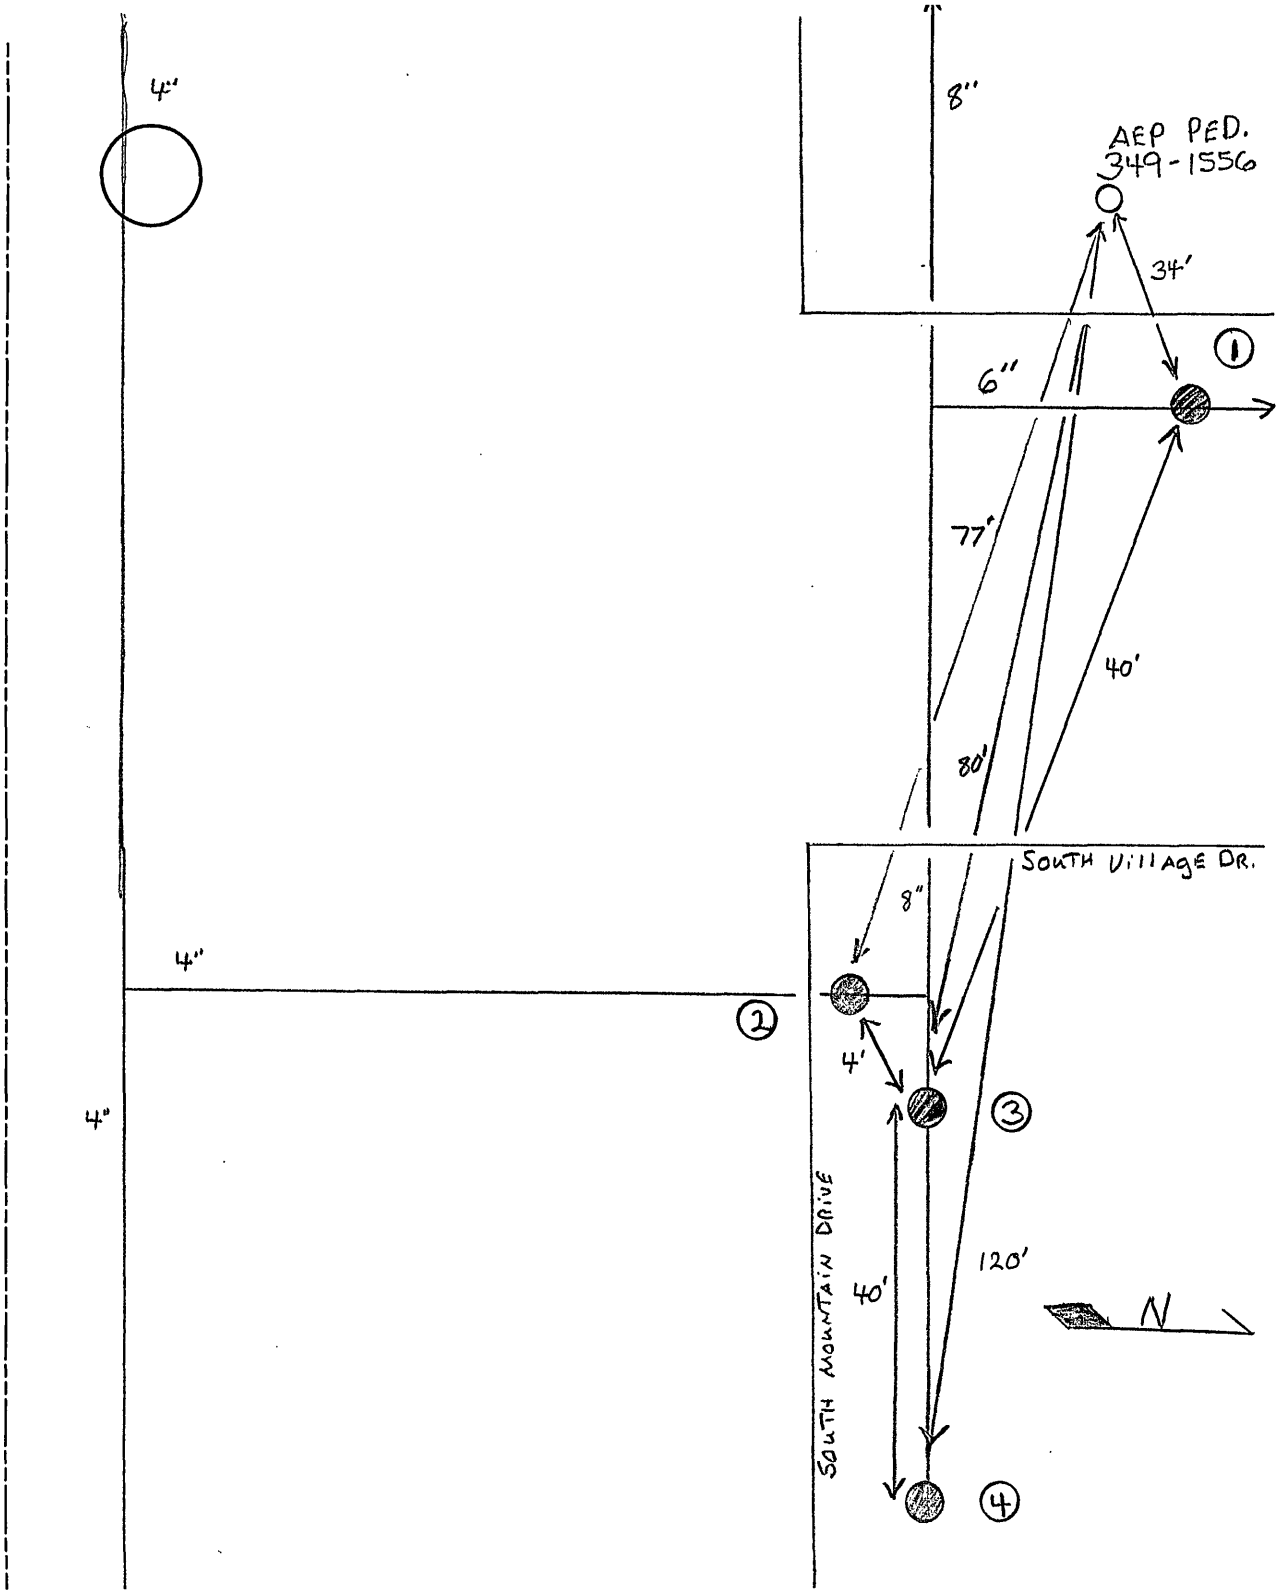

DATE	NO.	SIZE	MAKE	OPEN	TURNS
2004	1	6"	AMERICAN	L	21
2004	2	4"	AMERICAN	L	15
2004	3	8"	AMERICAN	L	27
2004	4	8"	BLOWOFF		

WESTERN VIRGINIA WATER AUTHORITY

VALVE DIAGRAM

SOUTH MOUNTAIN DRIVE AND
SOUTH VILLAGE DRIVE

SECT. MAP SW COUNTY

DATE 8-20-04