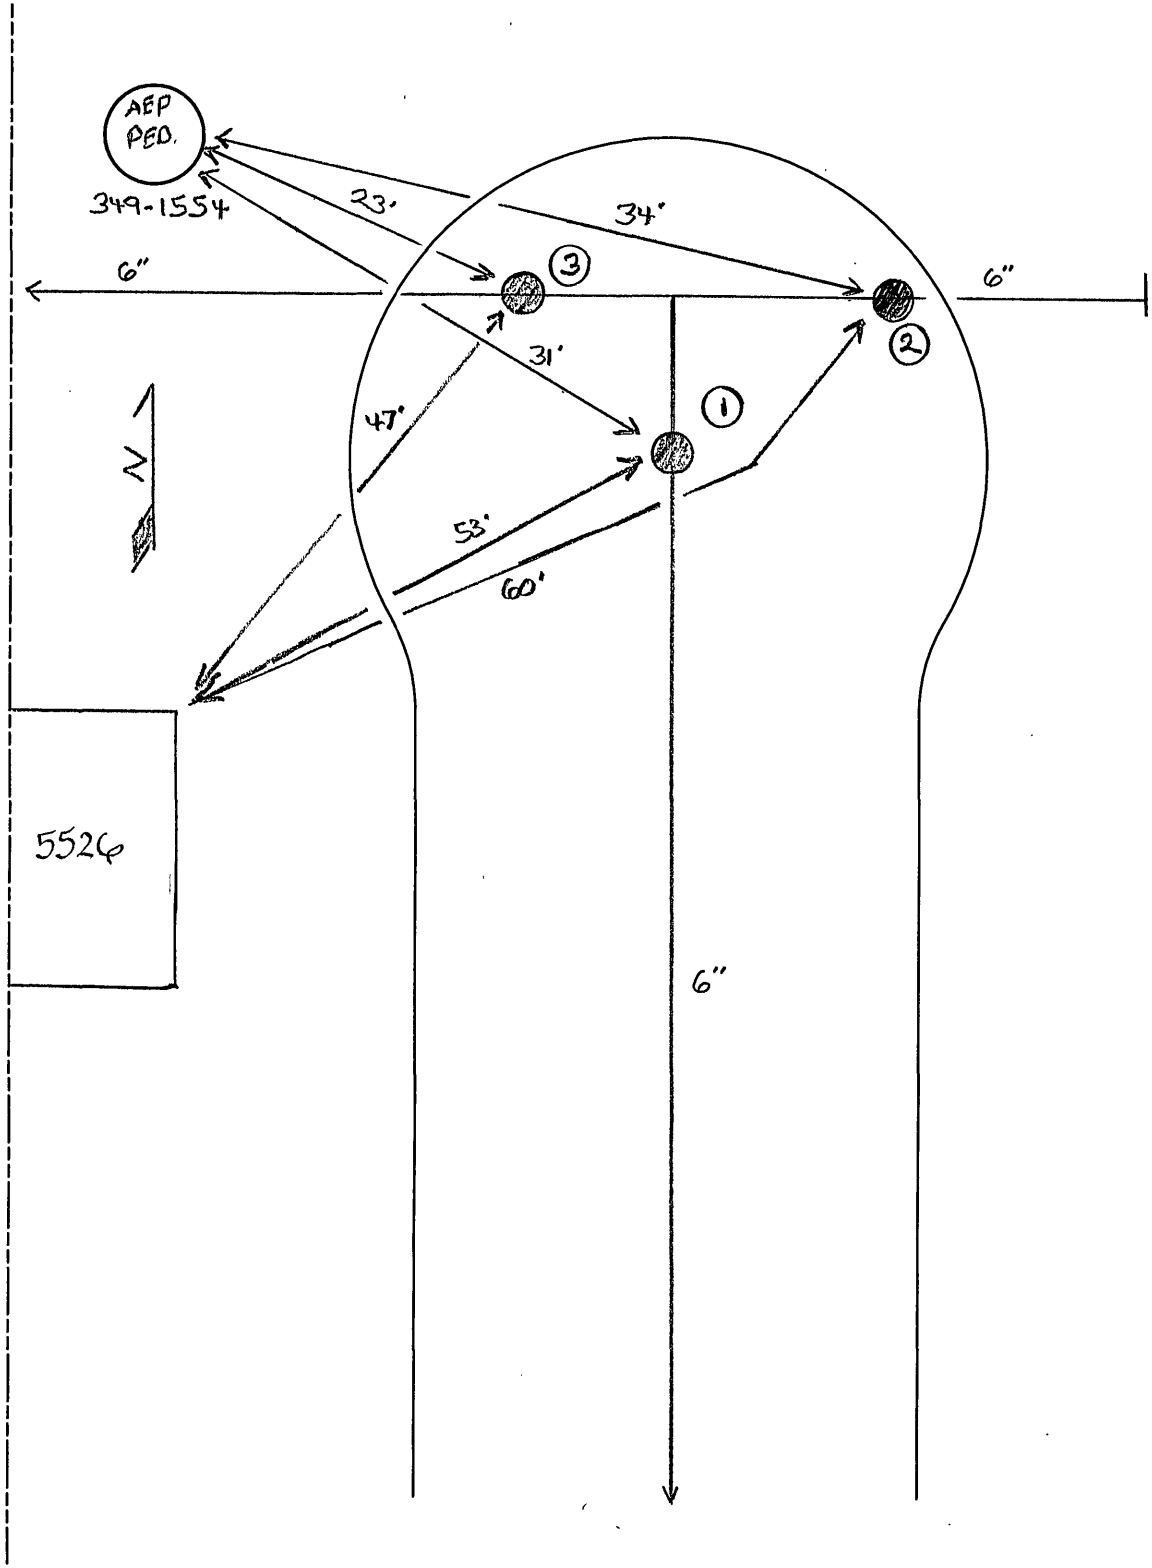


| DATE | NO. | SIZE | MAKE | OPEN | TURNS |
|---|---|---|---|---|---|
| 2004 | 1 | 6" | AMERICAN | L | 21 |
| 2004 | 2 | 8" | AMERICAN | L | 27 |
| 2004 | 3 | | AIR RELEASE | | |
| | | | | | |
| | | | | | |
**WESTERN VIRGINIA WATER AUTHORITY**

**VALVE DIAGRAM**

5526 SOUTH VILLAGE DRIVE

SECT. MAP SW COUNTY

DATE 8-20-04