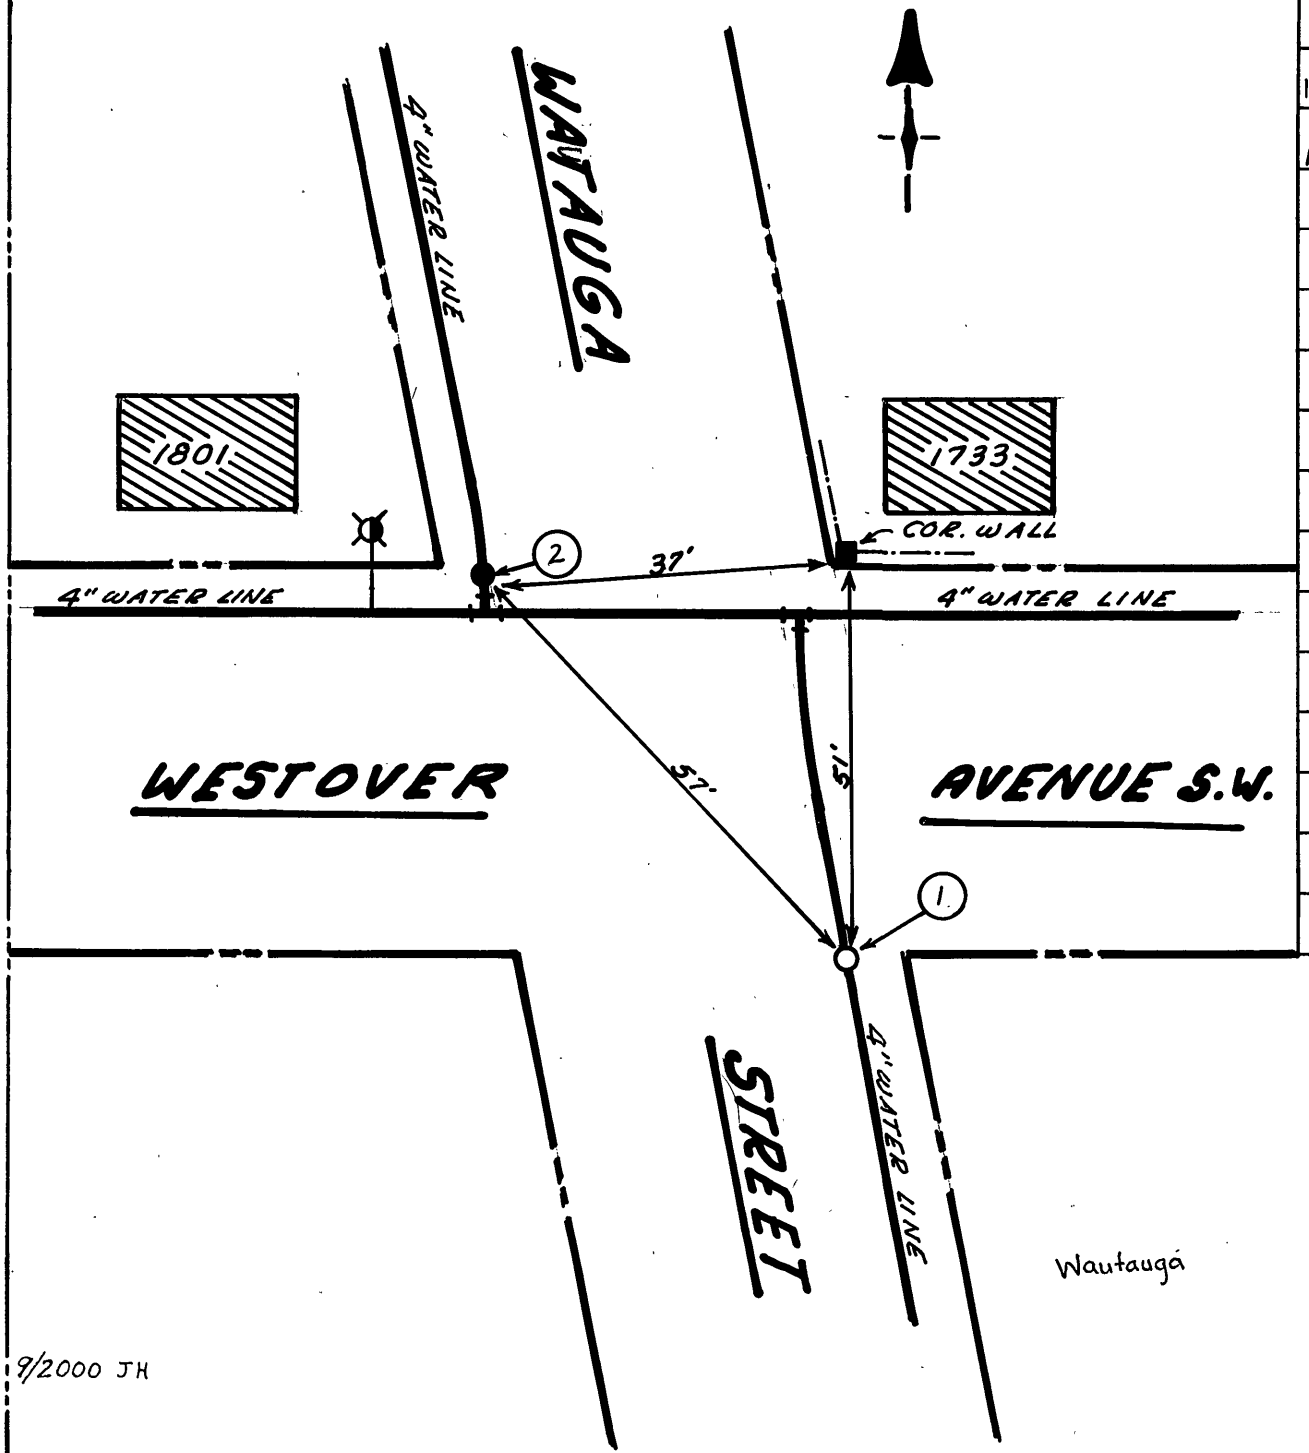


| DATE | NO. | SIZE | MAKE | OPEN | TURNS |
|---|---|---|---|---|---|
| 1910 | 1 | 4" | MUL. | R | 15 |
| 1984 | 2 | 4" | MUL. | R | 15 |
| | | | | | |
| | | | | | |
CITY OF ROANOKE—WATER DEP'T

VALVE DIAGRAM

WATAUGA STREET

WESTOVER AVENUE

SEC. MAP 133 S.W.

DATE 7-9-84 PAGE NO.

9/2000 JH