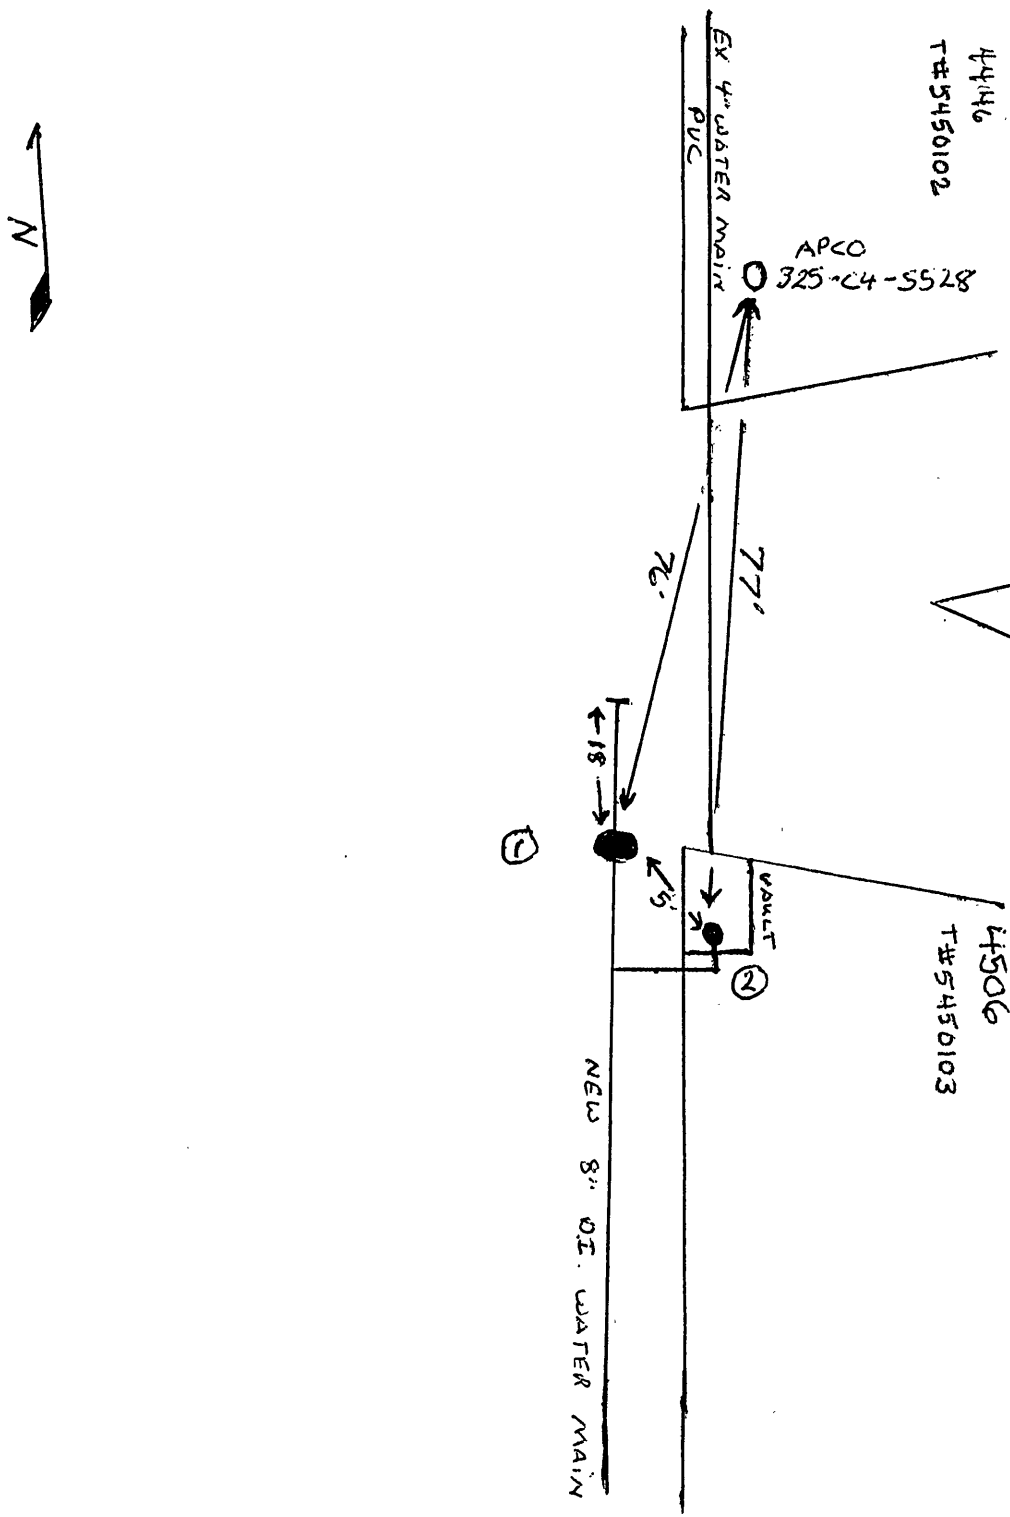

DATE	NO.	SIZE	MAKE	OPEN	TURNS
6-97	1	8"	MULL	R	27
6-97	2	4"	MULL	R	15

CITY OF ROANOKE—WATER DEP'T

VALVE DIAGRAM

4500 BLOCK VAN WINKLE SW

685' South of Griffin Rd

SEC. MAP 546

DATE 6-97 PAGE NO.