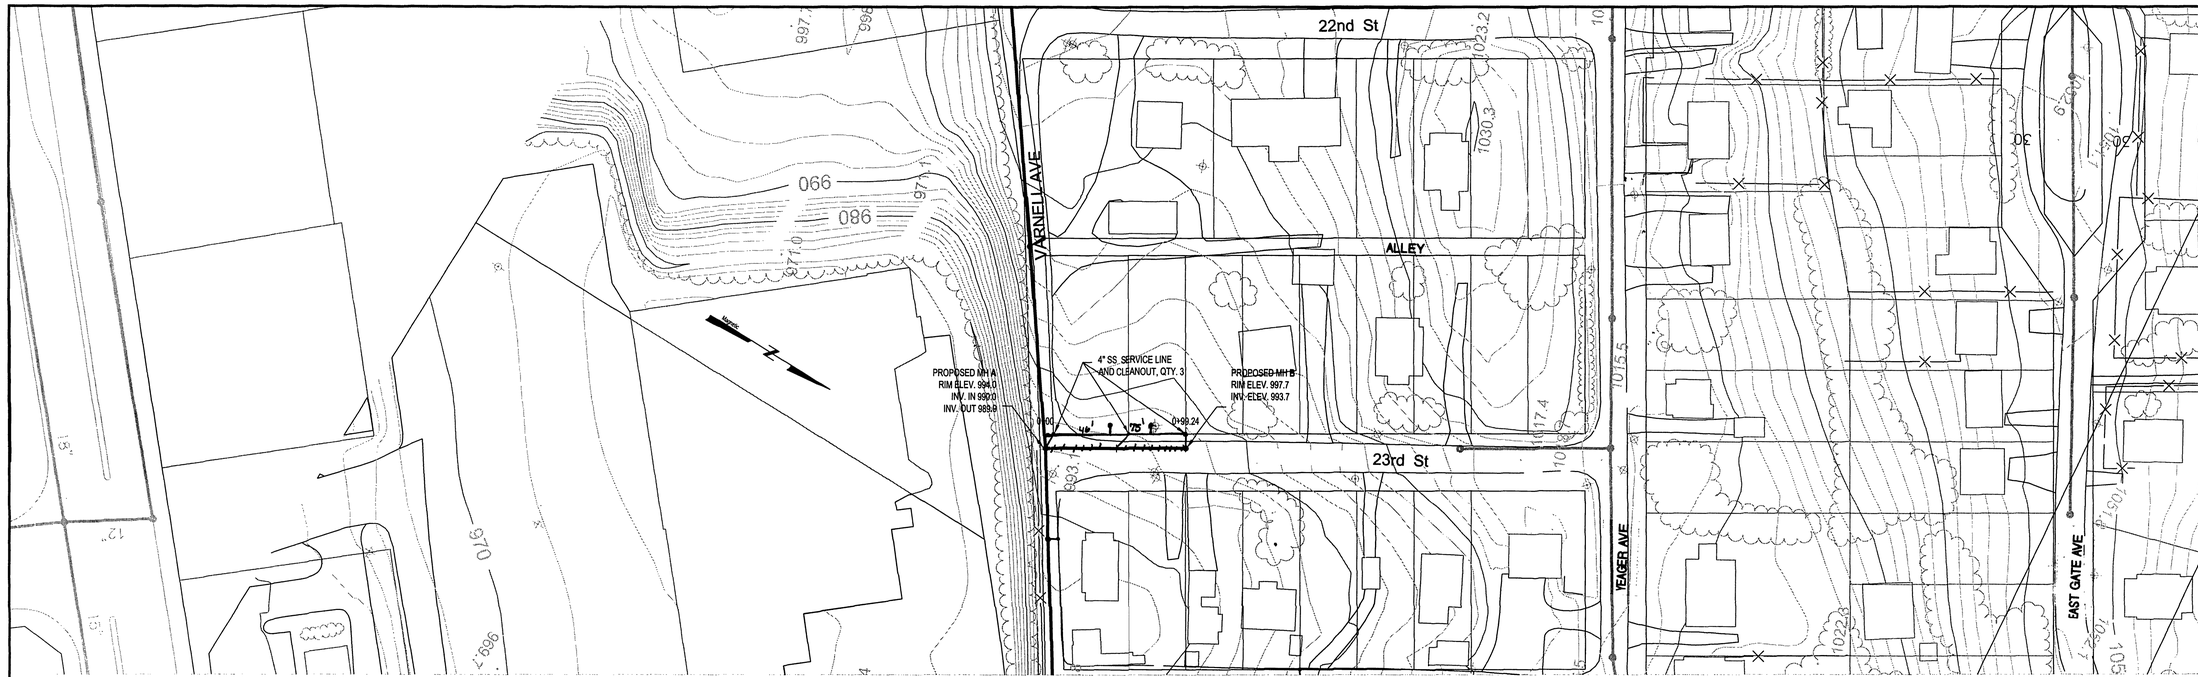

LEGEND

- EXISTING SANITARY SEWER
- PROPOSED SANITARY SEWER
- EXISTING SANITARY SEWER MANHOLE
- PROPOSED SANITARY SEWER MANHOLE
- PROPOSED SANITARY SEWER EASEMENT
- PROPERTY LINE
- EXISTING FENCELINE

50' 25' 0' 50' 100'

Scale : 1" = 50'

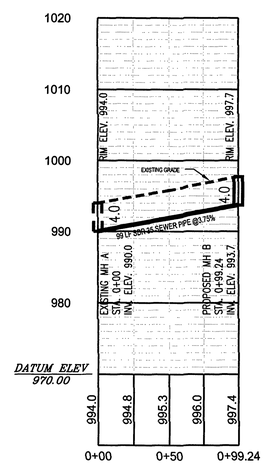

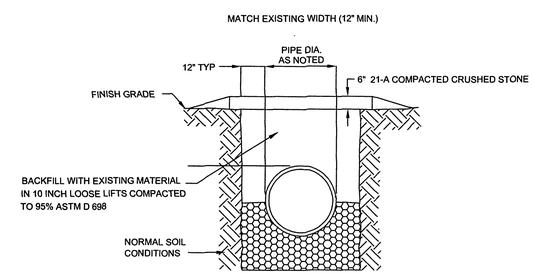

ROAD REPAIR DETAIL
(23rd STREET, NE)
NOT TO SCALE

NOTES:

1. ALL WORK SHALL CONFORM TO WESTERN VIRGINIA WATER AUTHORITY DESIGN & CONSTRUCTION STANDARDS LATEST EDITION.

AS-BUILT
4/19/2005

SCALE: HOR. 1 IN. = 50 FT.
VERT. 1 IN. = 10 FT.

WVWA ID# 8K8MGC

WESTERN VIRGINIA WATER AUTHORITY

ENGINEERING SERVICES
2012 SOUTH JEFFERSON STREET
ROANOKE, VIRGINIA 24014
PHONE: (540) 853-5641

COMMONWEALTH OF VIRGINIA
J. GREGORY REED
027721
PROFESSIONAL ENGINEER

23rd STREET, NE
PROPOSED SEWER EXTENSION

Designed By:	JAD
Drawn By:	JAD
Checked By:	JGR
Date:	12/16/04
Scale:	AS NOTED
Plan #:	
Sheet:	2 OF 3

.-C:\LAND PROJECTS 2005\22ND STREET PAGE 1 - 9/15/2005 10:56:03 AM