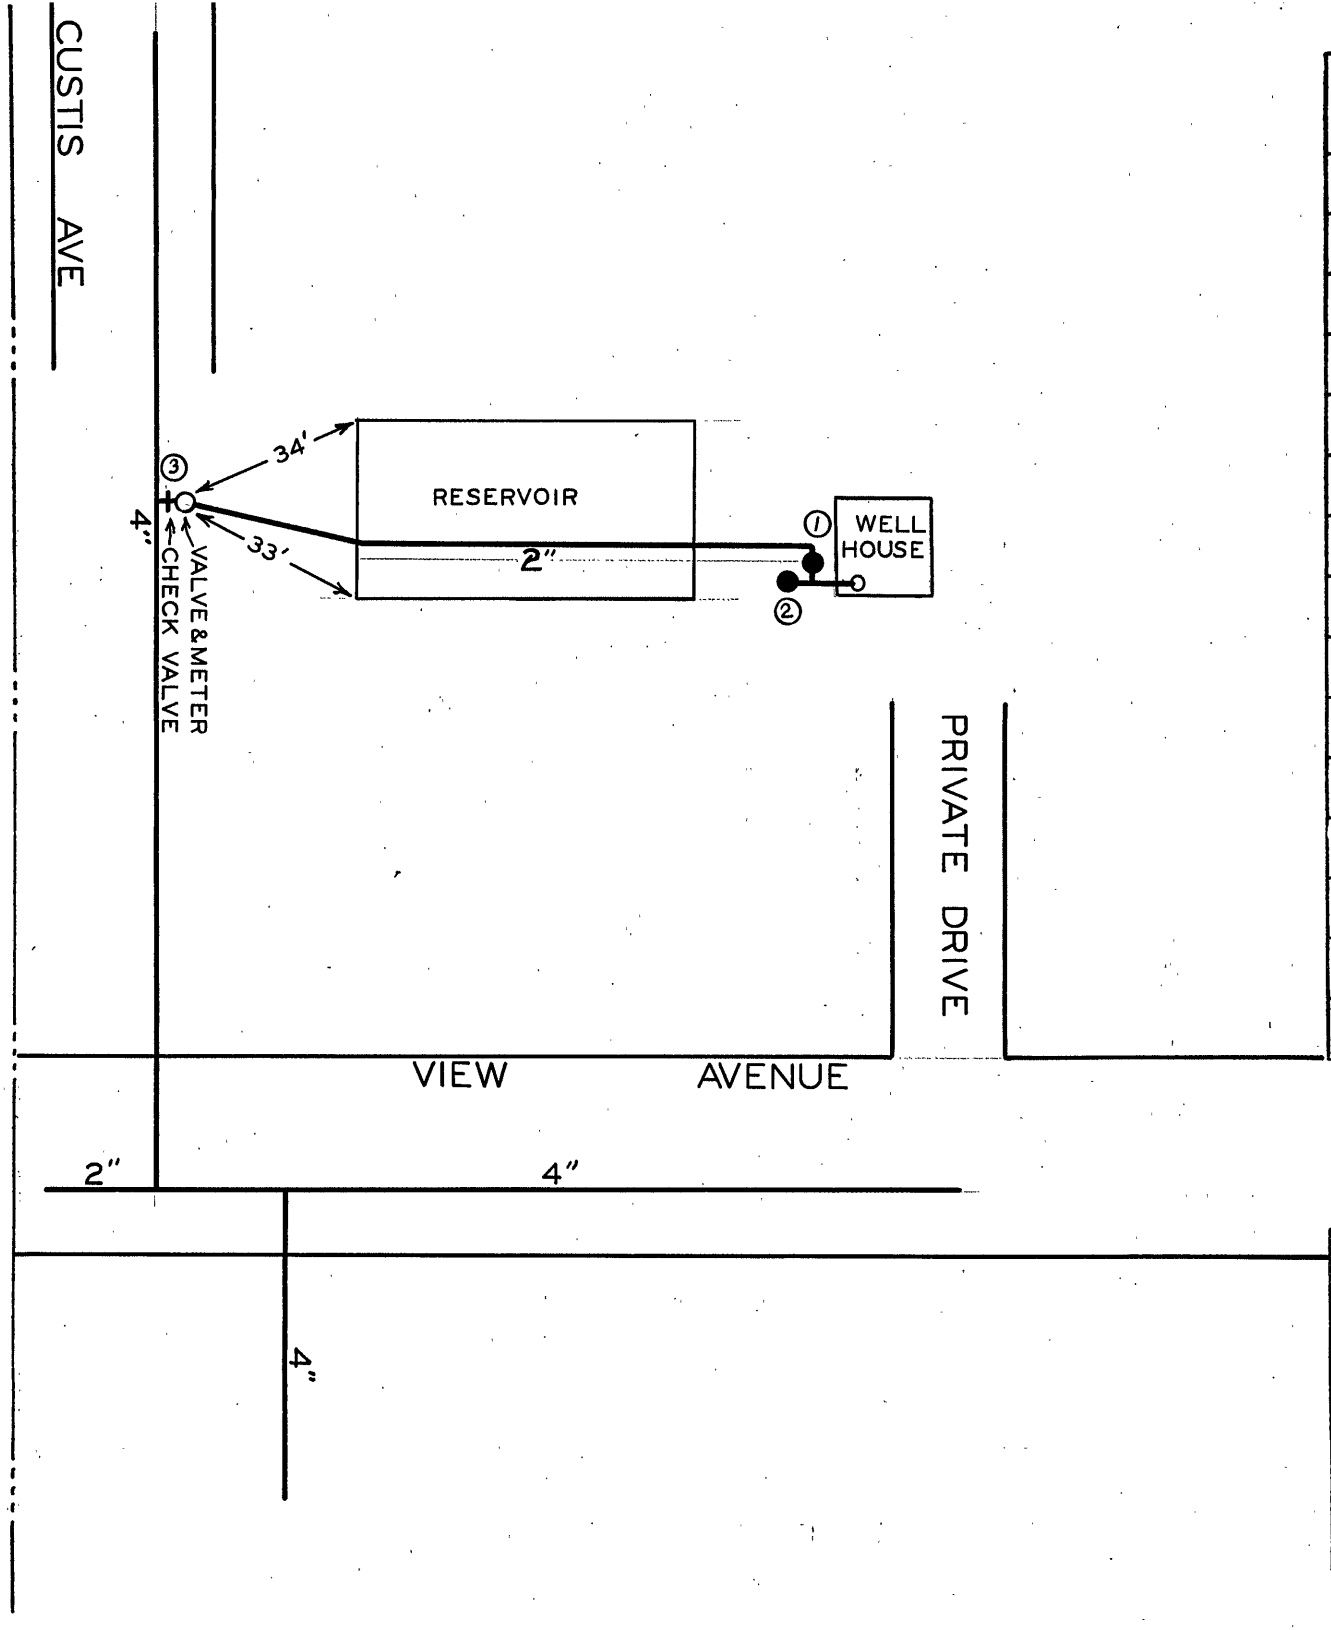

DATE	NO.	SIZE	MAKE	OPEN	TURNS
	1	2"		L	
	2	2"	BLOW OFF	L	
	3	4"	CHECK VALVE		

CITY OF ROANOKE—WATER DEPT.

VALVE DIAGRAM

VIEW AVENUE S.W.

SEC. MAP

DATE **PAGE NO.**