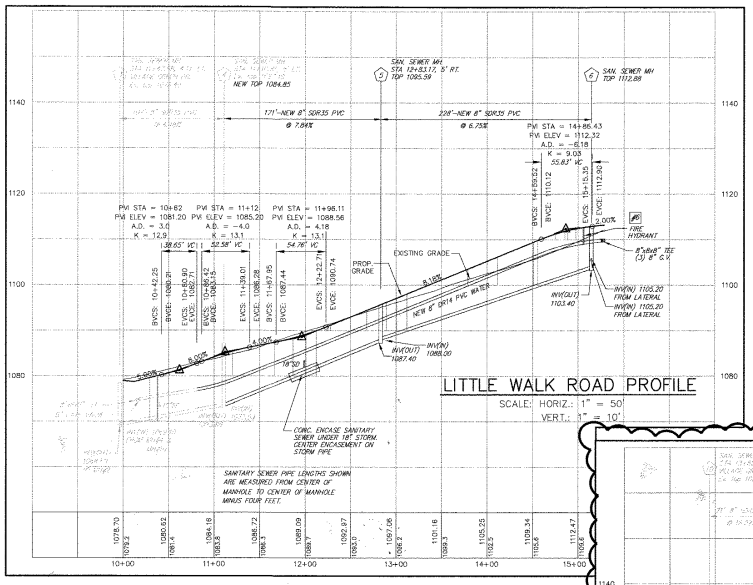

LITTLE WALK ROAD PROFILE

SCALE: HORIZ.: 1" = 50'
VERT.: 1" = 10'

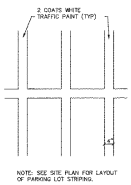

NOTE: SEE SITE PLAN FOR LAYOUT OF PARKING LOT STRIPING.

PAVEMENT STRIPING DETAIL

N.T.S.



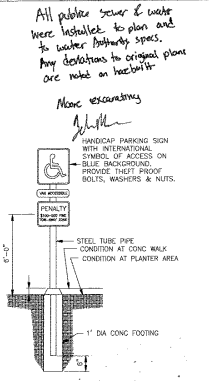

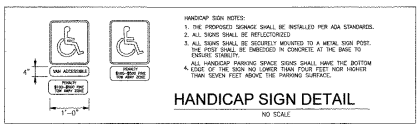

HANDICAP SIGN NOTES:
1. THE PROPOSED SIGNAGE SHALL BE INSTALLED PER ADA STANDARDS.
2. ALL SIGNS SHALL BE REFLECTORIZED
3. ALL SIGNS SHALL BE SECURELY MOUNTED TO A METAL SIGN POST. THE POST SHALL BE EMBEDDED IN CONCRETE AT THE BASE TO ENSURE STABILITY.
4. ALL HANDICAP PARKING SPACE SIGNS SHALL HAVE THE BOTTOM EDGE OF THE SIGN NO LOWER THAN FOUR FEET, NOR HIGHER THAN SEVEN FEET ABOVE THE PARKING SURFACE.

HANDICAP SIGN DETAIL

NO SCALE

HANDICAP SIGNPOST DETAIL

NO SCALE

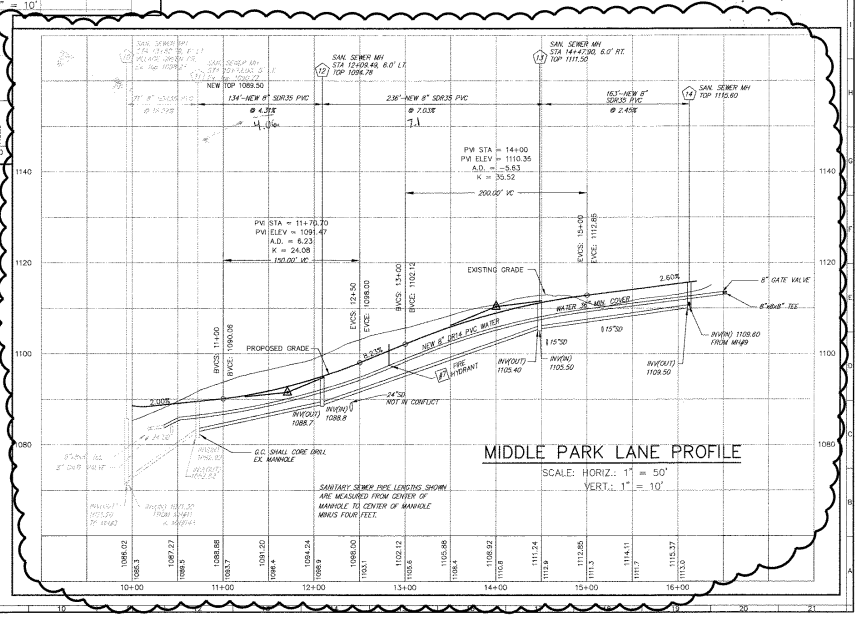

MIDDLE PARK LANE PROFILE

SCALE: HORIZ.: 1" = 50'
VERT.: 1" = 10'

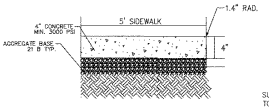

NOTE:
FINISH - TROWELED EDGES, BROOM FINISH
SCORING EVERY 6'
EXPANSION JOINTS EVERY 30' MIN.

G.C. SHALL BE RESPONSIBLE FOR OBTAINING ADEQUATE SUB-GRADE COMPACTION.

SIDEWALK DETAIL

N.T.S.

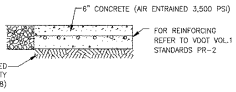

NOTE:
G.C. SHALL BE RESPONSIBLE FOR OBTAINING ADEQUATE SUB-GRADE COMPACTION.

SECTION THROUGH DUMPSTER PAD

NO SCALE

BALZER
ARE ENGINEERS ARE SURVEYORS ARE
BALZER
REPLECTING TOMORROW
www.balzer.cc
Roanoke
New River Valley
Richmond
Staunton
Harrisonburg
INGENIERIA, LAND DEVELOPMENT ENGINEERING
SITE DEVELOPMENT ENGINEERING
LAND USE PLANNING & ZONING
LANDSCAPE ARCHITECTURE
LAND SURVEYING
ARCHITECTURE
STRUCTURAL ENGINEERING
TRANSPORTATION ENGINEERING
ENVIRONMENTAL & SOIL SCIENCE
WETLAND DELINEATIONS & STREAM EVALUATIONS
Balzer and Associates, Inc.
1208 Corporate Circle
Roanoke, VA 24018
540-772-9580
FAX 540-772-8050

COMMONWEALTH OF VIRGINIA
"CHRISTOPHER P. BUSKEY"
Lic. No. 47298
4/19/2021
PROFESSIONAL ENGINEER

THE VILLAGE GREEN PHASE III
CAREFREE LANE
ROAD PROFILES & DETAILS
HOLLINS DISTRICT
ROANOKE COUNTY, VIRGINIA

DRAWN BY CPB
DESIGNED BY CPB
CHECKED BY BTC
DATE 1/5/2018
SCALE AS NOTED

REVISIONS:
3/23/2018
4/13/2018
5/2/2018
8/9/2019 P.R. #1
3/11/2020 P.R. #2
4/19/2021 P.R. #4

SHEET NO.
C12
JOB NO. 04170034.00