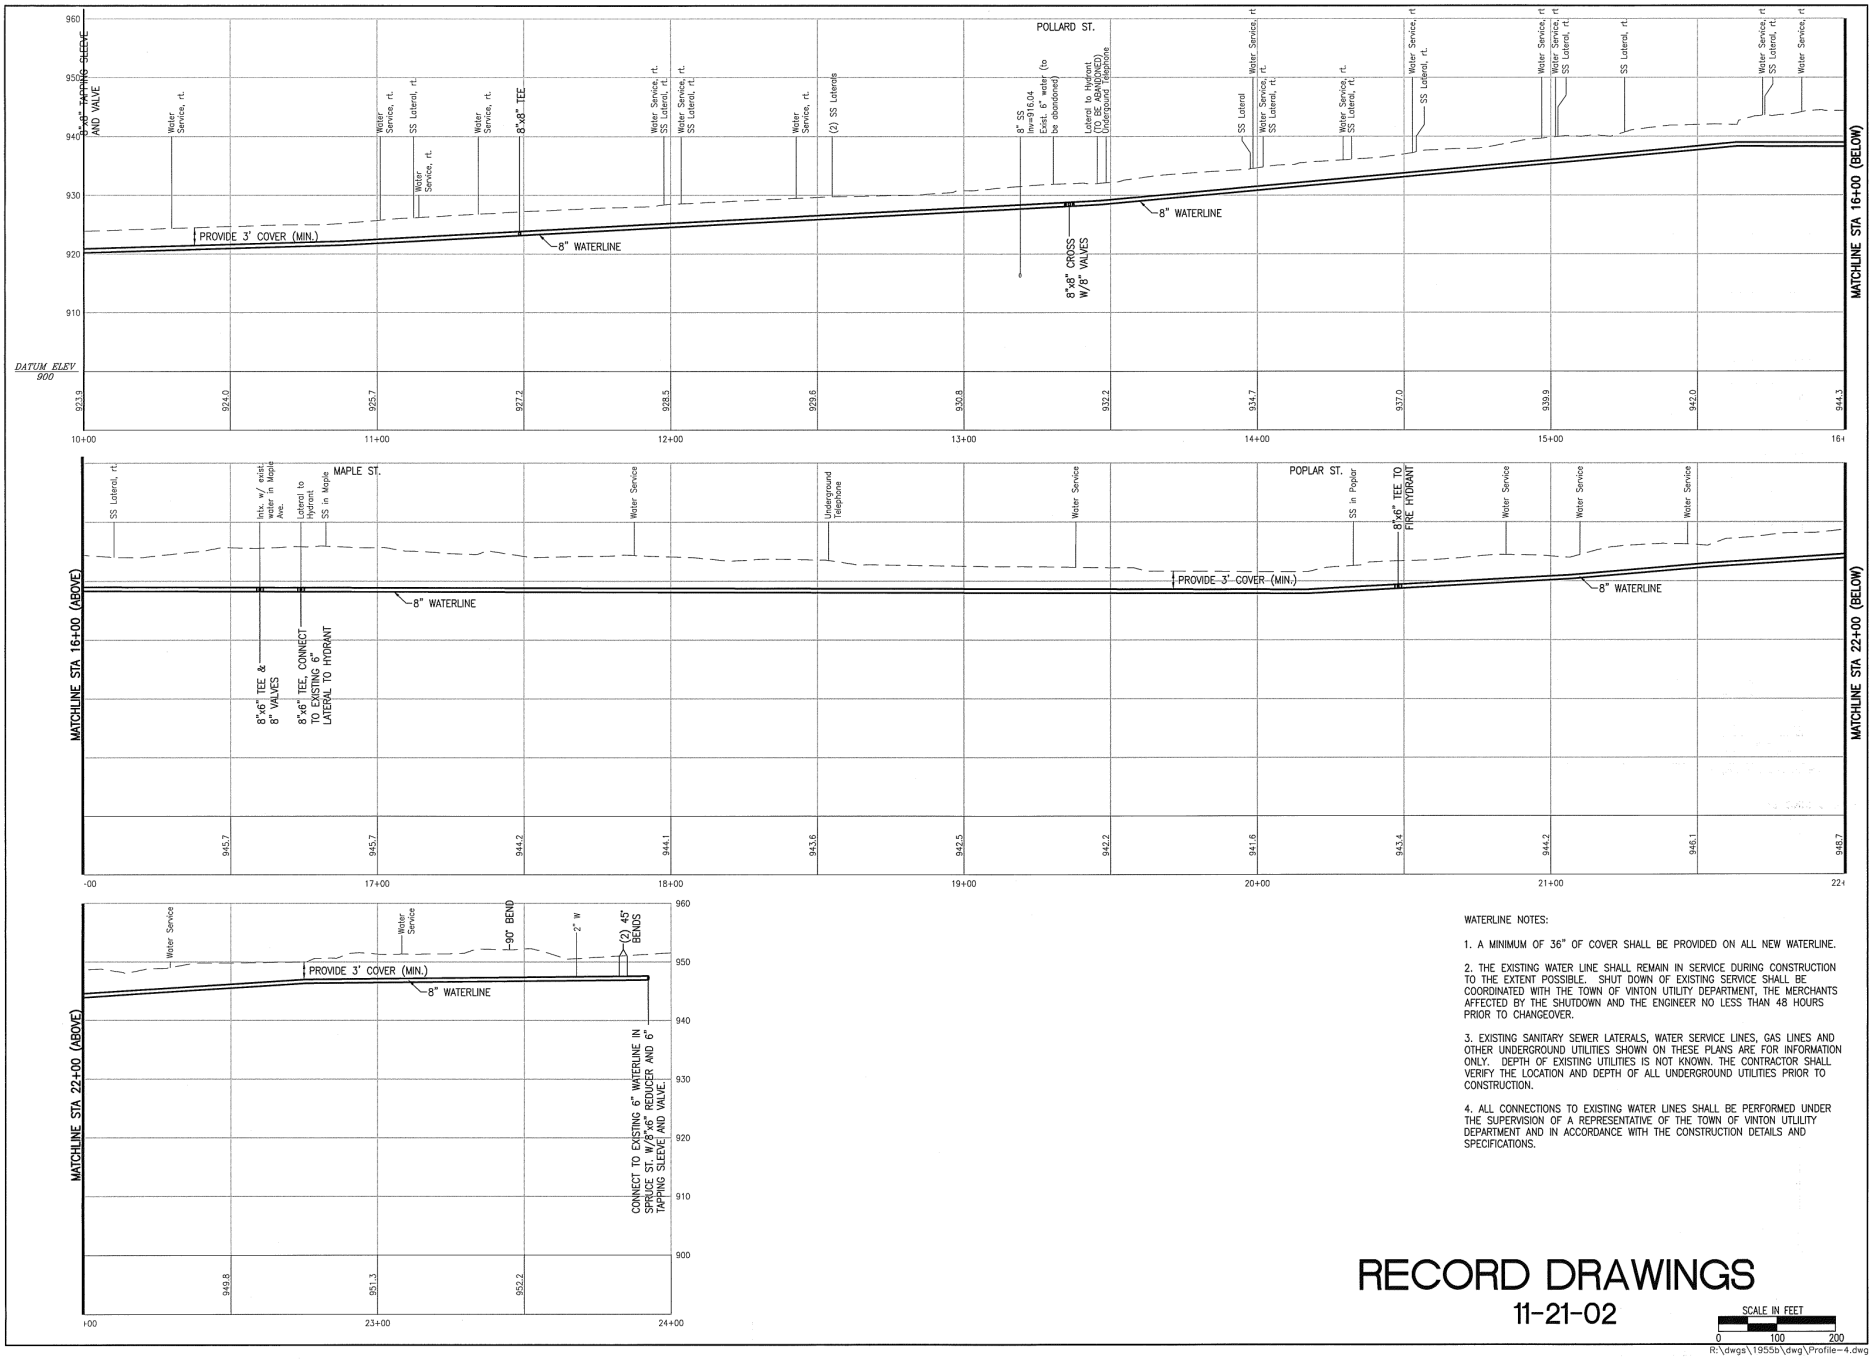

WATERLINE NOTES:

1. A MINIMUM OF 36" OF COVER SHALL BE PROVIDED ON ALL NEW WATERLINE.

2. THE EXISTING WATER LINE SHALL REMAIN IN SERVICE DURING CONSTRUCTION TO THE EXTENT POSSIBLE. SHUT DOWN OF EXISTING SERVICE SHALL BE COORDINATED WITH THE TOWN OF VINTON UTILITY DEPARTMENT, THE MERCHANTS AFFECTED BY THE SHUTDOWN AND THE ENGINEER NO LESS THAN 48 HOURS PRIOR TO CHANGEOVER.

3. EXISTING SANITARY SEWER LATERALS, WATER SERVICE LINES, GAS LINES AND OTHER UNDERGROUND UTILITIES SHOWN ON THESE PLANS ARE FOR INFORMATION ONLY. DEPTH OF EXISTING UTILITIES IS NOT KNOWN. THE CONTRACTOR SHALL VERIFY THE LOCATION AND DEPTH OF ALL UNDERGROUND UTILITIES PRIOR TO CONSTRUCTION.

4. ALL CONNECTIONS TO EXISTING WATER LINES SHALL BE PERFORMED UNDER THE SUPERVISION OF A REPRESENTATIVE OF THE TOWN OF VINTON UTLILITY DEPARTMENT AND IN ACCORDANCE WITH THE CONSTRUCTION DETAILS AND SPECIFICATIONS.

RECORD DRAWINGS
11-21-02

SCALE IN FEET
0 100 200

R:\dwgs\1955b\dwg\Profile-4.dwg

COMMONWEALTH OF VIRGINIA
STEVEN W. HUBBELL
No. 07120
PROFESSIONAL ENGINEER

Revisions	Date
1 RECORD DRAWINGS	11/21/02

Issue Date: AUG. 19, 2001
Drawn By: JPR
Designed By: JPR
Checked By: SWH
Date: AUG. 17, 2001

Mattern & Craig
CONSULTING ENGINEERS • SURVEYORS
701 FIRST STREET, S.W.
ROANOKE, VIRGINIA 24016
(540) 345-9342
FAX (540) 345-7081

DOWNTOWN IMPROVEMENTS
WATERLINE PROFILE
LEE AVENUE
TOWN OF VINTON, VIRGINIA

Vertical Scale: 1"=10'
Horizontal Scale: 1"=20'
Commission Number: 1955B
Sheet No.: 14

--PROFILE_4 LAYOUT1 _1_ PAGE 1 - 11/21/02 3:24:01 PM