

1. NO CONSTRUCTION/FIELD CHANGES WITHOUT THE APPROVAL OF THE CONSULTING ENGINEER, ROANOKE COUNTY, VDOT, AND/OR WVVA.
2. ANY NEW ALIGNMENTS, CHANGES IN GRADES, ALTERNATIVE PIPE SIZE OR MANHOLES OR ESC MEASURES WILL REQUIRE A NEW SET OF PLANS STAMPED BY THE CONSULTING ENGINEER. PLAN SHEETS CAN BE 8.5"x11" IF THE INFORMATION IS LEGIBLE.
3. ALL BUILDING DIMENSIONS AND UTILITY CONNECTIONS SHALL BE COORDINATED WITH THE ARCHITECTURAL PLANS. THE CONCRETE PAD CONSTRUCTION SHALL BE COORDINATED WITH THE ARCHITECTURAL PLANS.
4. ROOF LEADERS FOR BUILDING SHALL DISCHARGE AT GRADE TO THE PARKING SPACES IN THE REAR OF THE BUILDING. (SOUTHWEST LOCATION) G.C. SHALL PROVIDE COMMERCIAL GRADE SPLASH BLOCKS FOR DOWNSPOUT EXTENSIONS TO ENSURE ALL ROOF WATER IS CONVEYED TO THE PARKING AREA.
5. ALL STANDARD PARKING LOT STRIPING SHALL BE PAINTED WITH 4" WIDE WHITE PAINT. HANDICAP SPACES SHALL BE PAINTED WITH 4" WIDE BLUE PAINT.
6. G.C. SHALL COORDINATE WITH APPROPRIATE UTILITY COMPANIES TO BRING NECESSARY UTILITIES TO THE PROPOSED BUILDING.
  - A. ROANOKE GAS SHALL PROVIDE THE GAS LATERAL FROM THE EXISTING MAIN TO THE METER SETTER AT THE BUILDING
  - B. A.E.P. - SHALL PROVIDE THE REQUIRED ELECTRICAL CABLE FROM THE UTILITY POLE TO THE METER AT THE BUILDING IN THE GENERAL CONTRACTORS SUPPLIED & INSTALLED CONDUIT.
  - C. COX COMMUNICATIONS - G.C. SHALL COORDINATE DIRECTLY TO DETERMINE WHERE THE PROVIDER WILL PROVIDE SERVICE FROM AND CONNECTION TO THE BUILDING.
7. G.C. SHALL COORDINATE & PROVIDE ALL REQUIRED CONDUIT INSTALLATION FOR ALL NECESSARY UTILITIES FOR THE BUILDING. CONDUIT SHALL BE PROVIDED FOR ALL UTILITIES LOCATED UNDER PAVEMENT OR CONCRETE PRIOR TO PLACEMENT.
8. G.C. SHALL ENSURE POSITIVE DRAINAGE AWAY FROM PROPOSED BUILDING.
9. ALL SITE GRADING AND SUB-GRADE SHALL CONFORM TO THE RECOMMENDATIONS AND REQUIREMENTS SETFORTH BY THE GEOTECHNICAL REPORT PROVIDED BY F&R.
10. G.C. SHALL CONFIRM DURING THE EXCAVATION PROCESS THAT THE EXISTING PAVEMENT CUT SHOWN ON THE EAST SIDE OF THE EXISTING MOTEL BUILDING DOES NOT CONTAIN AN UNDERDRAIN SYSTEM OR OTHER PIPING BURIED UNDERGROUND.
11. ALL SITE IMPROVEMENTS, GRADING, MATERIAL PLACEMENT, AND COMPACTION STANDARDS SHALL COMPLY WITH THE GEOTECHNICAL REPORT FROM F&R DATED SEPTEMBER 2013

1. G.C. SHALL PROVIDE (2) 4" PVC SCHEDULE 40 CONDUITS FROM BUILDING TO PROVIDE POWER TO THE PROPOSED MONUMENT SIGN.
2. G.C. SHALL PROVIDE (4) 4" PVC SCHEDULE 40 CONDUITS BETWEEN THE EXISTING UTILITY SERVICE AND PROPOSED SERVICE IN BUILDING. G.C. TO COORDINATE DIRECTLY WITH AEP/VERIZON/T.E.C./ETC.

FROM	INV. IN	TO	INV. OUT	
E	1146.12	D	1146.0	6' OF 4" SDR-35 PVC PIPE @ 2.0%
D	1146.0	C	1144.08	26' OF 4" SDR-35 PVC PIPE @ 7.3%
C	1144.08	B	1143.32	38' OF 4" SDR-35 PVC PIPE @ 7.3%
BLDG.	1145.0	B	1143.32	23' OF 4" SDR-35 PVC PIPE @ 2.0%
B	1138.72	A	1137.58	5' OF 4" SDR-35 PVC PIPE @ 2.0%
A	1137.58	EX. MH.	1137.4	9' OF 6" SDR-35 PVC PIPE @ 2.0%

① VDOT ST'D DI-1  
(GRATE W/SQUARE TOP)  
TOP=1145.8  
INV. OUT=1141.8

② 14 LF OF 15" ALLUMINIZED  
CMP @ 2%  
INV. OUT TO SWM=1141.52

③ TRAFFIC BEARING ACCESS  
MANHOLE W/CONC. COLLAR  
TOP=1146.5  
(SEE SHEET C11)

④ 60 LF OF 48" ALLUMINIZED  
UPPER UNDERGROUND S.W.M.  
(PIPE SLOPE 1.0%)  
UPPER INV.=1139.20  
INV. OUT=1138.60  
(SEE SHEET C11)

⑤ TRAFFIC BEARING ACCESS  
MANHOLE W/CONC. COLLAR  
TOP=1147.1  
(SEE SHEET C11)

⑥ VDOT ST'D DI-3B  
(6" THROAT)  
TOP=1144.7  
INV. OUT=1140.7

⑦ 28 LF OF 15" ALLUMINIZED  
CMP @ 2%  
INV. OUT TO SWM=1140.14

⑧ 28 LF OF 15" HDPE N-12  
CMP @ 2%  
INV. OUT=1138.04

⑨ 6"x4" FILTERRA  
UNIT W/4" PVC DISCHARGE  
PIPE TO CONNECT DIRECTLY  
TO S.W.M. PIPE  
TOP=1146.5  
INV. OUT FROM FILTERRA=1143  
INV. IN TO STR. #1=1142.0  
(PROVIDE WATERTIGHT FERNCO COUPLER  
OR APPROVED EQUAL FOR CONNECTION  
TO STUB OUT FOR S.W.M. FACILITY)

**STORM SEWER PROFILE (STR. #1 - #6)**

**1"=30' HORIZONTAL**  
**1"=10' VERTICAL**

**NOTE: G.C. TO PROVIDE NECESSARY TRENCH FOR CONSTRUCTION AND COMPLY WITH ALL STANDARDS AND PROCEDURES**

**MANHOLE 1 (STR. #1):**  
 VDOT STD. DI-1  
 SQUARE GRATE  
 TOP=1145.8  
 INV. OUT=1141.8


**PIPE SEGMENTS:**  
 4" PRIVATE-LATERAL PIPE (S.S.)  
 60 LF OF 48" ALLUMINIZED CMP UNDERGROUND S.W.M.  
 (PIPE SLOPE 1.0%)  
 UPPER INV=1139.2  
 LOWER INV=1138.6  
 28 LF OF 15" HDPE N-12 PIPE @ 2%  
 INV. OUT=1138.04  
 28 LF OF 15" ALLUMINIZED CMP @ 2%

**ORIFICE INFO:**  
 (3.5" ORIFICE AT ELEV. 1138.8 ON OUTLET PIPE FROM U.G. S.W.M. PIPE)

**PROPOSED GRADE** and **ex. grade** lines are shown.

**PIPE INVERTS:**  
 PIPE INV.=1141.92  
 PIPE INV.=1140.14


**MANHOLE 3 (STR. #3):**  
 ACCESS PORT  
 TOP=1146.5




NOTE: G.C. TO PROVIDE NECESSARY TRENCH BOXES  
FOR CONSTRUCTION AND COMPLY WITH ALL OSHA  
STANDARDS AND PROCEDURES

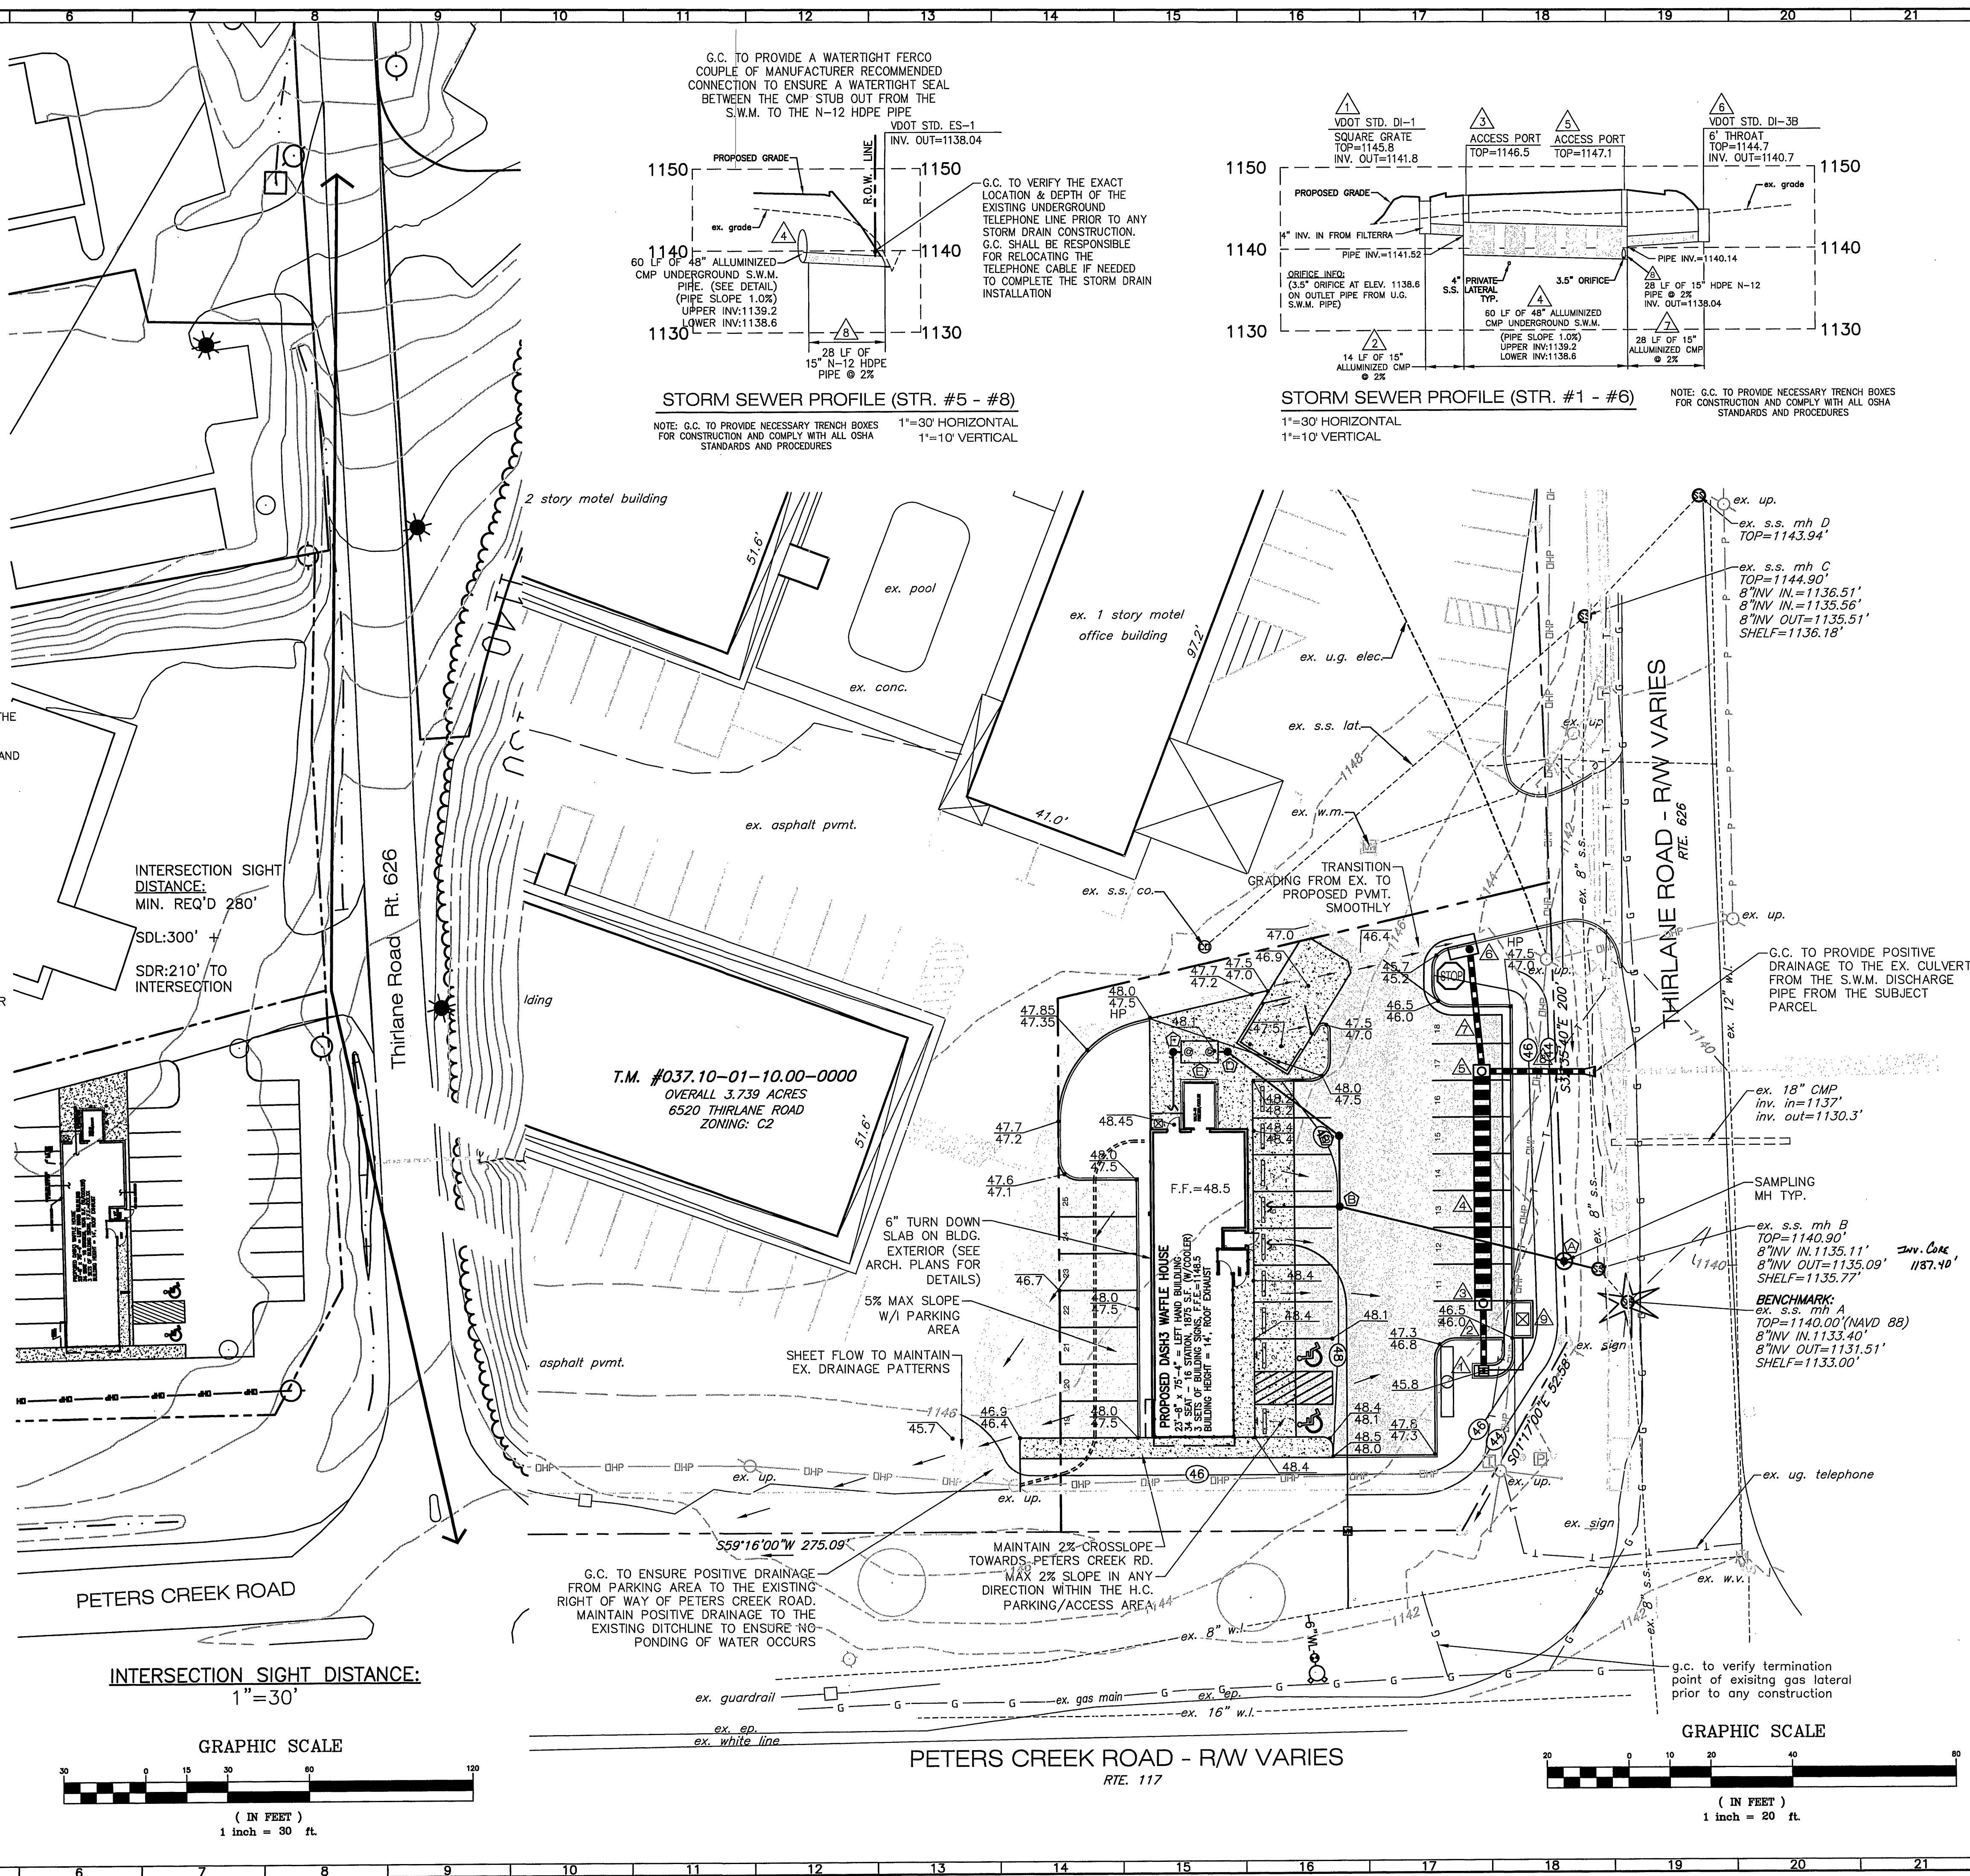

SHEET NO. **C05**

JOB NO. **R1300107.0**