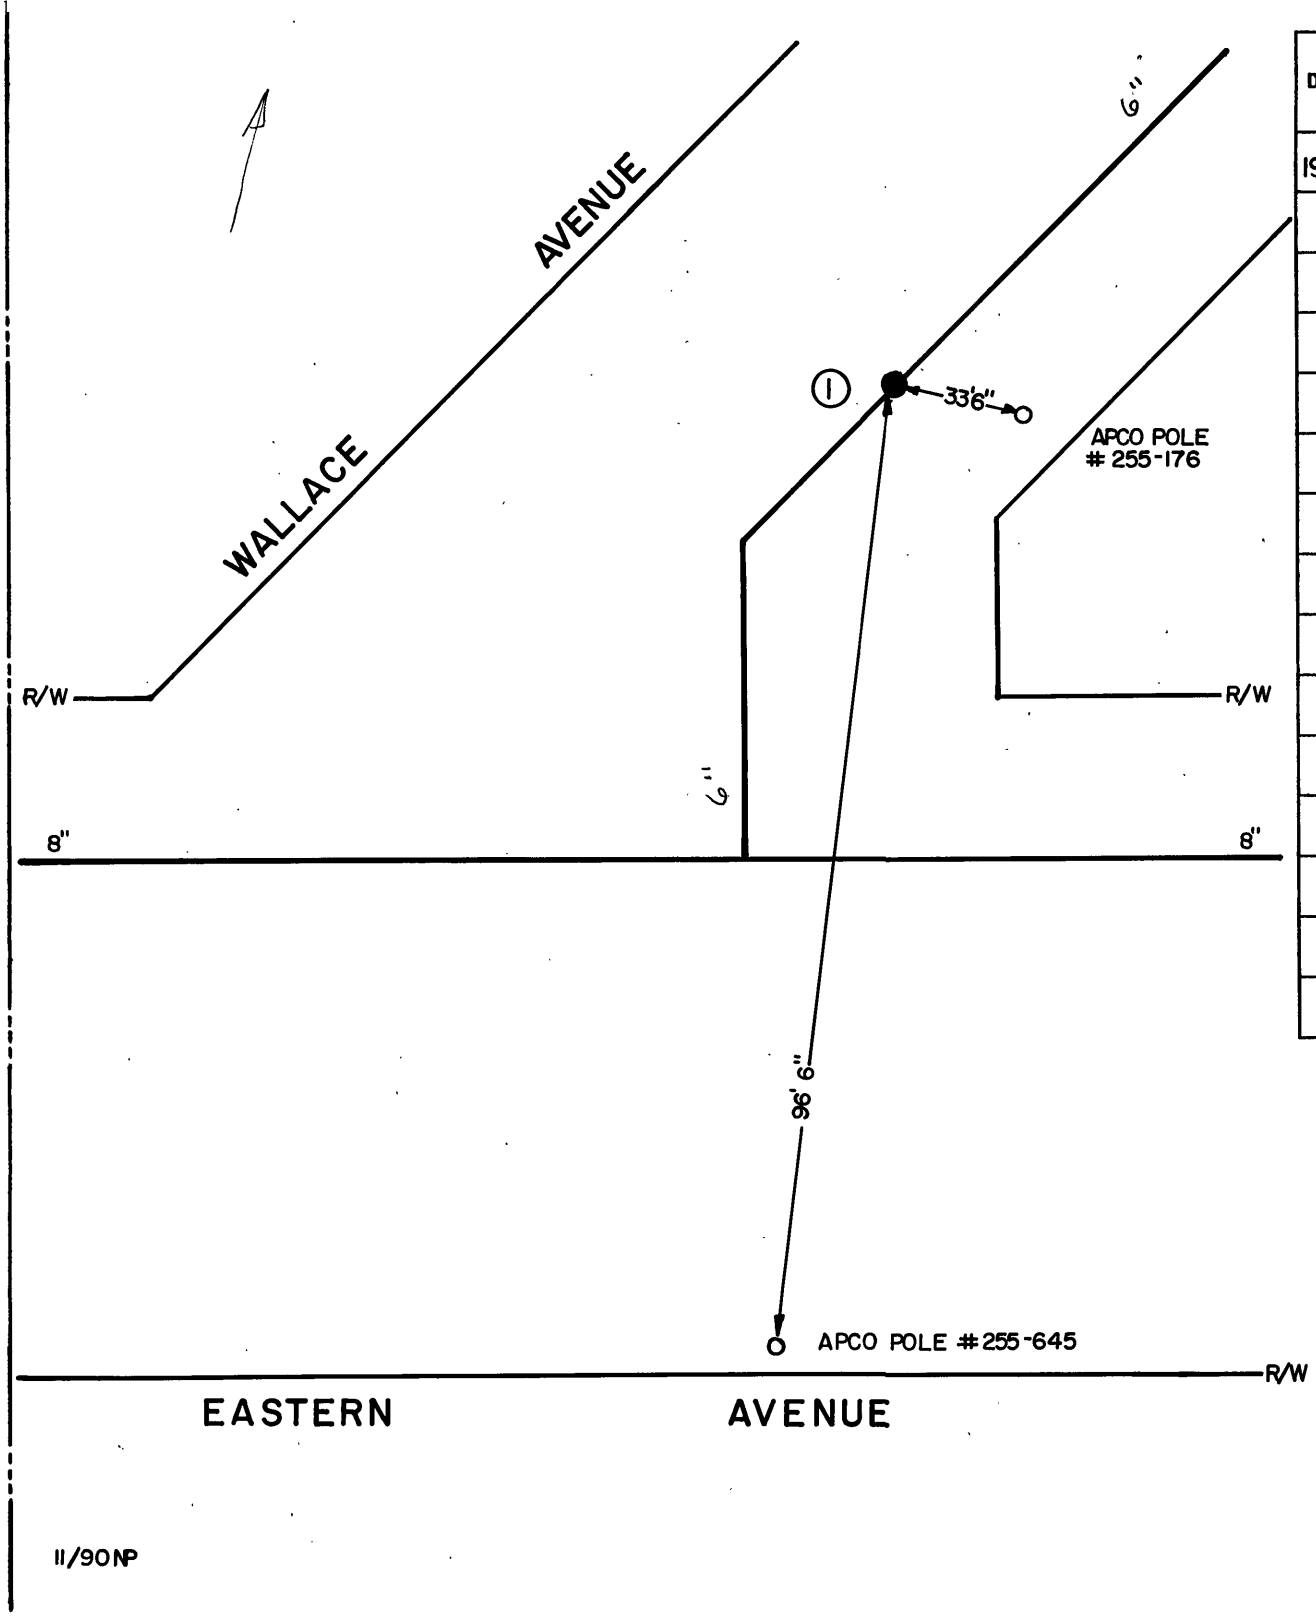

DATE	NO.	SIZE	MAKE	OPEN	TURNS
1990	1	6"	MUELLER	R	

CITY OF ROANOKE—WATER DEP'T

VALVE DIAGRAM

EASTERN AVENUE &

WALLACE AVENUE

N.E.

SEC. MAP 321,322

DATE PAGE NO.

11/90NP