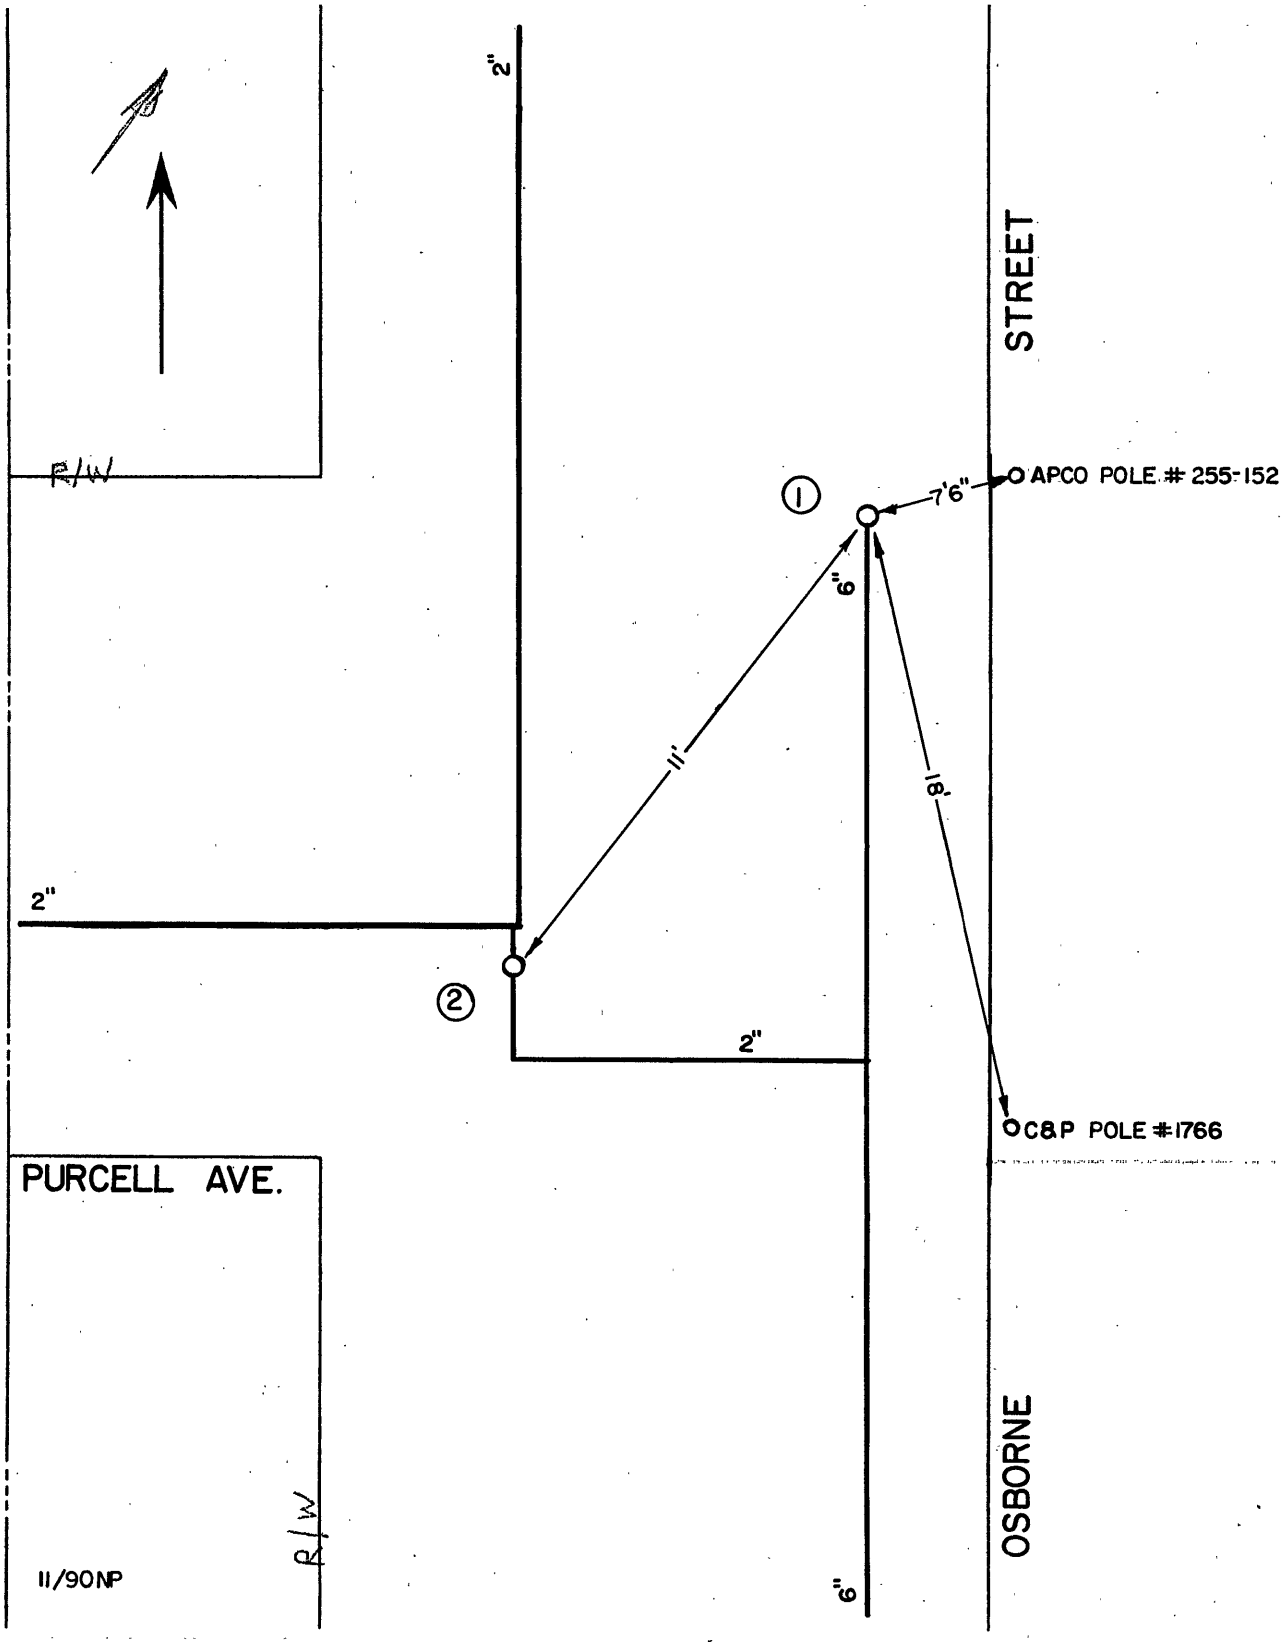

DATE	NO.	SIZE	MAKE	OPEN	TURNS
1990	1	2"	MISC-BLOW OFF	L	6 1/2
1990	2	2"	MUELLER	R	

CITY OF ROANOKE—WATER DEP'T

VALVE DIAGRAM

OSBORNE STREET &

PURCELL AVENUE

N.E.

SEC. MAP 333, 334

DATE PAGE NO.