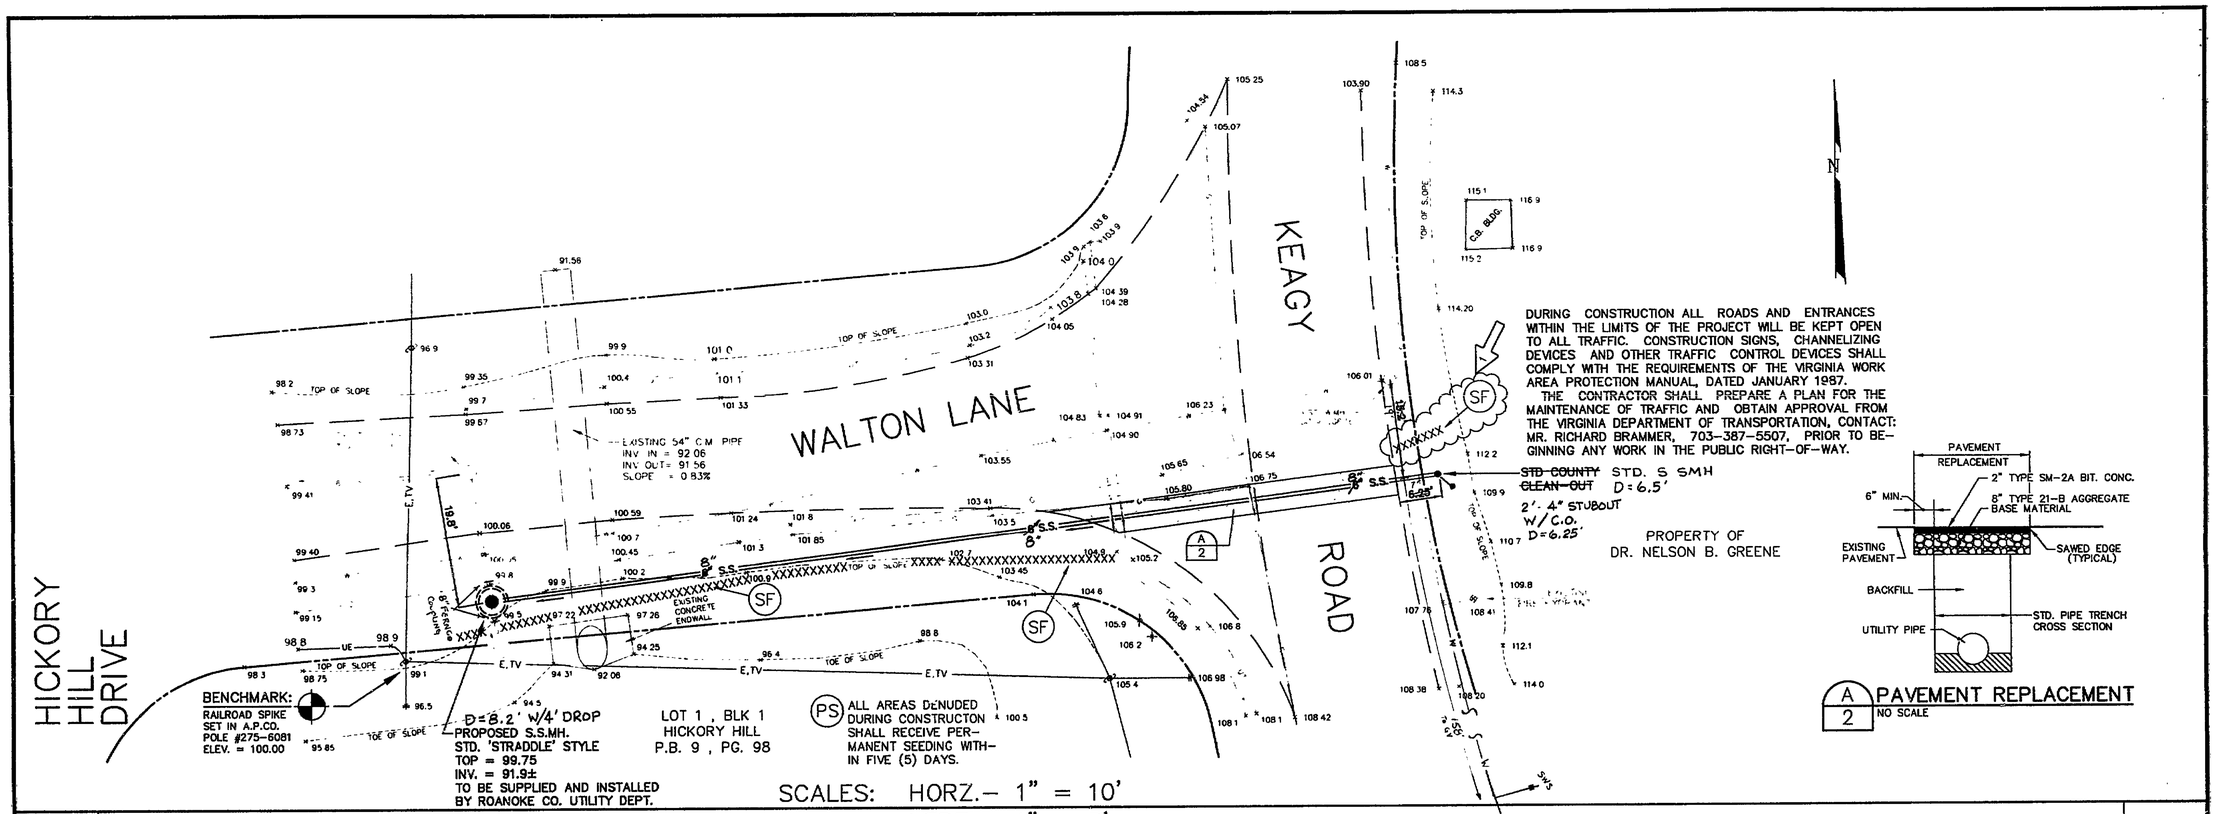

A/2 PAVEMENT REPLACEMENT
NO SCALE

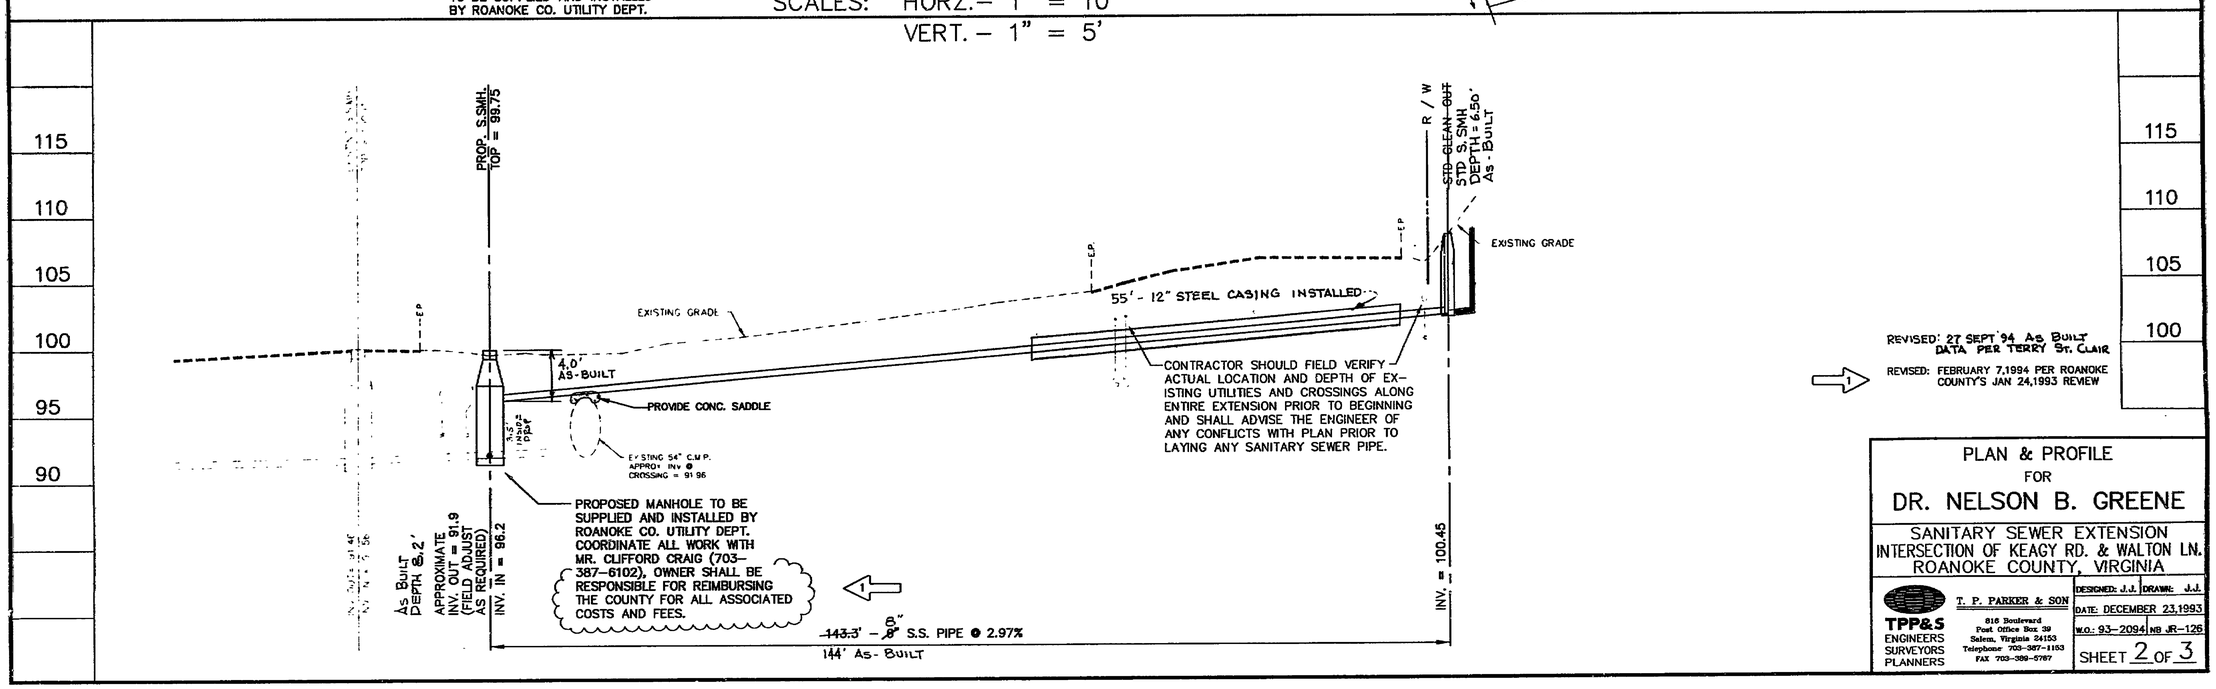

REVISED: 27 SEPT 94 AS BUILT DATA PER TERRY St. CLAIR
REVISED: FEBRUARY 7,1994 PER ROANOKE COUNTY'S JAN 24,1993 REVIEW

PLAN & PROFILE
FOR
DR. NELSON B. GREENE

SANITARY SEWER EXTENSION
INTERSECTION OF KEAGY RD. & WALTON LN.
ROANOKE COUNTY, VIRGINIA

TPP&S ENGINEERS SURVEYORS PLANNERS
T. P. PARKER & SON
816 Boulevard
Post Office Box 39
Salem, Virginia 24153
Telephone 703-387-1153
FAX 703-389-5787

DESIGNED: J.J. DRAWN: J.J.
DATE: DECEMBER 23,1993
W.O.: 93-2094 NB JR-126
SHEET 2 OF 3

SC-0300