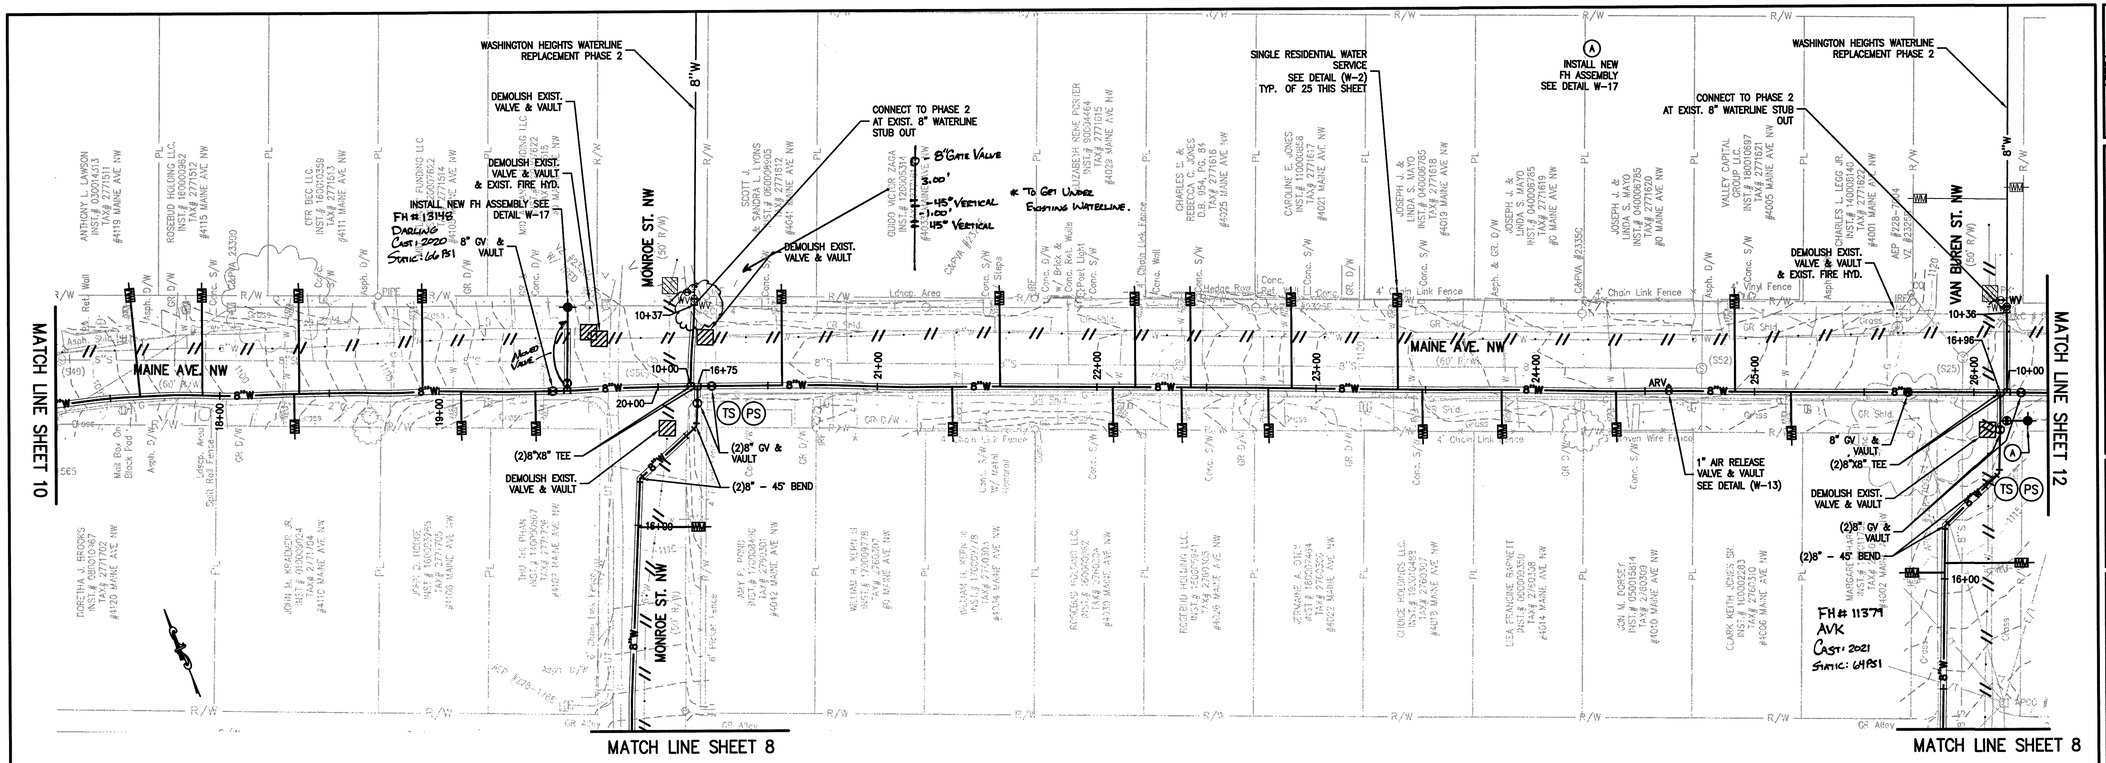

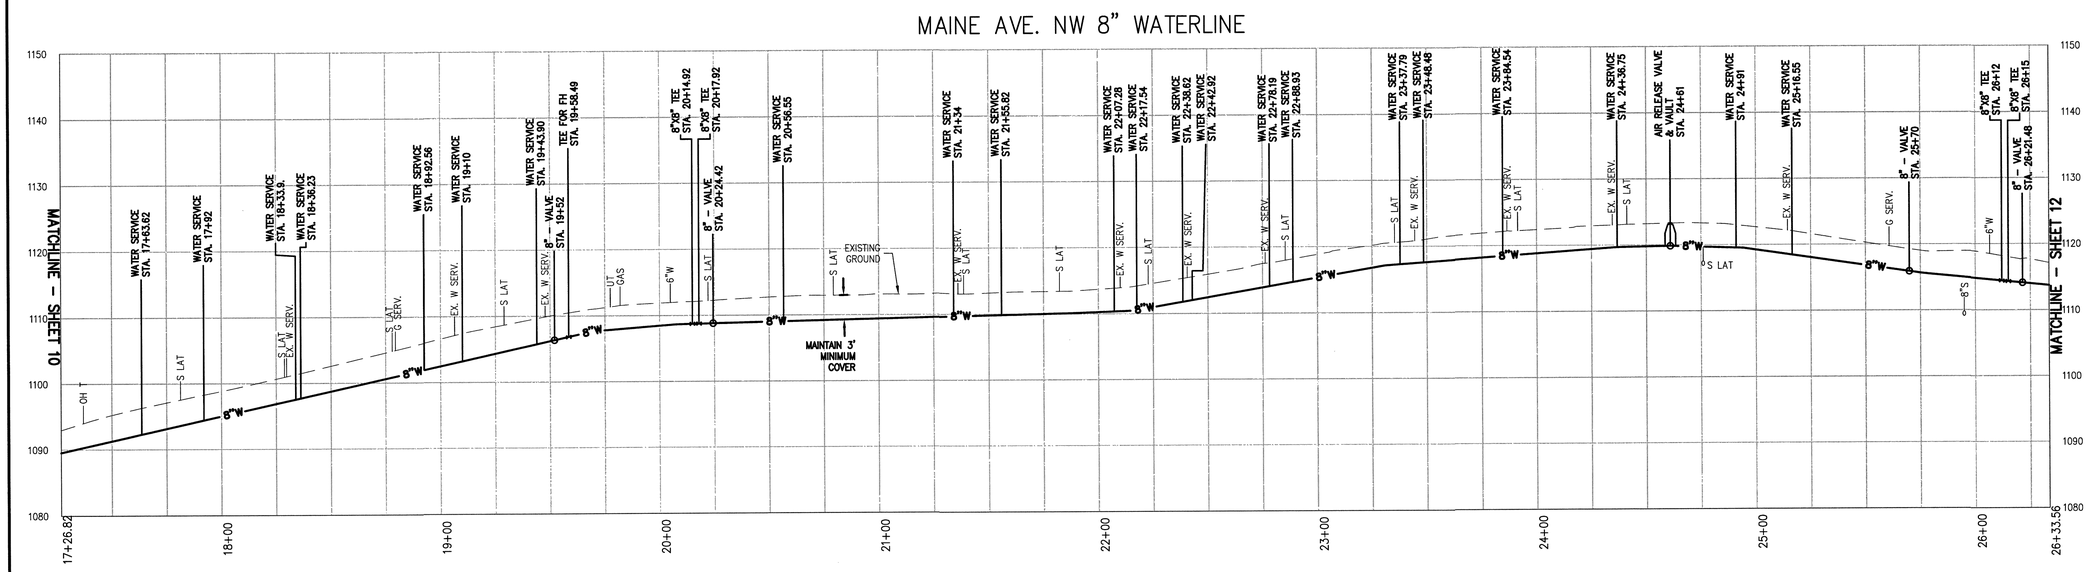

SEE SHEETS 13 & 14 FOR MONROE ST. NW AND VAN BUREN ST. NW PROFILES

SCALE: 1" = 30'

CONSULTING ENGINEER STATE OF VIRGINIA RYAN P. KINCER Lic. No. 50119 4/30/21 PROFESSIONAL ENGINEER

Revisions	Date

Issue Date: APR. 30, 2021

Drawn By: RPK/MLC

Designed By: RPK

Checked By: BCC

Date: 4/30/21

Mattern & Craig ENGINEERS•SURVEYORS
701 FIRST STREET, S.W.
ROANOKE, VIRGINIA 24016
(540) 345-9342
FAX (540) 345-7891

WASHINGTON HEIGHTS WATERLINE REPLACEMENT PHASE 1

PLAN AND PROFILE – MAINE AVE NW WATERLINE

ROANOKE, VIRGINIA

Vertical Scale: 1"=10'

Horizontal Scale: 1"=30'

Commission Number: 4095

Sheet No.: 11

I:\4095 - Washington Heights Waterline Replacement\Dwg\4095 Design PH1 V2.dwg, 4/30/2021 3:32:04 PM, MLC