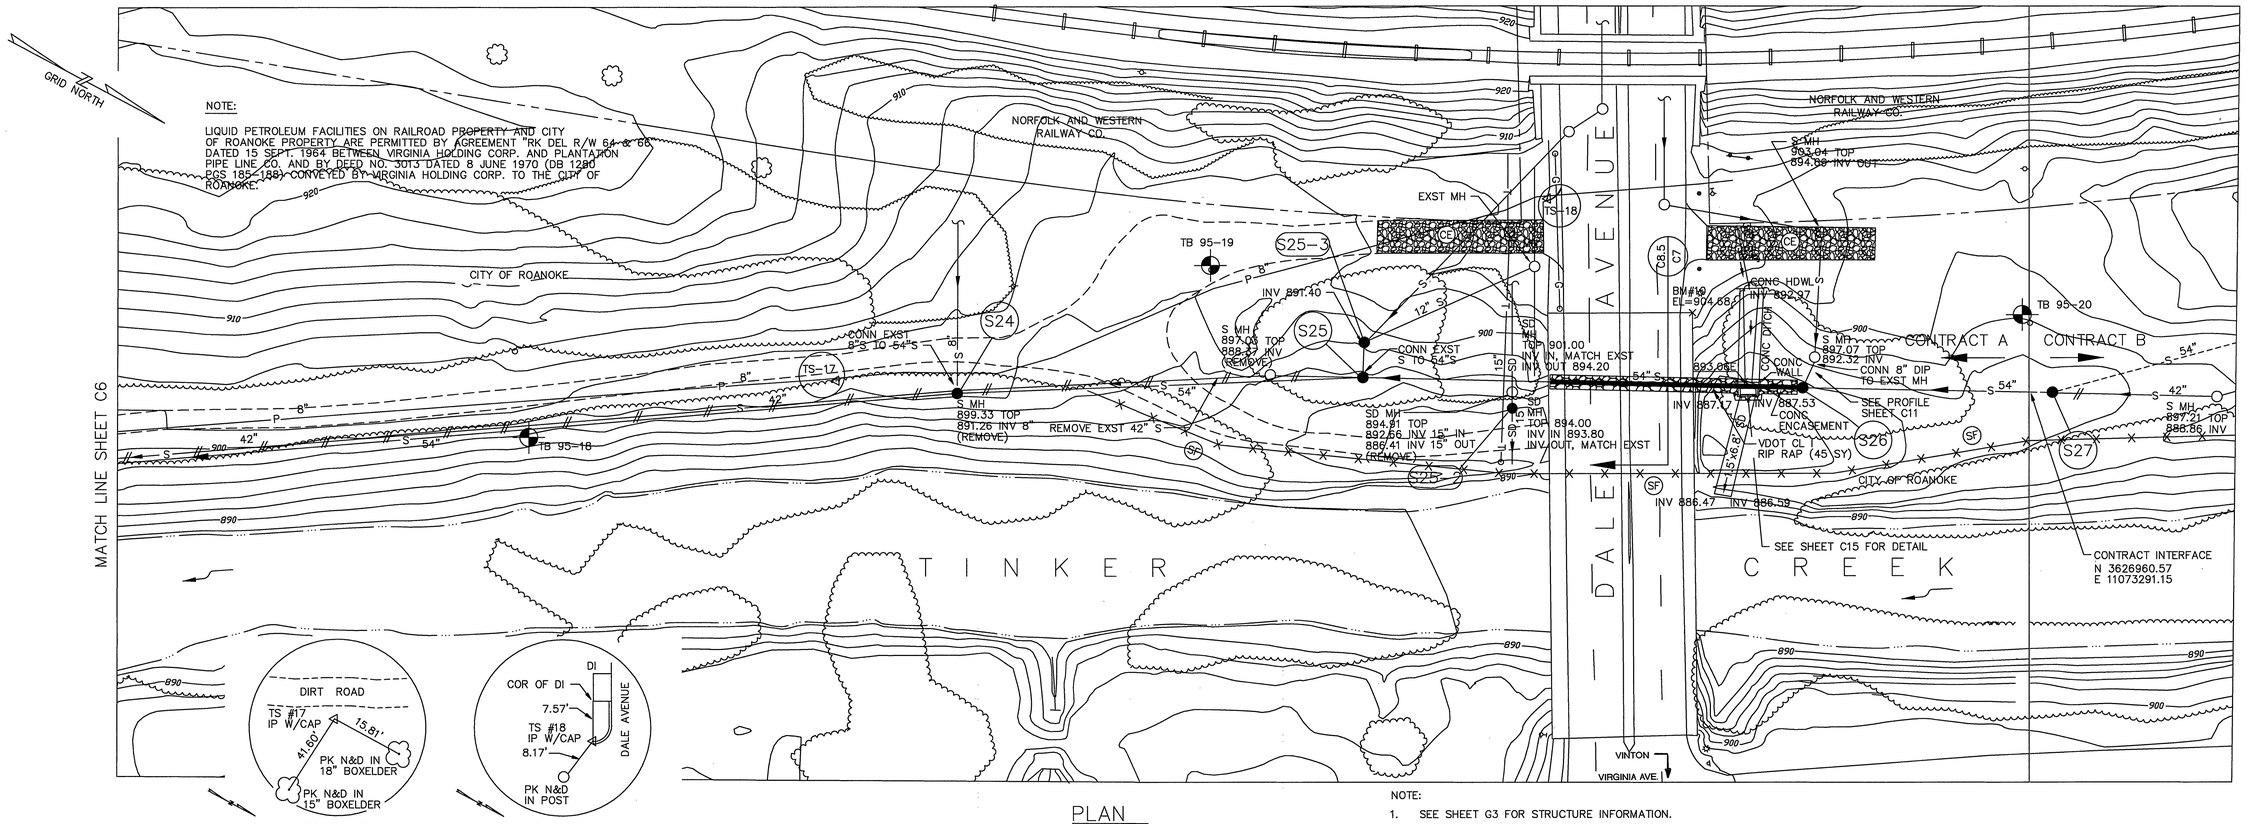

PLAN
SCALE: 1"=30'

NOTE:
1. SEE SHEET G3 FOR STRUCTURE INFORMATION.

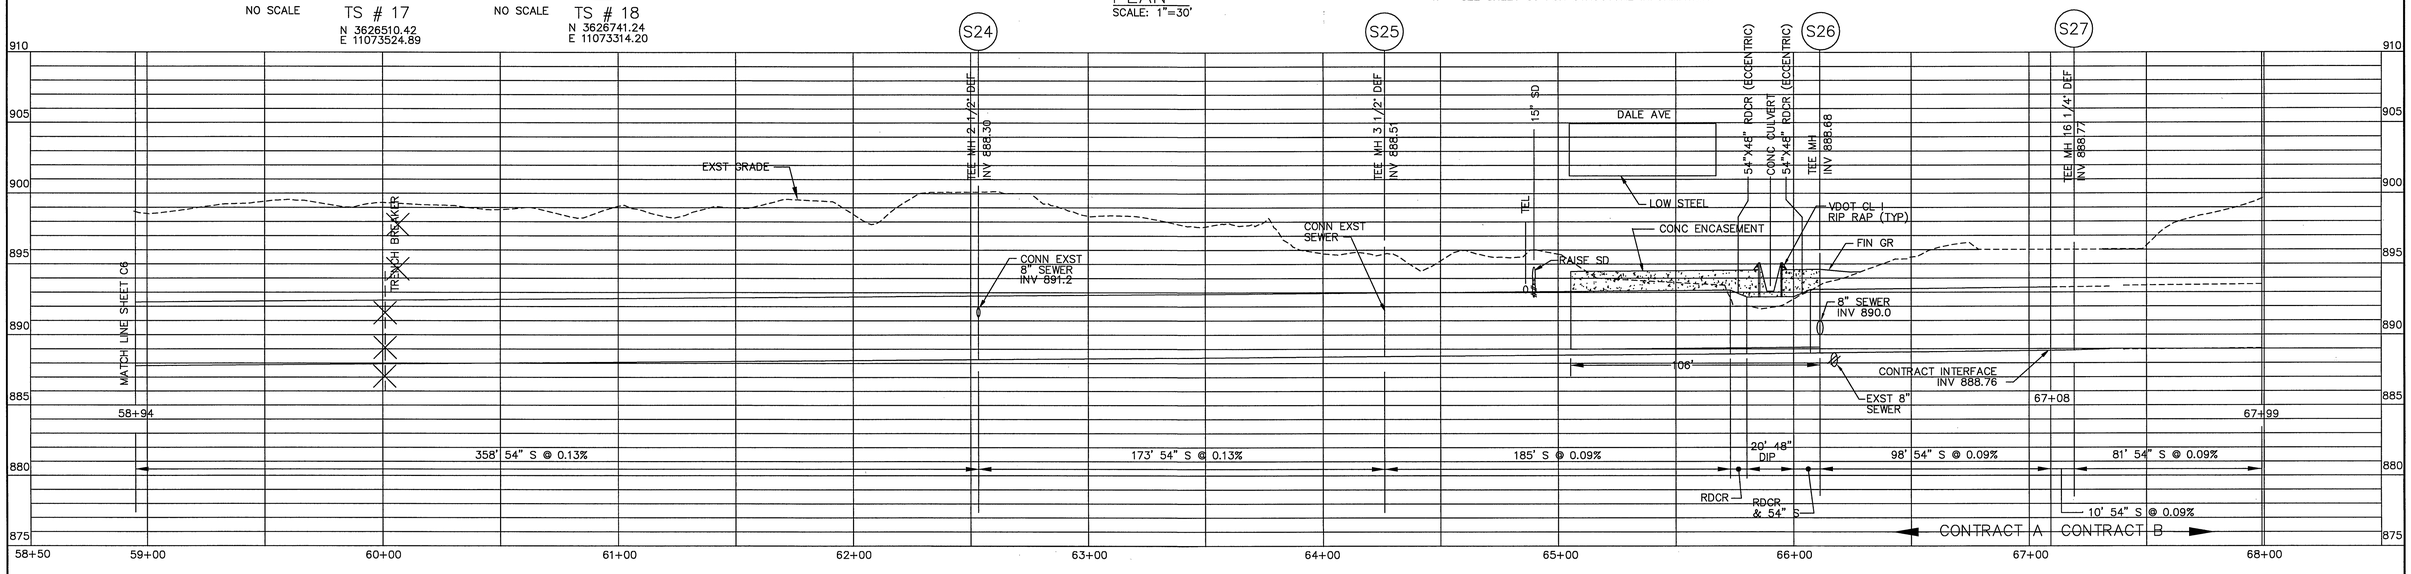

HAYES, SEAY, MATTERN & MATTERN, INC.
ARCHITECTS/ENGINEERS/PLANNERS
ROANOKE, VIRGINIA

DESIGNED: DMH
DRAWN: MHL
CHECKED:
APPROVED:

REVISIONS

DATE	BY	DESCRIPTION
10/15/98	MNH	RECORD DRAWINGS SEE SHEET G1 FOR NOTE

GRAPHIC SCALES
VERTICAL 1" = 5' (5' 0 5' 10')
HORIZONTAL 1" = 30' (30' 15' 0 30' 60')

TINKER CREEK INTERCEPTOR SEWER
CITY OF ROANOKE, VIRGINIA

PLAN AND PROFILE
STA 58+94 TO STA 67+08

COMM. NO.: 7211 | SCALE: AS NOTED | DATE: MAY 17, 1996

PROJECT NO.: 6317
CONTRACT A
SHEET NO.
C7
RECORD DRAWINGS

7211C7A C7211 26FE97 REV. G ACAD MNH PLOT SCALE: 1=30 XREF: -118'00'00"