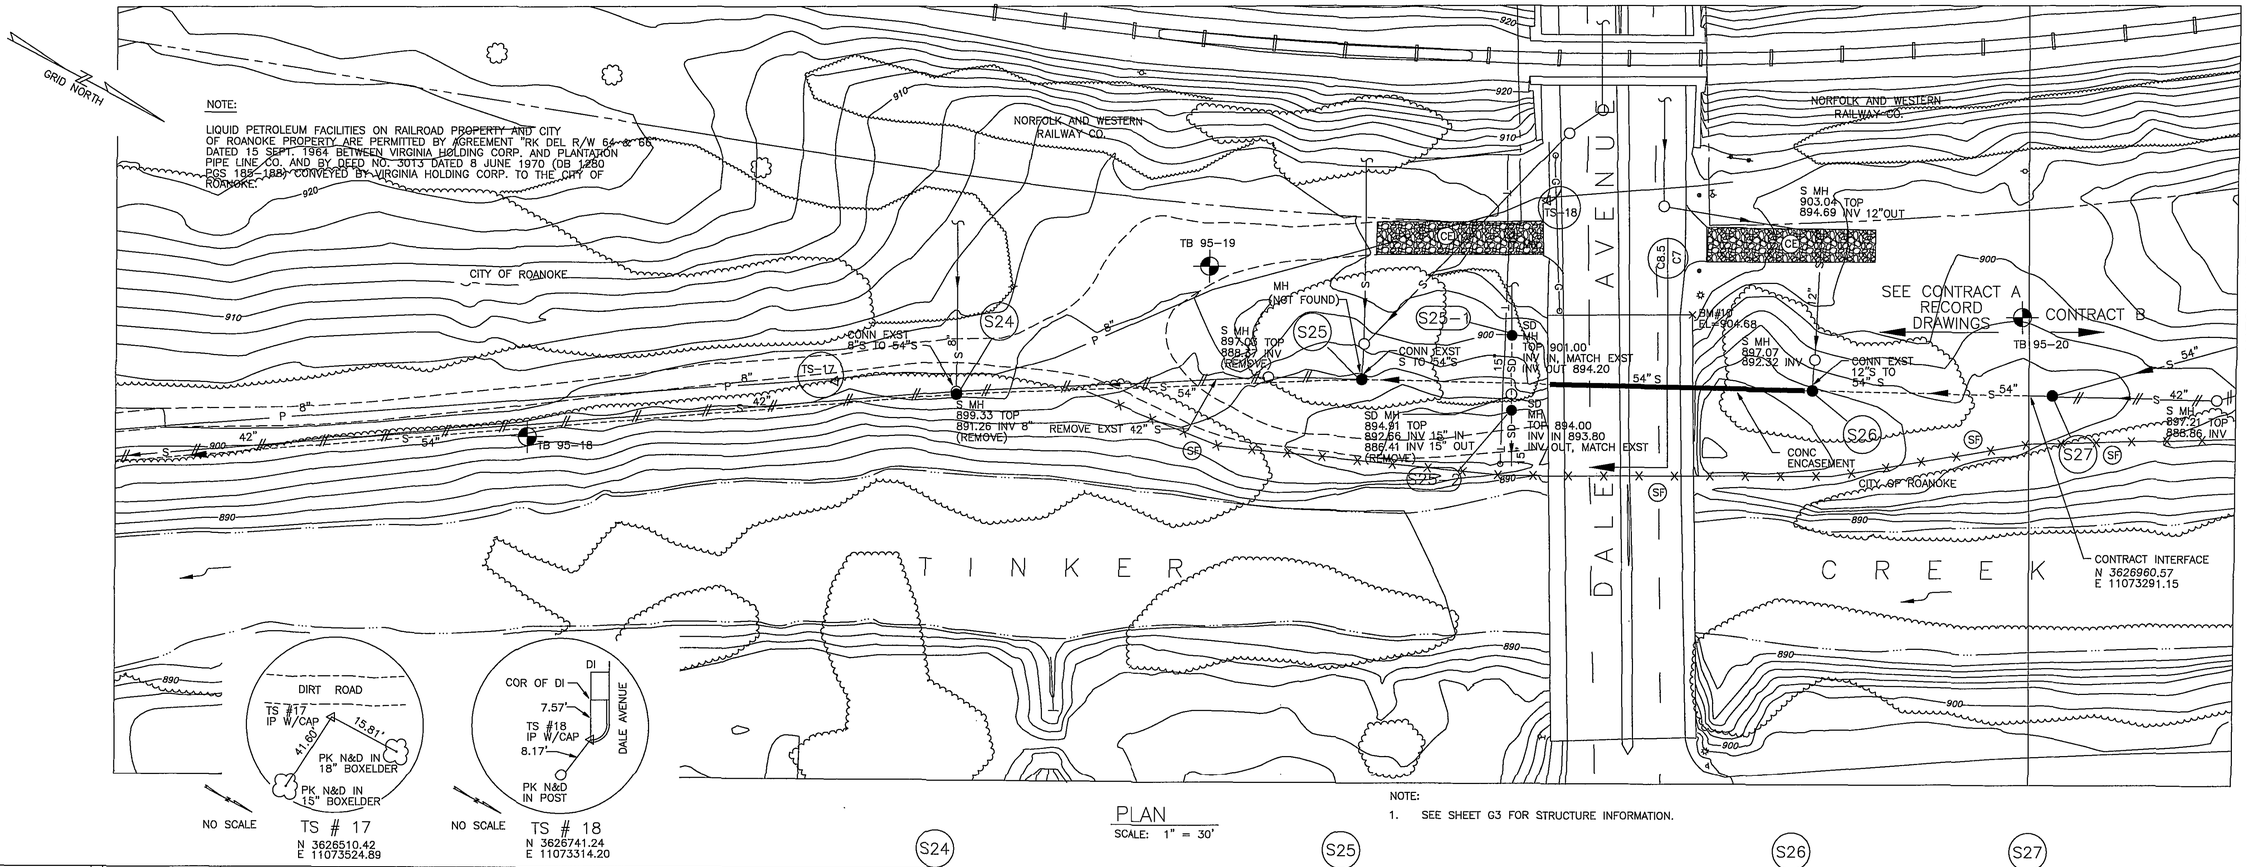

PLAN
SCALE: 1" = 30'

NOTE:
1. SEE SHEET G3 FOR STRUCTURE INFORMATION.

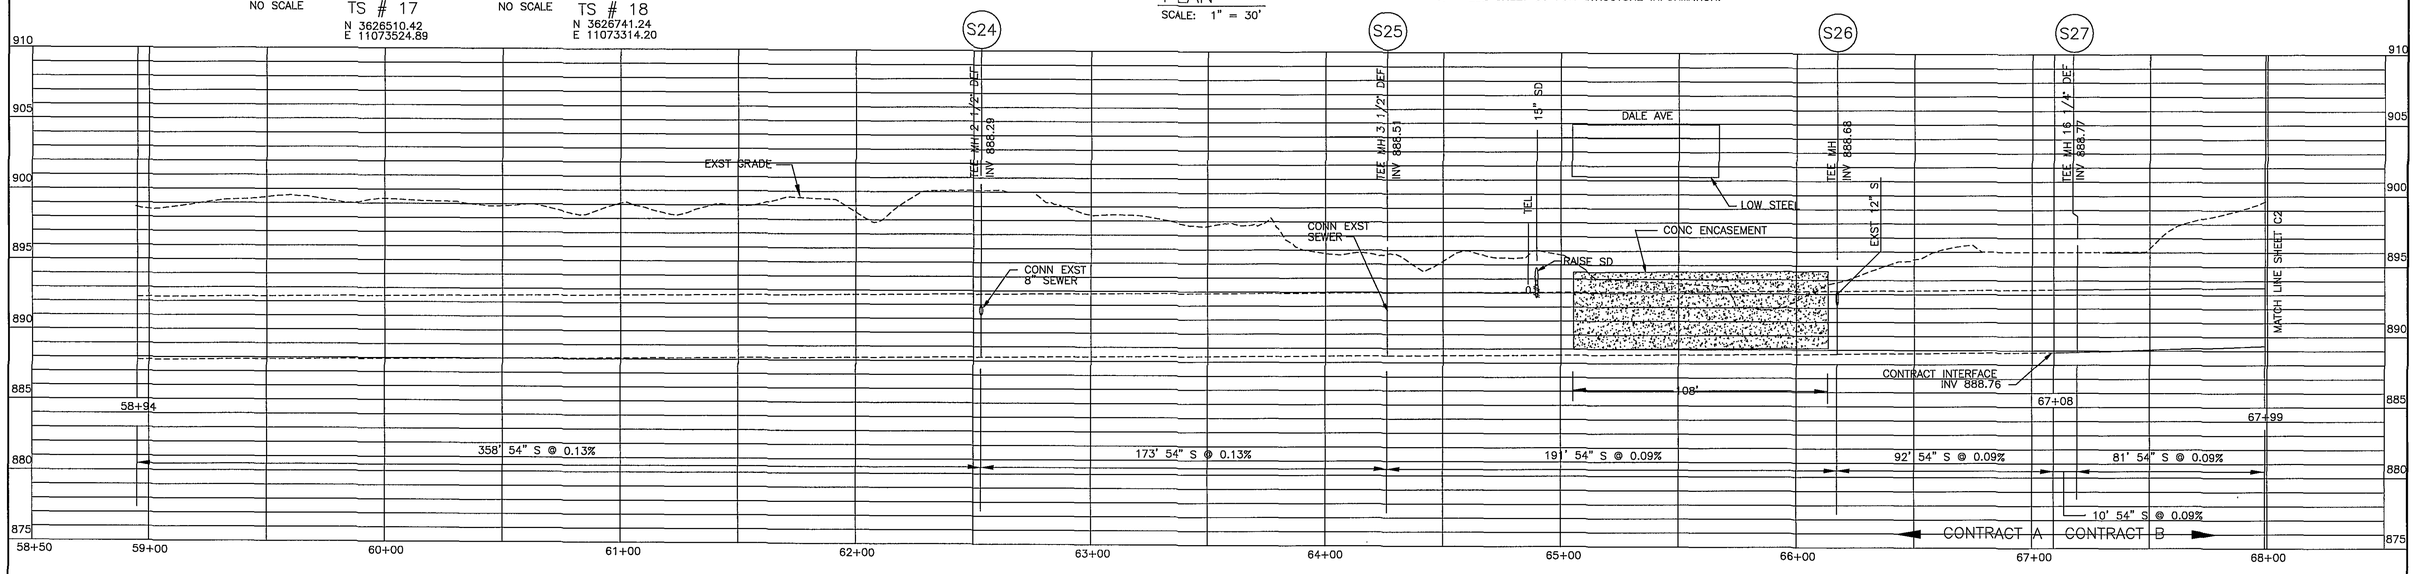

HAYES, SEAY, MATTERN & MATTERN, INC.
ARCHITECTS/ENGINEERS/PLANNERS
ROANOKE, VIRGINIA

DESIGNED:	DMH
DRAWN:	MHL
CHECKED:	
APPROVED:	

REVISIONS

DATE	BY	DESCRIPTION
10/15/98	MNH	RECORD DRAWINGS SEE SHEET G1 FOR NOTE

GRAPHIC SCALES
VERTICAL 1" = 5' 5' 0 5' 10'
HORIZONTAL 1" = 30' 30' 15' 0 30' 60'

TINKER CREEK INTERCEPTOR SEWER
CITY OF ROANOKE, VIRGINIA

PLAN AND PROFILE
STA 67+08 TO STA 67+99

COMM. NO.: 7211 | SCALE: AS NOTED | DATE: MAY 17, 1996

PROJECT NO.: 6317
CONTRACT B
SHEET NO.
C1
RECORD DRAWINGS

7211C1B C7211 15MY96 REV. F ACAD MNH PLOT SCALE: 1=30 XREF: -118°00'00"