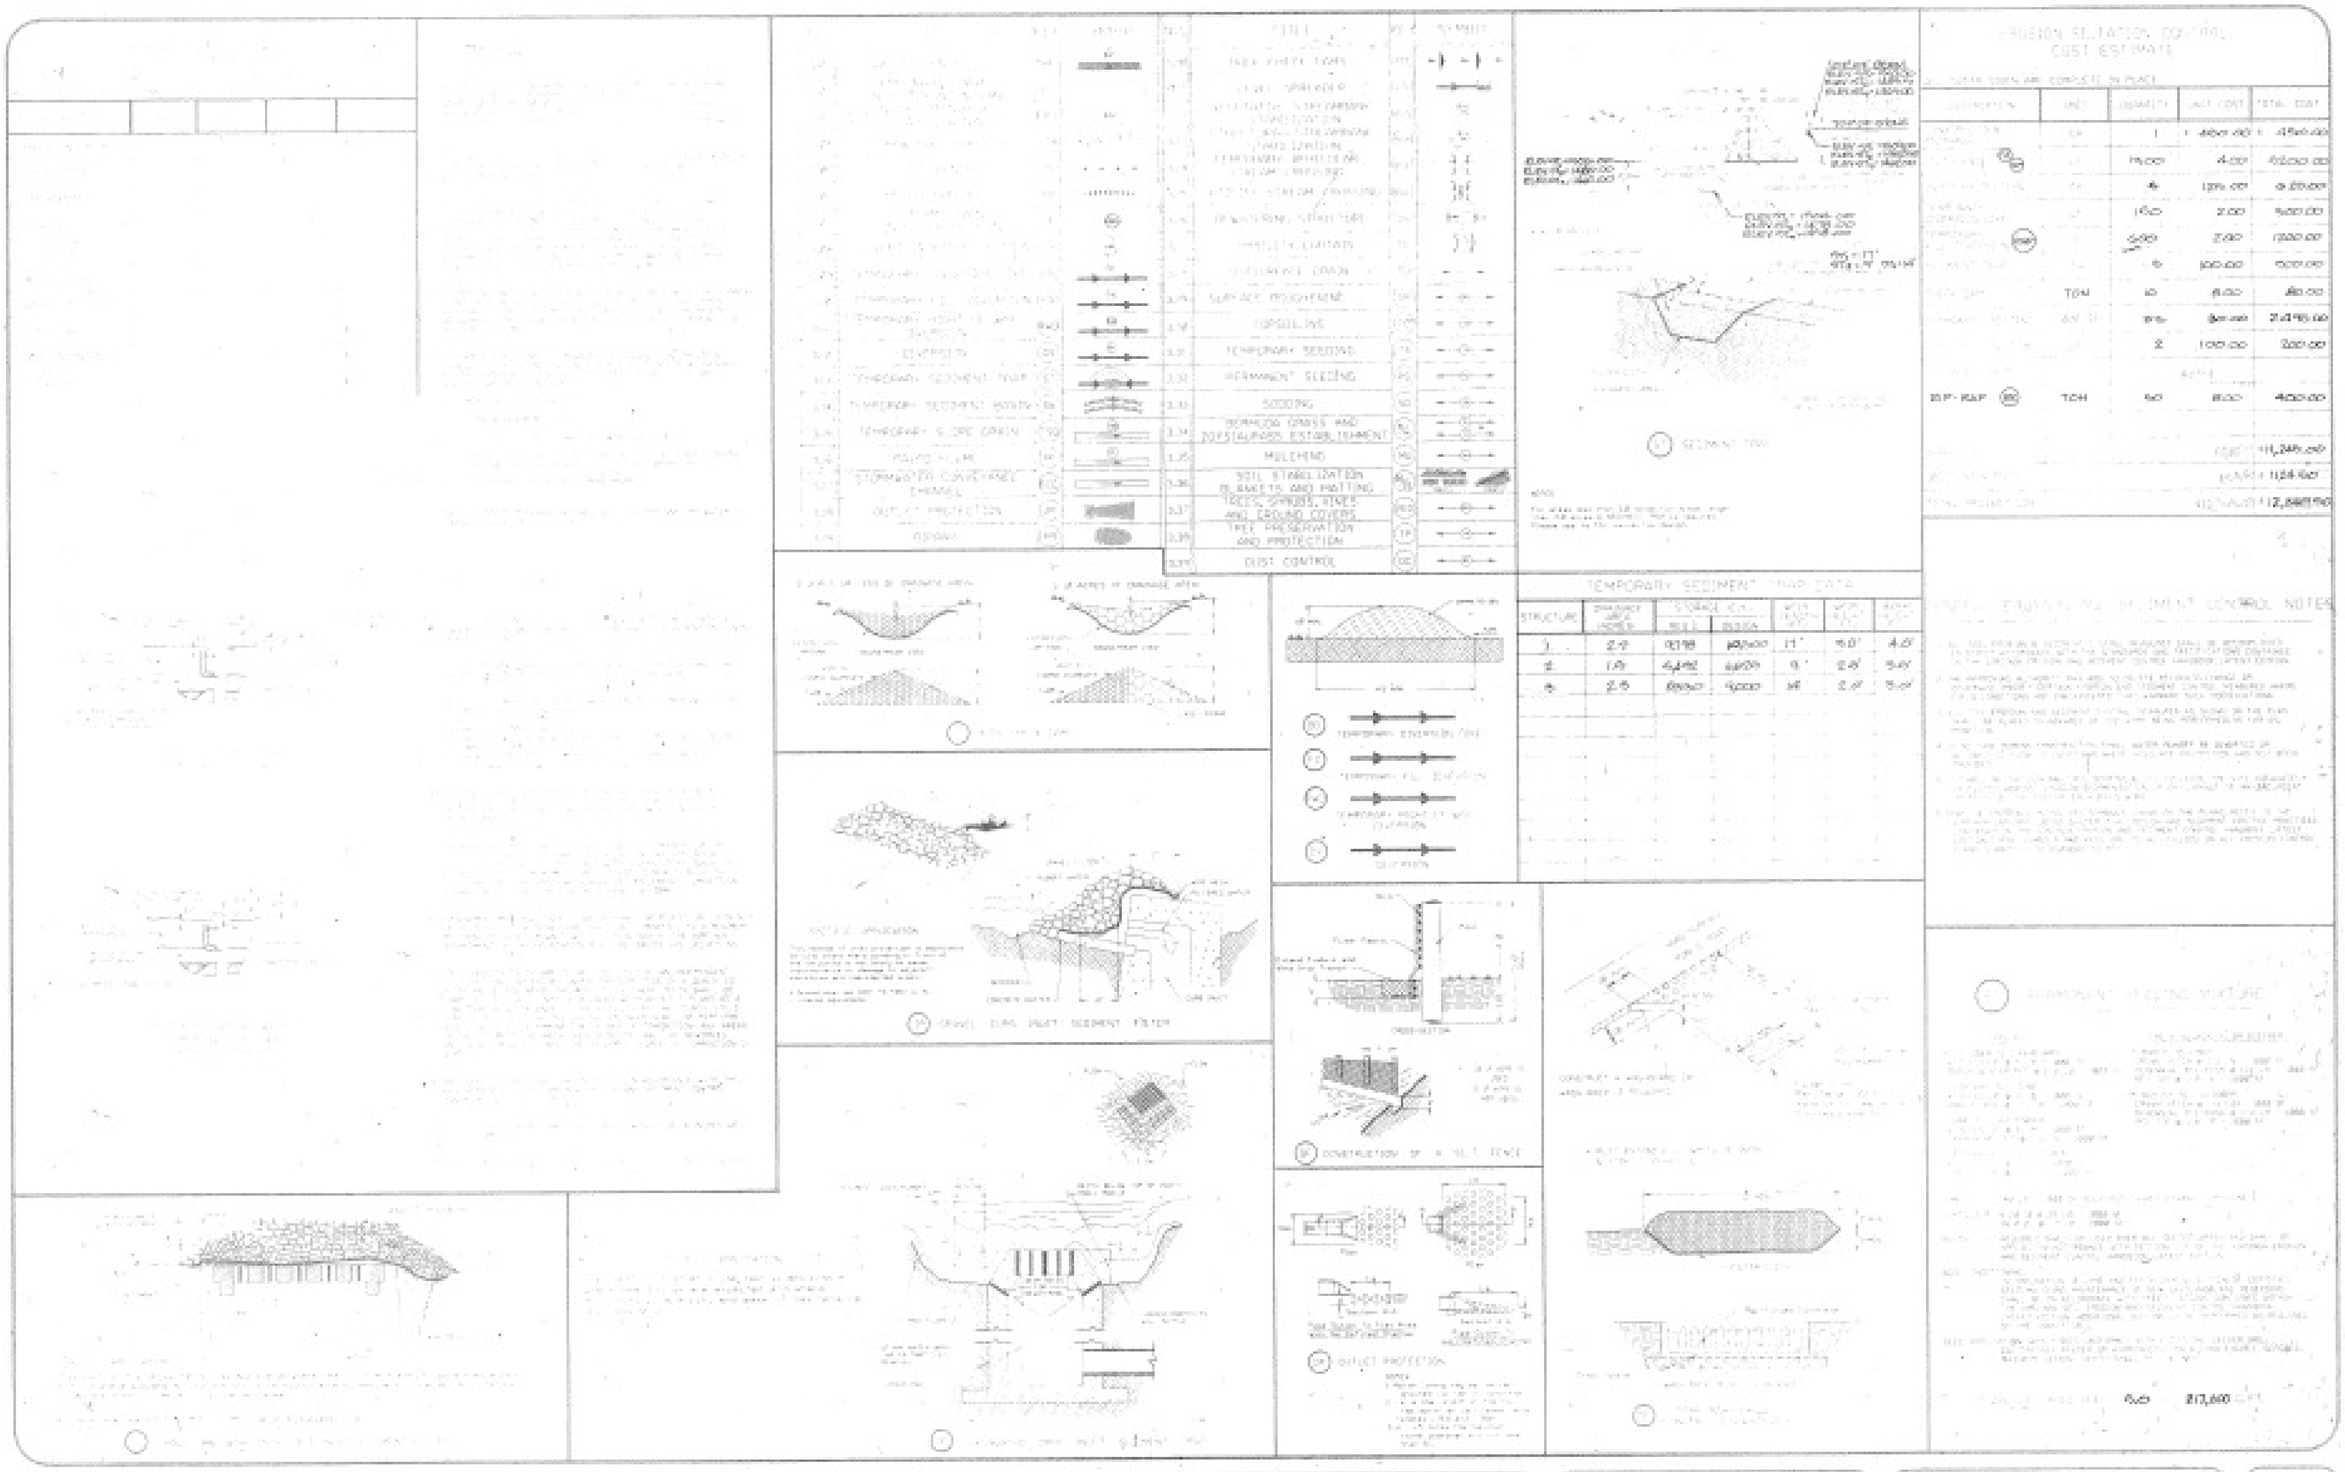
EROSION SEDIMENTATION CONTROL
COST ESTIMATE
TEMPORARY SEDIMENT TRAP DATA
SEDIMENT CONTROL NOTES
SURFACE ROUGHENING
TOPSOIL
TEMPORARY SEEDING
PERMANENT SEEDING
SODDING
MULCHING
DUST CONTROL
TEMPORARY SEDIMENT TRAP
TEMPORARY SLOPE DRAIN
STORMWATER CONVEYANCE CHANNEL
OUTLET PROTECTION
DIVERSION
CONSTRUCTION OF A SILT FENCE
OUTLET PROTECTION
TEMPORARY DIVERSION DIKE
TEMPORARY PIPE DIVERSION
DIVERSION
TOH
TON
EP-RAP
WEXFORD PHASE I
CITY OF ROANOKE
AS BUILT
7
8
J.N. 97199
RC-5344