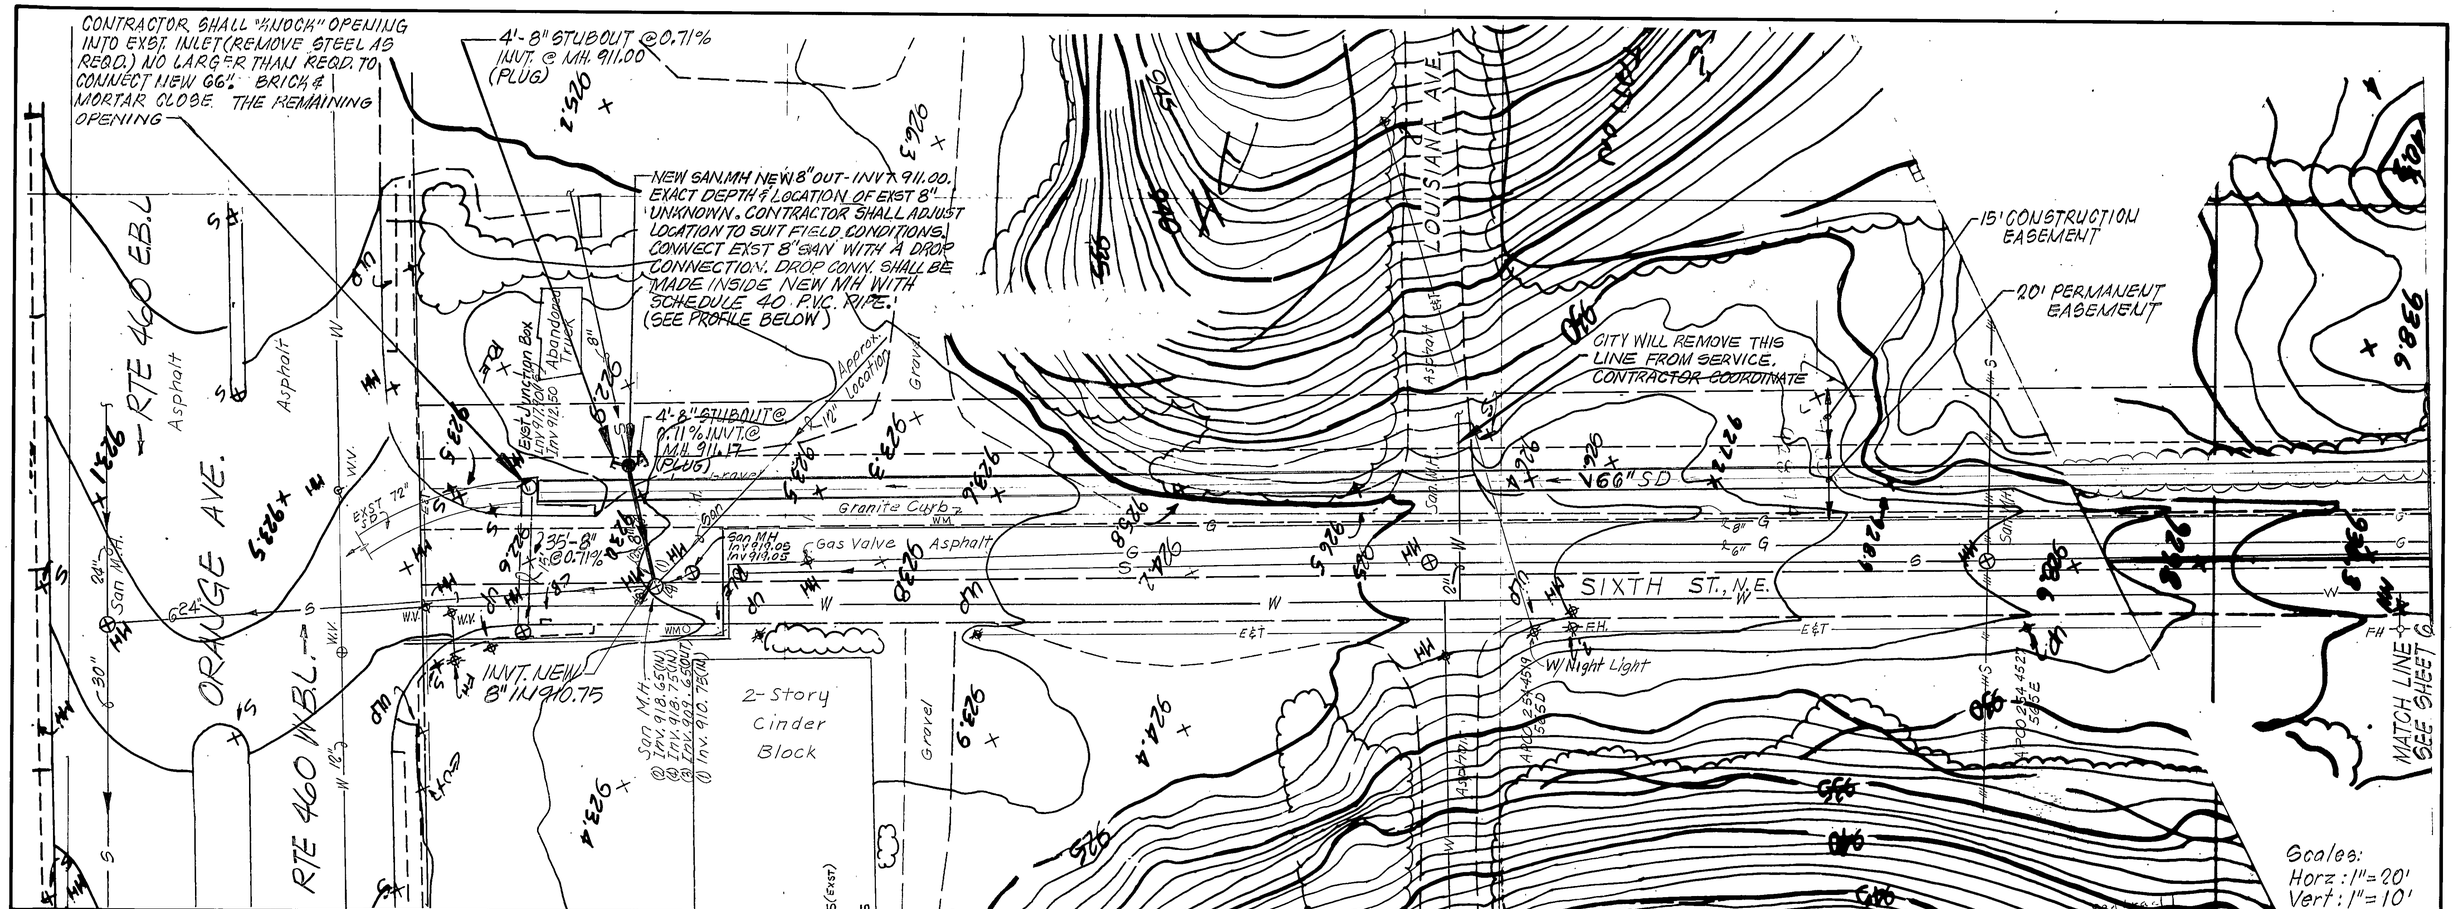

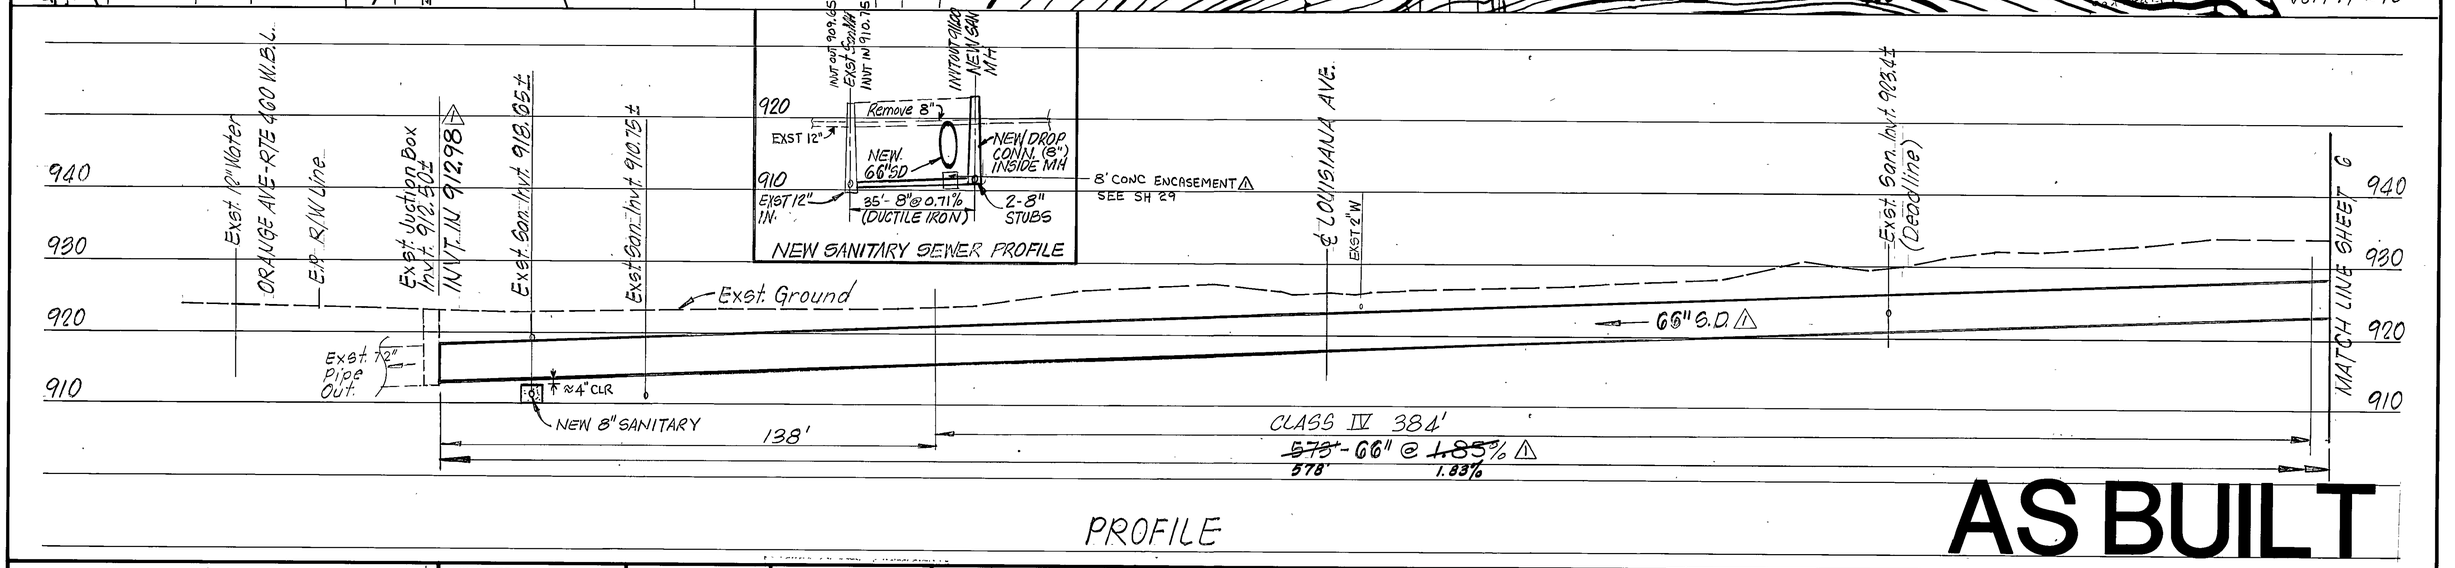

AS BUILT

Mattern & Craig
CONSULTING ENGINEERS
SUITE 401 707 S. JEFFERSON STREET ROANOKE VIRGINIA 24011 (703) 345-9342

DESIGNED: DRM
CHECKED: CJG
APPROVED: SWH

NORTH

REVISION	DATE	DESCRIPTION	BY	APP.
△	10-19-83	PER CHANGE ORDER NO. 1		SWH

DATE JULY 1983
COMM. 428

WILLIAMSON ROAD STORM DRAIN - PHASE 1
CONTRACT I-A
ROANOKE, VIRGINIA

PLAN AND PROFILE

SHEET 5

5825 I-A