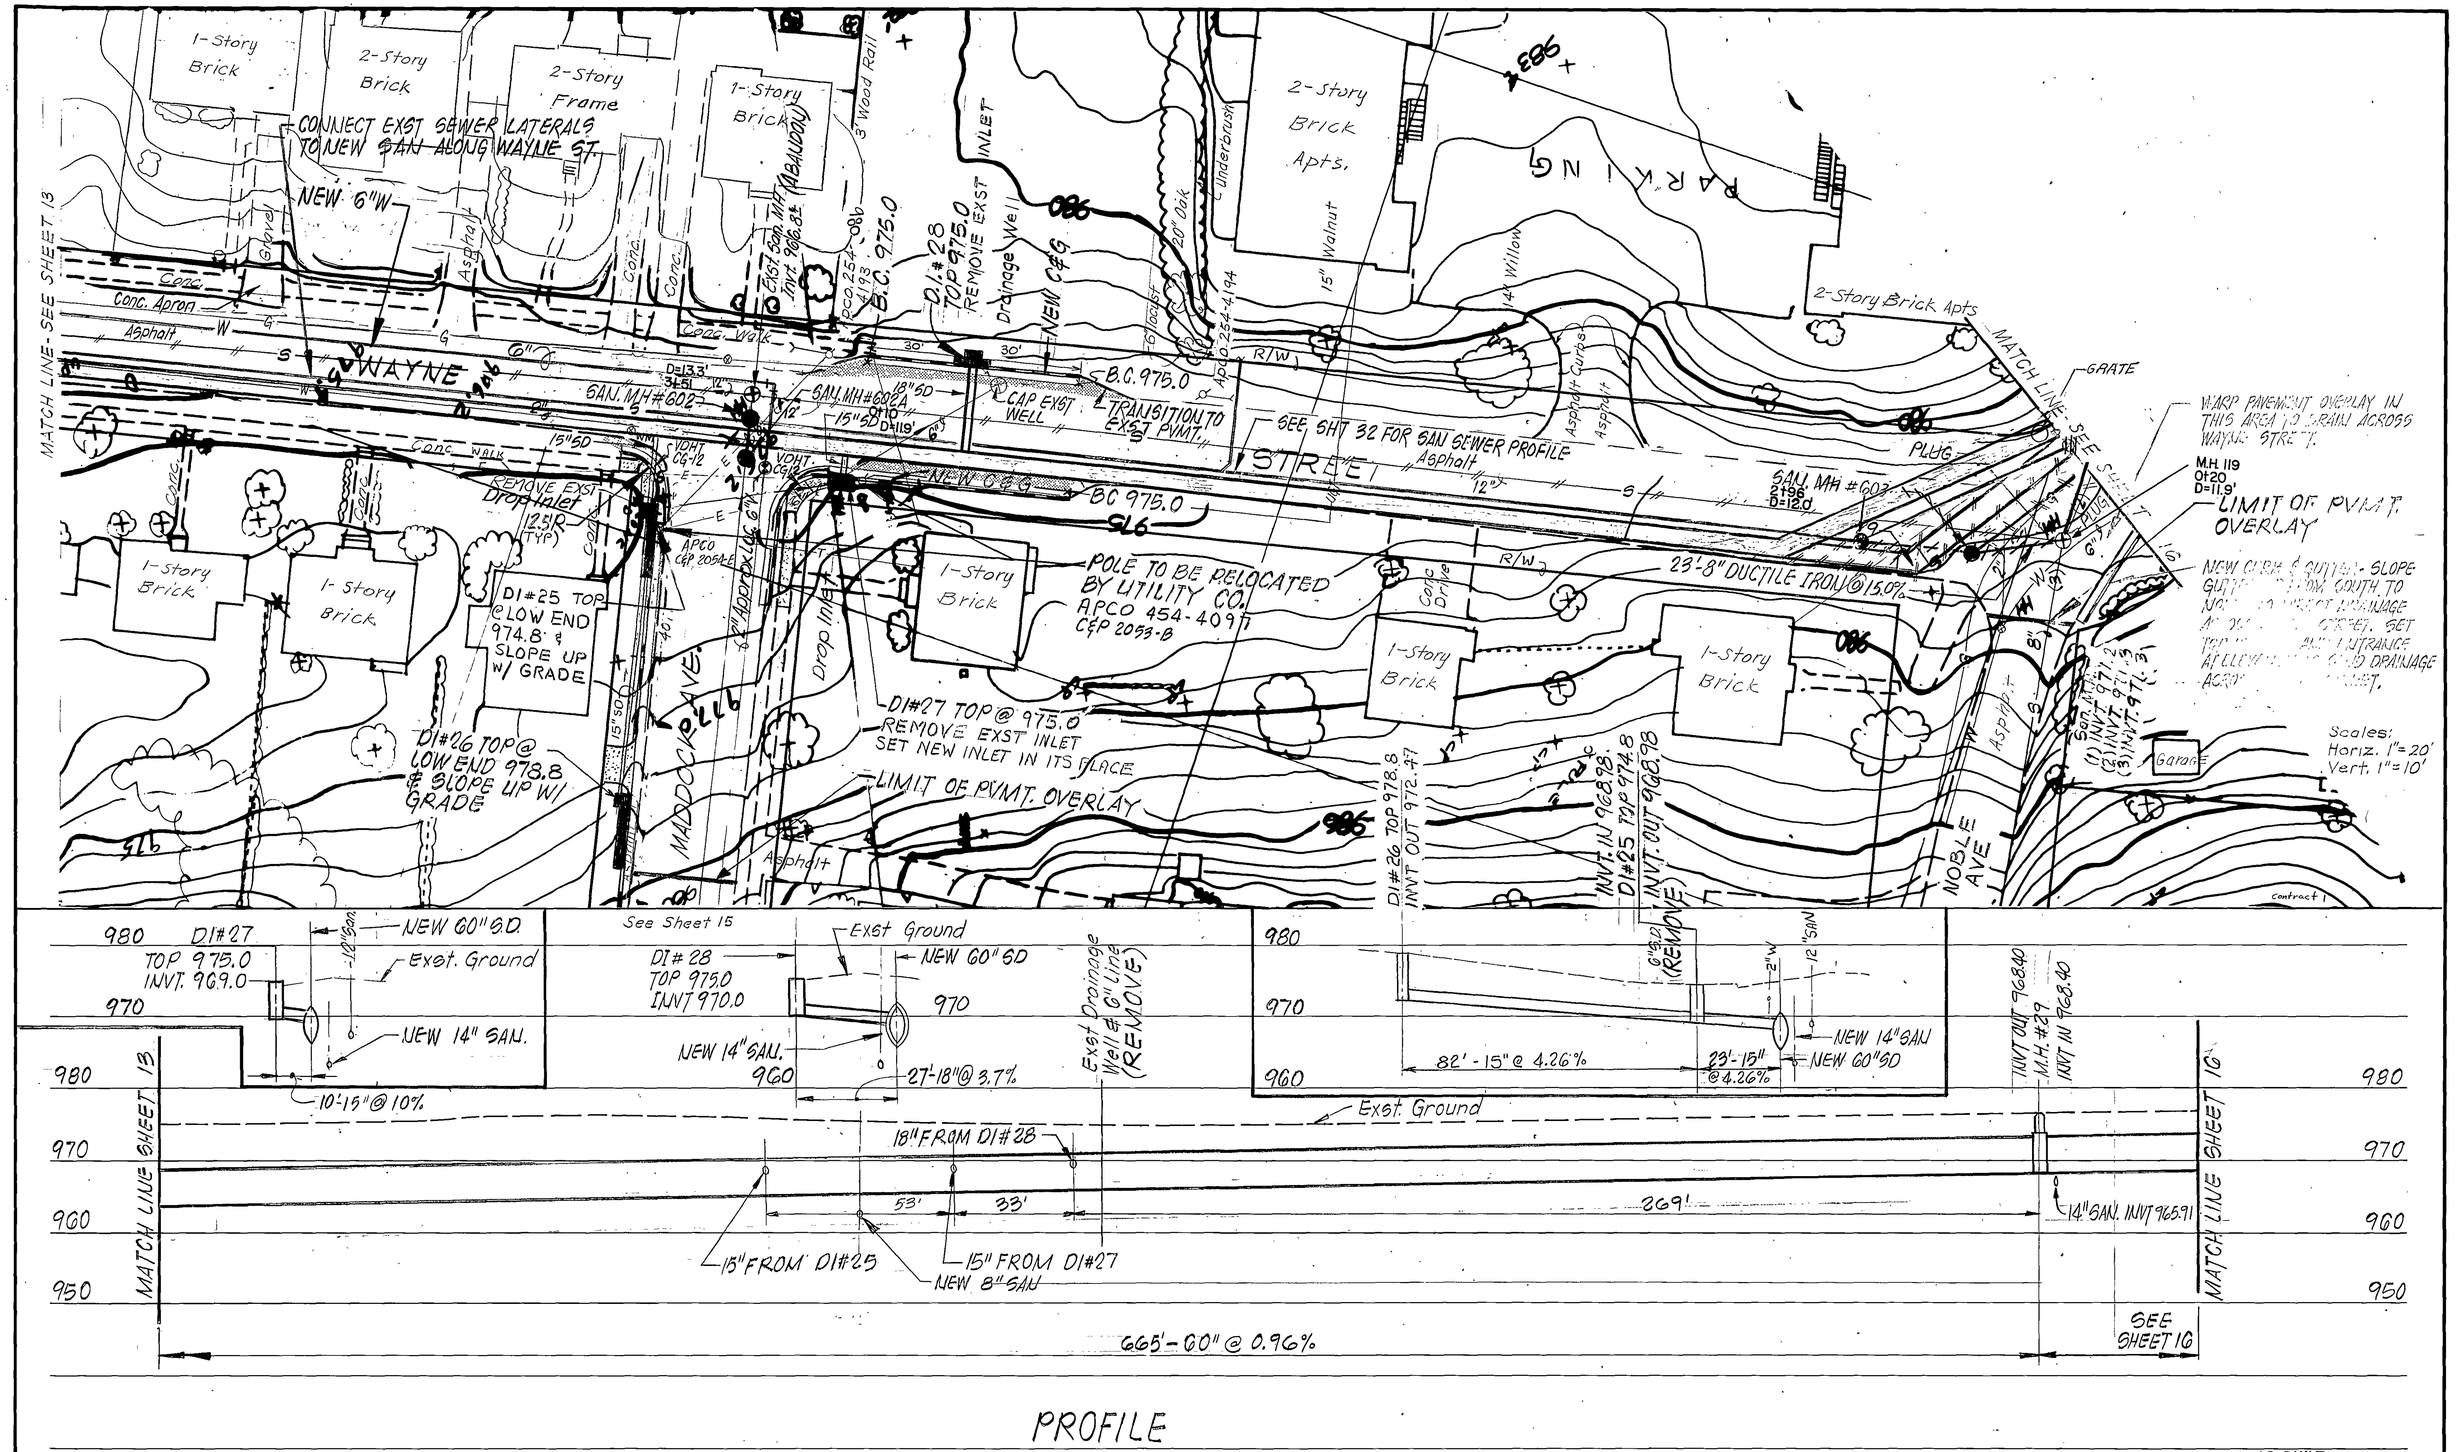

PROFILE

AS-BUILT

Mattern & Craig
CONSULTING ENGINEERS
SUITE 401 707 S JEFFERSON STREET ROANOKE VIRGINIA 24011 (703) 345-9342

DESIGNED: CAT
CHECKED: Smith
APPROVED: Smith

COMMONWEALTH OF VIRGINIA
STEWART W. HUBBELL
No. 07420
PROFESSIONAL ENGINEER

NORTH

REVISION	DATE	DESCRIPTION	BY	APP.
1	3-15-85	REV. SAN & SD	CAT	Smith
2	11-10-86	RECORD DRAWINGS	JD	Smith

DATE
JULY 1983
COMM. 428

WILLIAMSON ROAD STORM DRAIN - PHASE 1
CONTRACT I
ROANOKE, VIRGINIA

PLAN AND PROFILE

SHEET 14