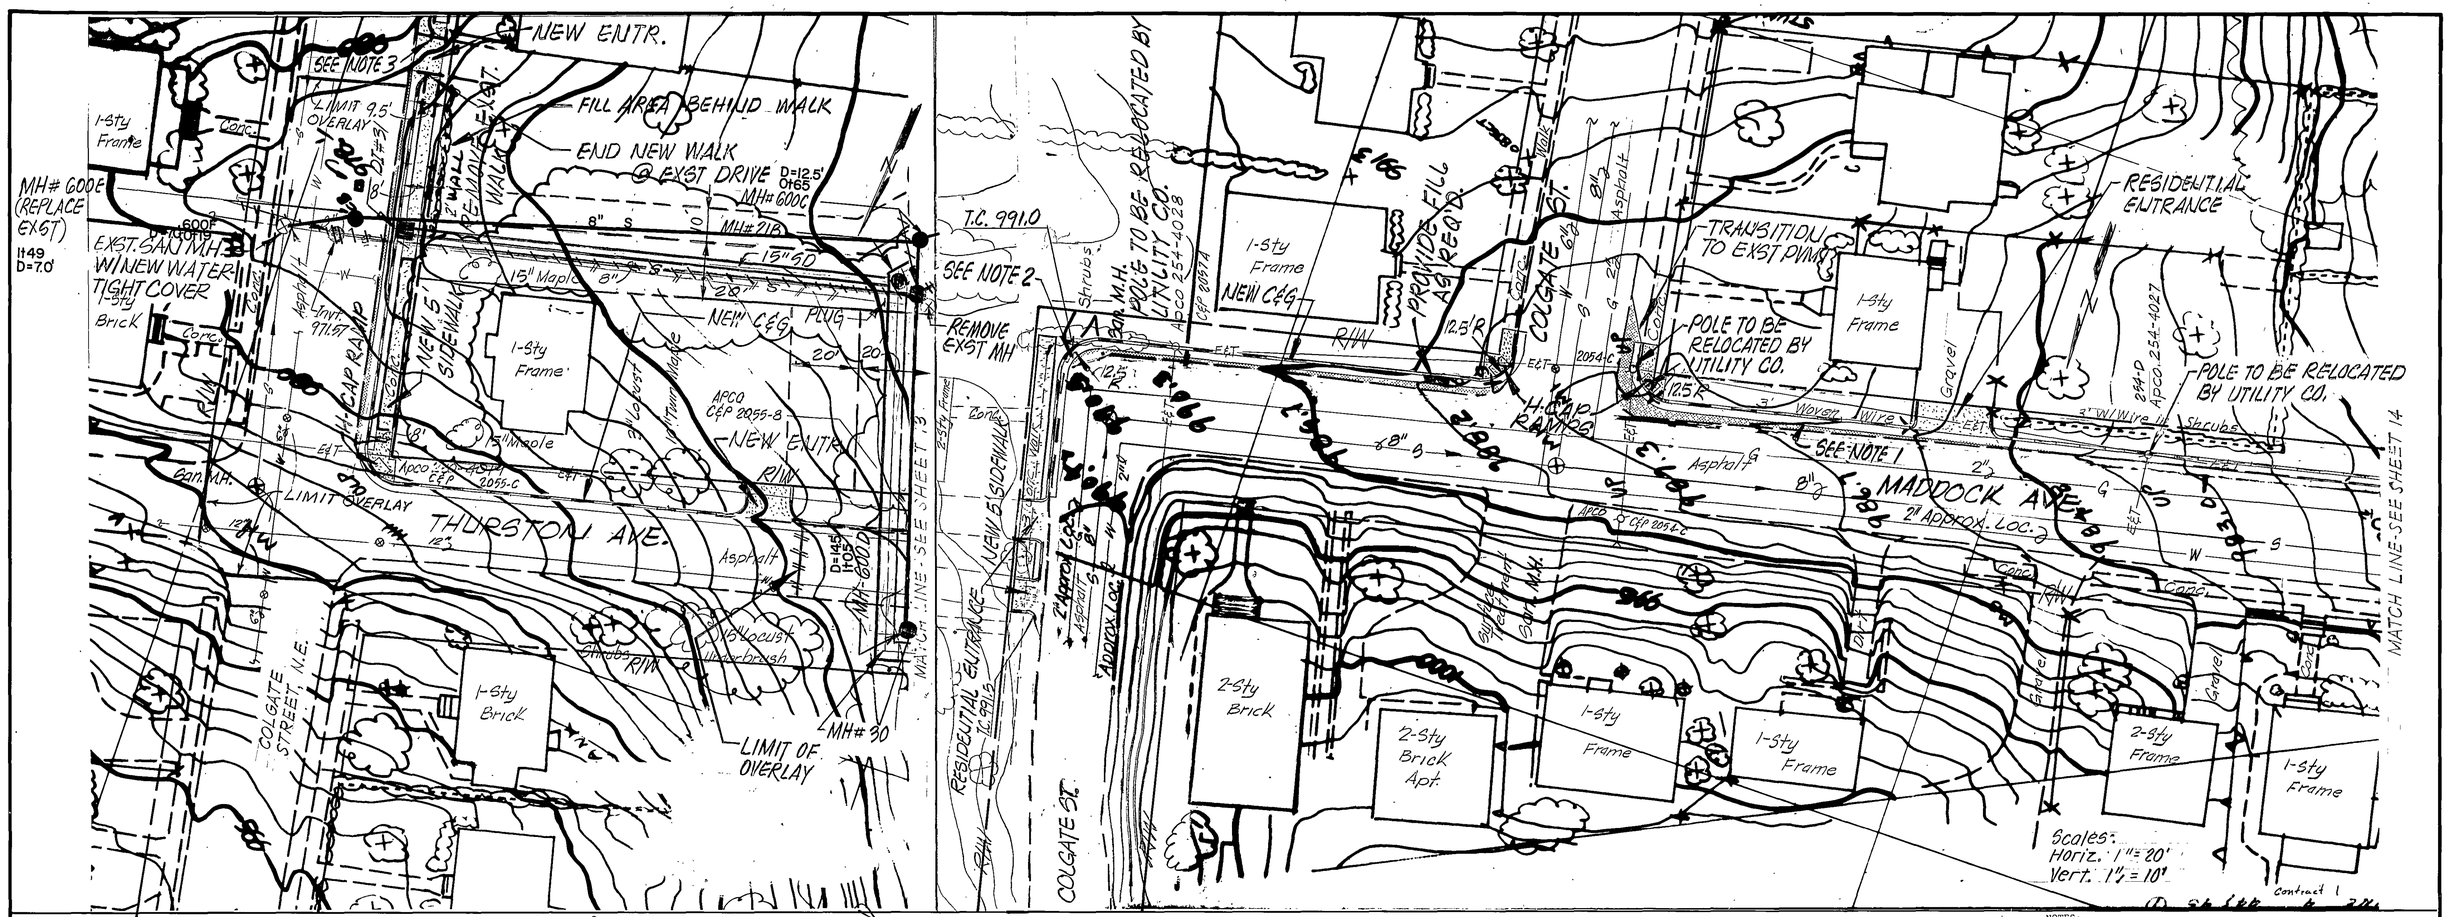

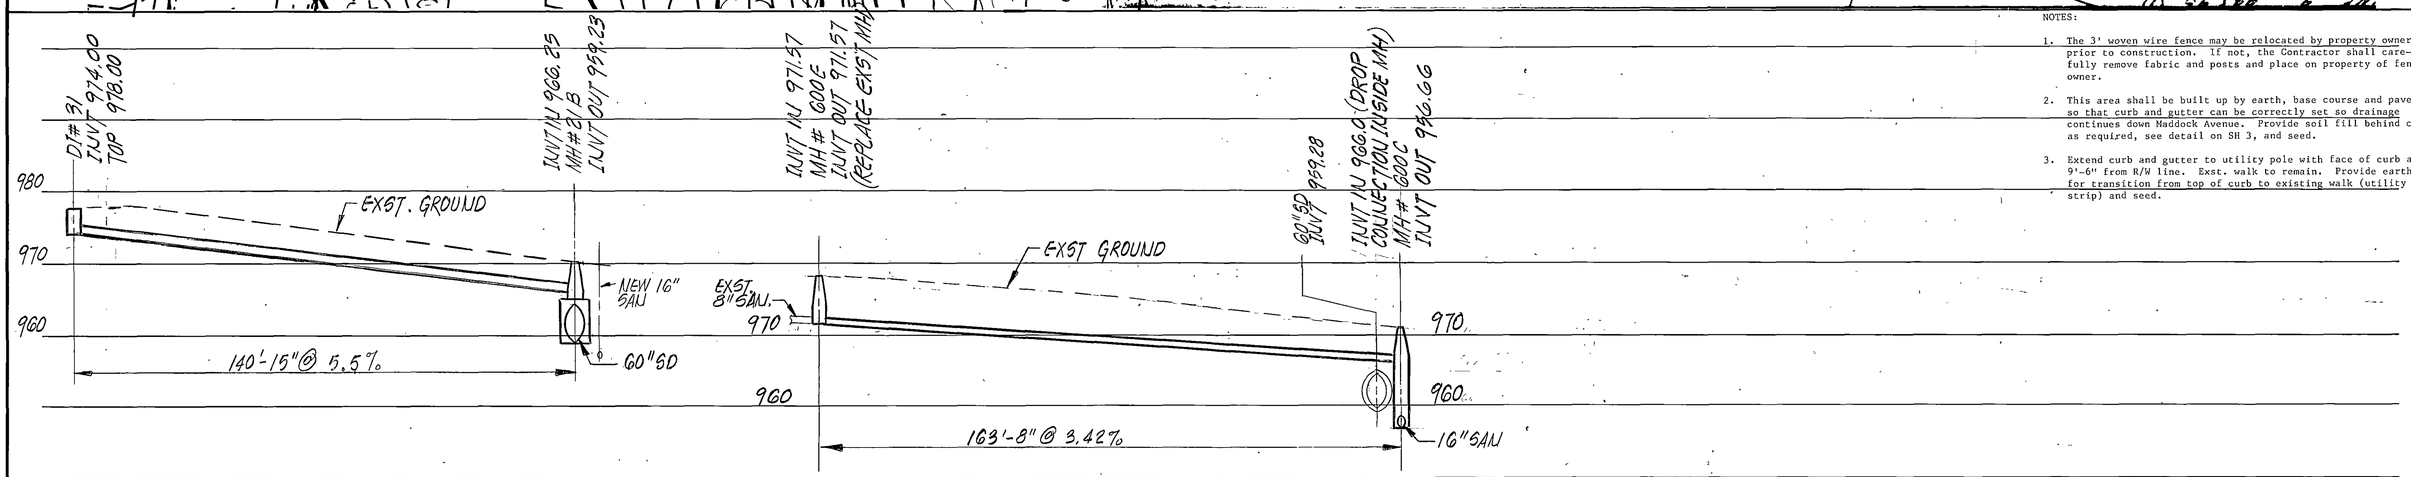

NOTES:

1. The 3' woven wire fence may be relocated by property owner prior to construction. If not, the Contractor shall carefully remove fabric and posts and place on property of fence owner.
2. This area shall be built up by earth, base course and pavement so that curb and gutter can be correctly set so drainage continues down Maddock Avenue. Provide soil fill behind curb as required, see detail on SH 3, and seed.
3. Extend curb and gutter to utility pole with face of curb at 9'-6" from R/W line. Exst. walk to remain. Provide earth for transition from top of curb to existing walk (utility strip) and seed.

AS-BUILT

Mattern & Craig
CONSULTING ENGINEERS
SUITE 401 707 S JEFFERSON STREET ROANOKE VIRGINIA 24011 (703) 345-9342

DESIGNED: CAT
CHECKED:
APPROVED:

COMMONWEALTH OF VIRGINIA
STEWART W. HUBBELL
No. 07420
PROFESSIONAL ENGINEER

NORTH

REVISION	DATE	DESCRIPTION	BY	APP.
1	3-15-85	REV. SAN & SD		
2	11-10-86	RECORD DRAWINGS	JD	

DATE
JULY 1983
COMM. 428

WILLIAMSON ROAD STORM DRAIN - PHASE 1
CONTRACT I
ROANOKE, VIRGINIA

PLAN AND PROFILE

SHEET 15