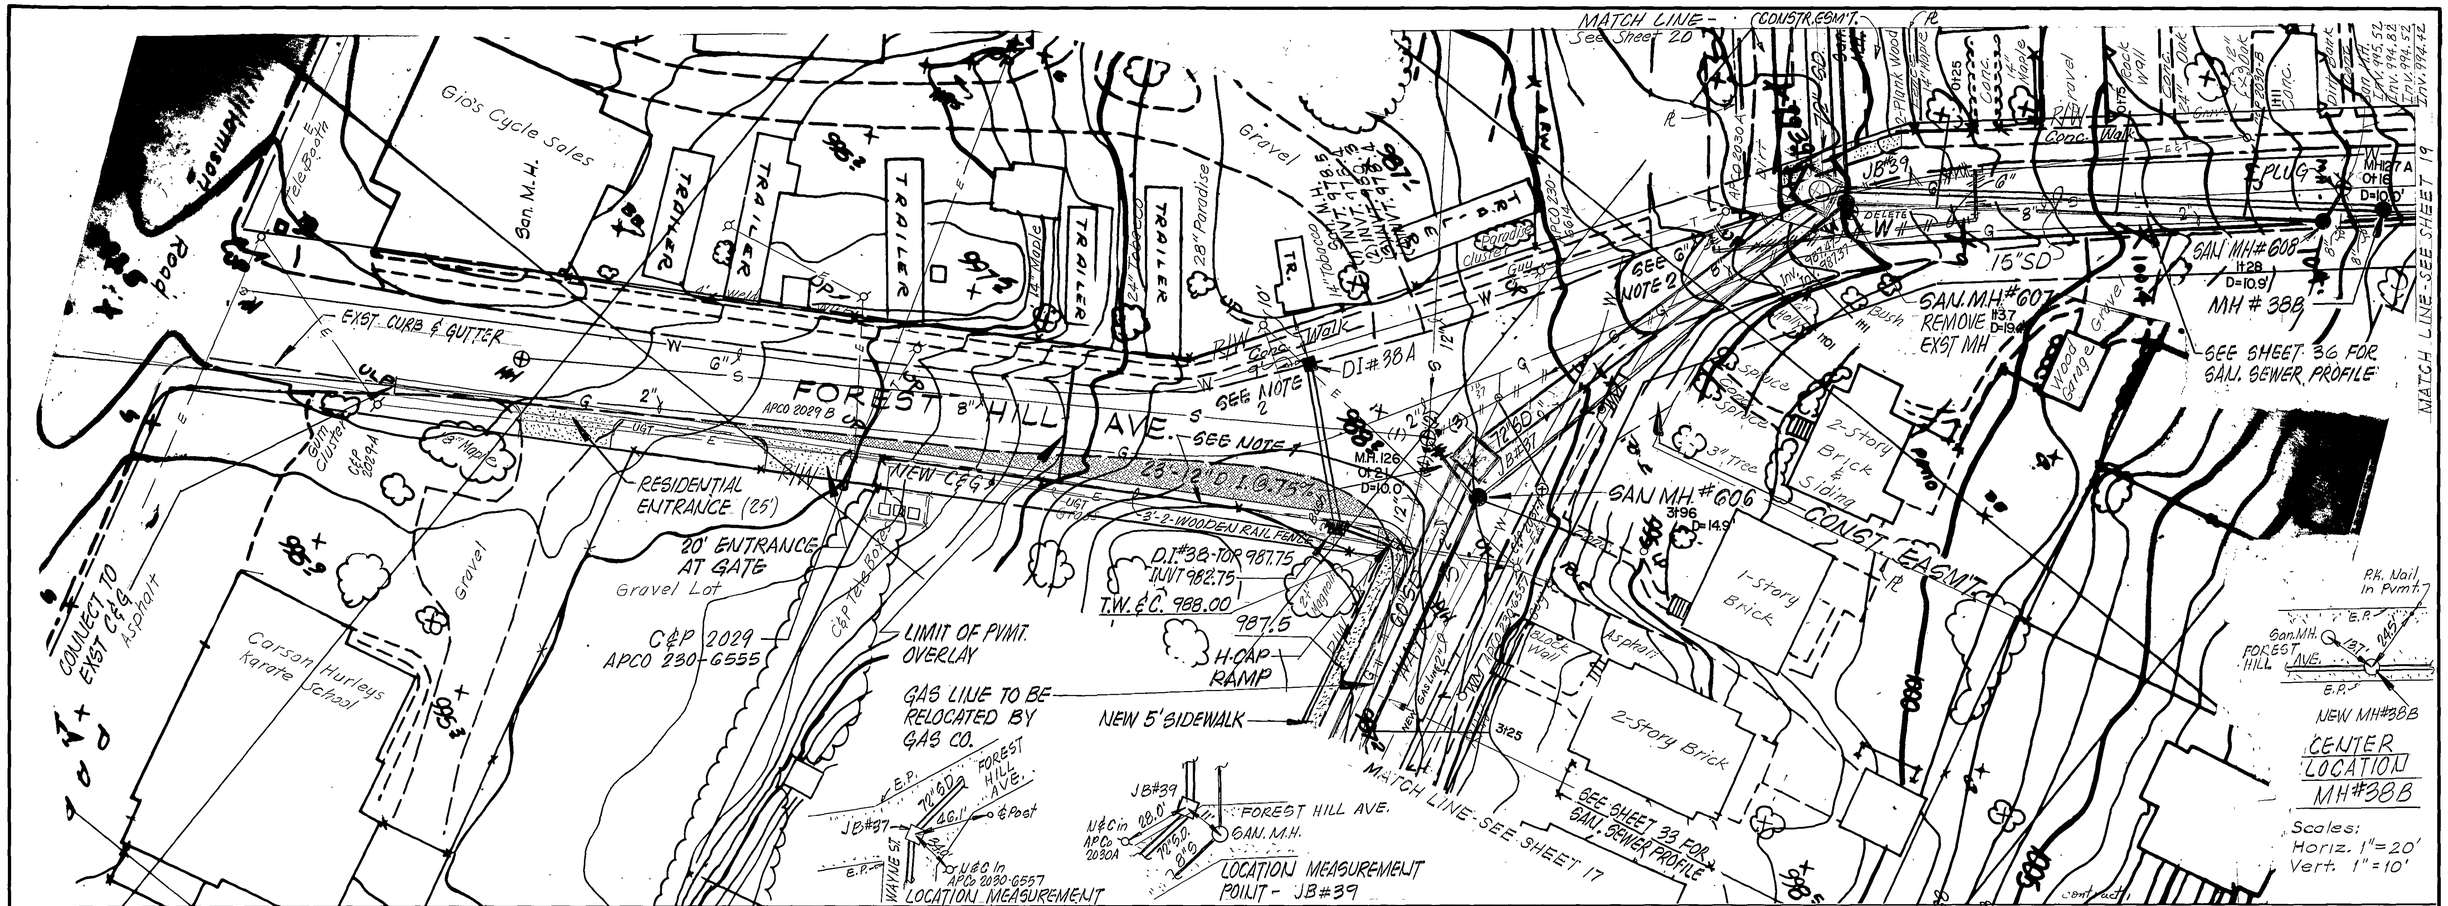

NOTES:

1. The wooden rail fence may be located by property owner prior to construction. If not, contractor shall carefully remove posts and rails and place on property of fence owner.
2. Contractor shall crown street with overlay to provide positive drainage to both inlets.

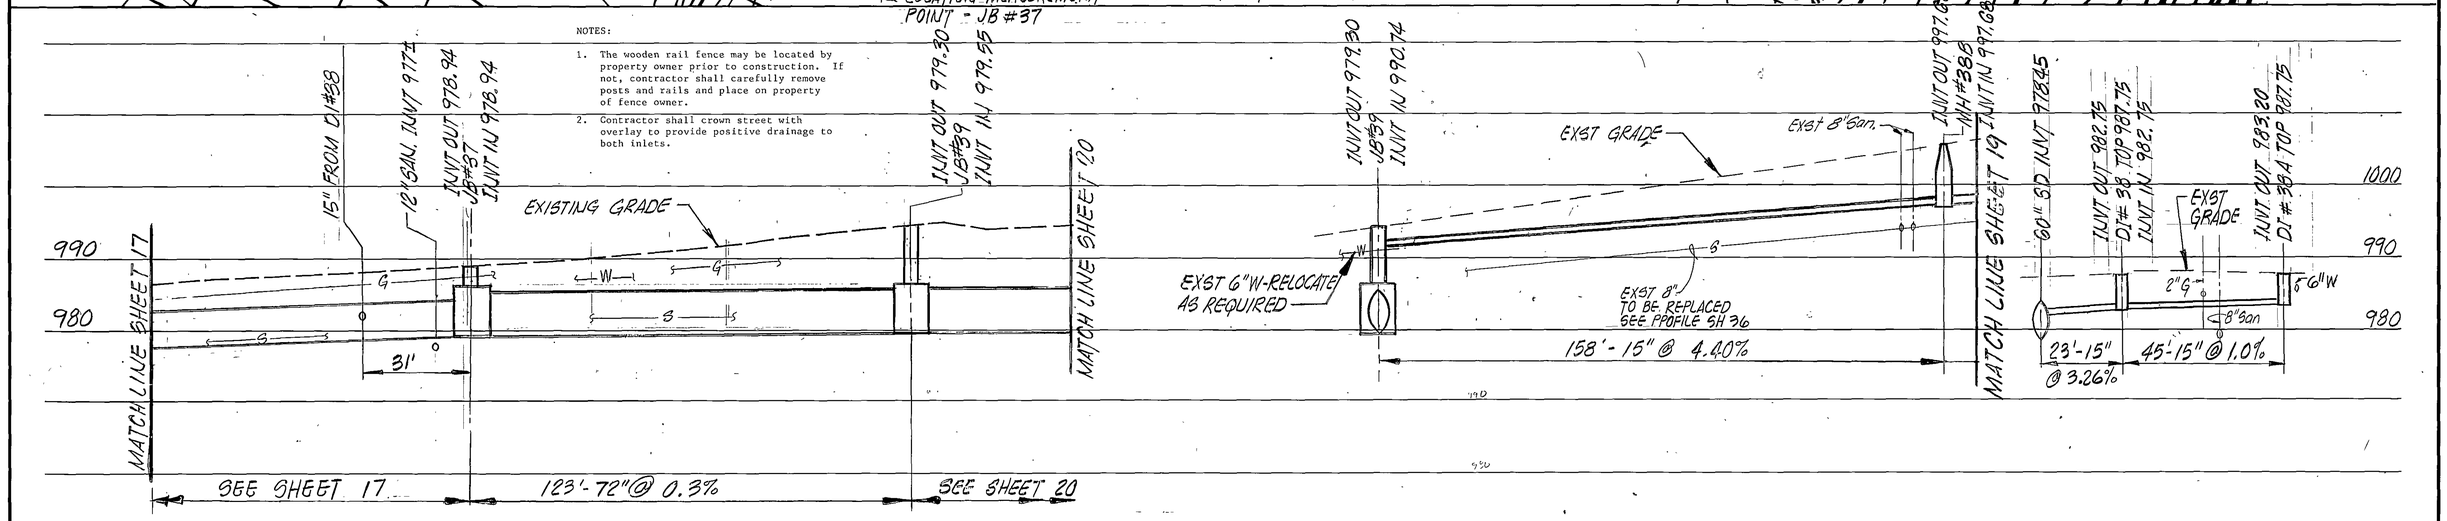

AS-BUILT

Mattern & Craig
CONSULTING ENGINEERS
SUITE 401 707 S JEFFERSON STREET ROANOKE VIRGINIA 24011 (703) 345-9342

DESIGNED: CAT
CHECKED: Switt
APPROVED: Switt

COMMONWEALTH OF VIRGINIA
STEWART W. HUBBELL
No. 07420
PROFESSIONAL ENGINEER

NORTH

REVISION	DATE	DESCRIPTION	BY	APP
1	3-15-85	REV. SAN. & SD		SWH
2	11-10-86	RECORD DRAWINGS	JD	SWH

DATE
JULY 1983
COMM. 428

WILLIAMSON ROAD STORM DRAIN - PHASE 1
CONTRACT I
ROANOKE, VIRGINIA

PLAN AND PROFILE

SHEET 18