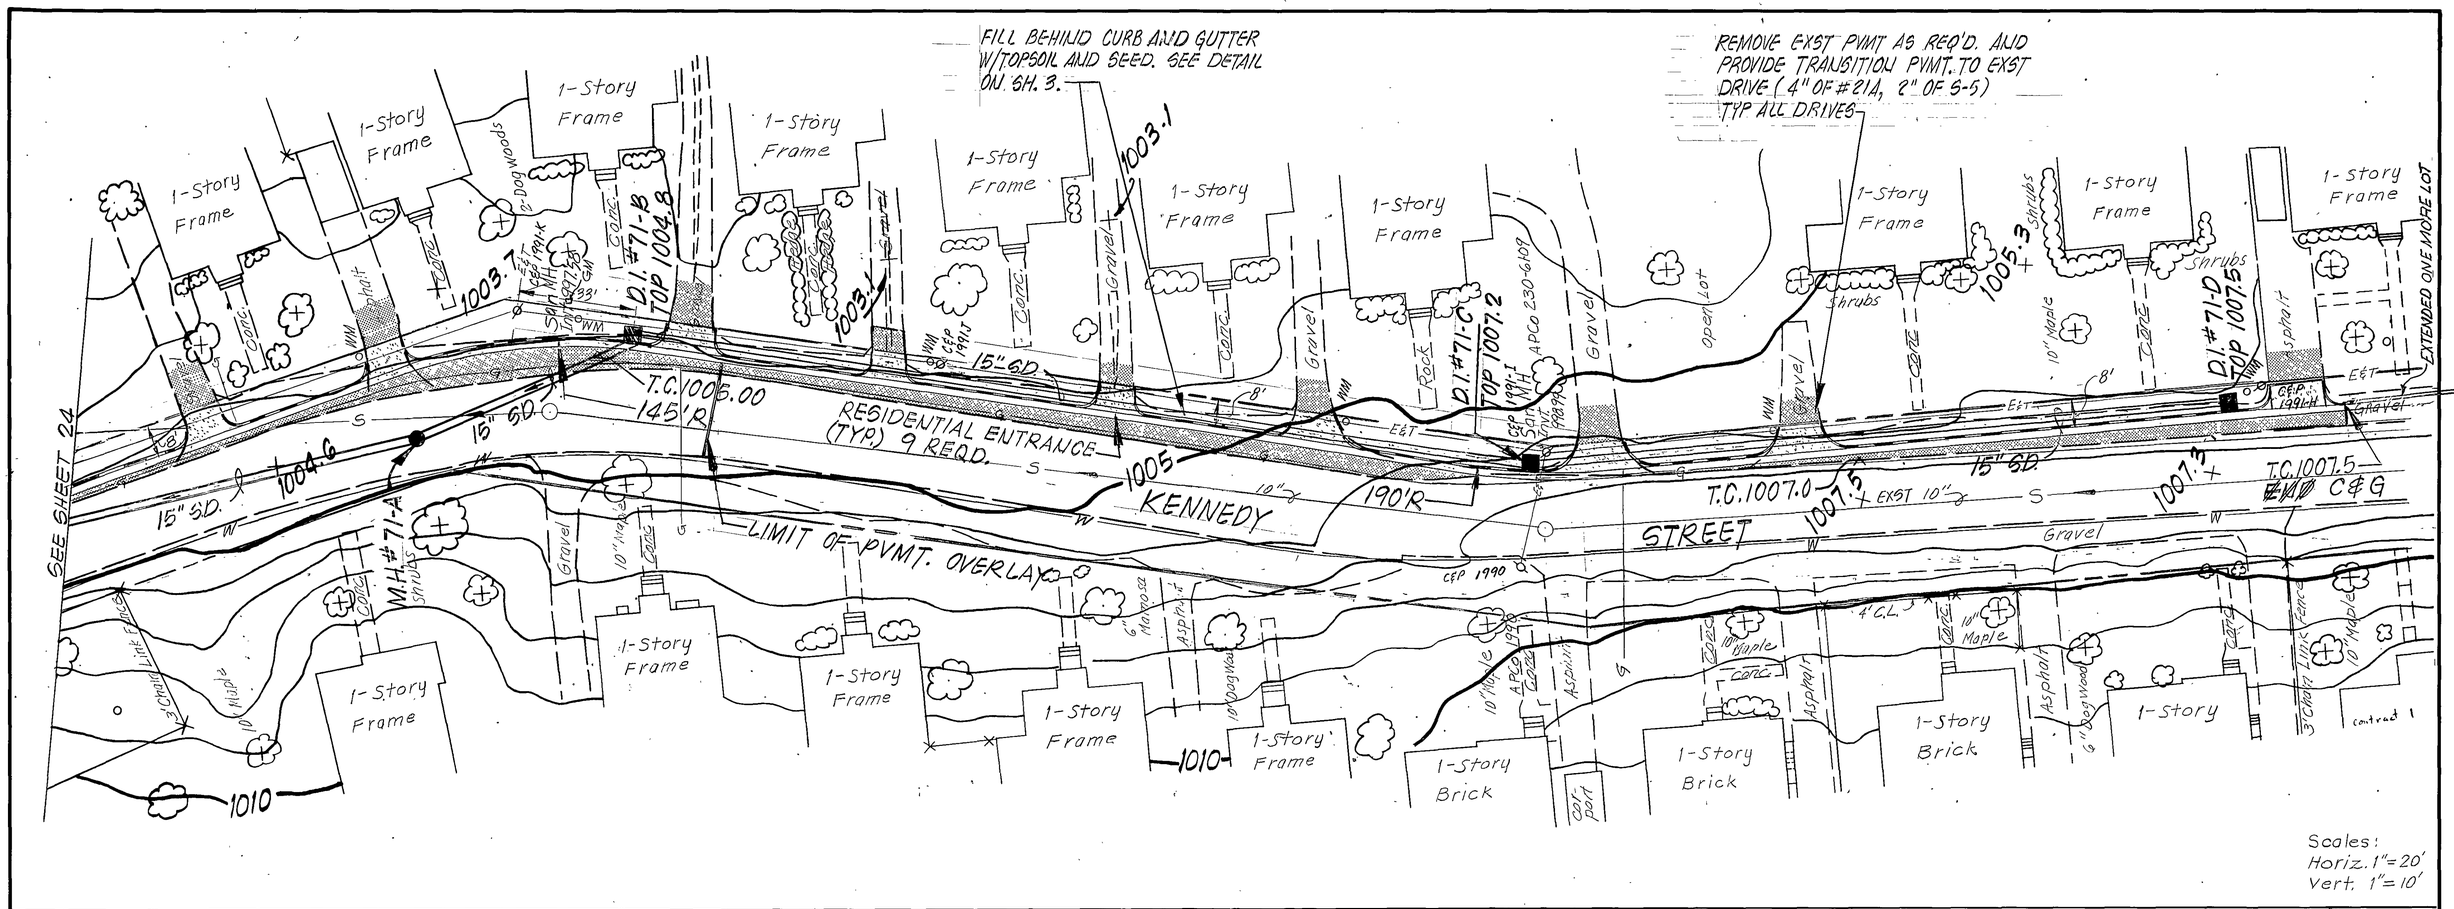

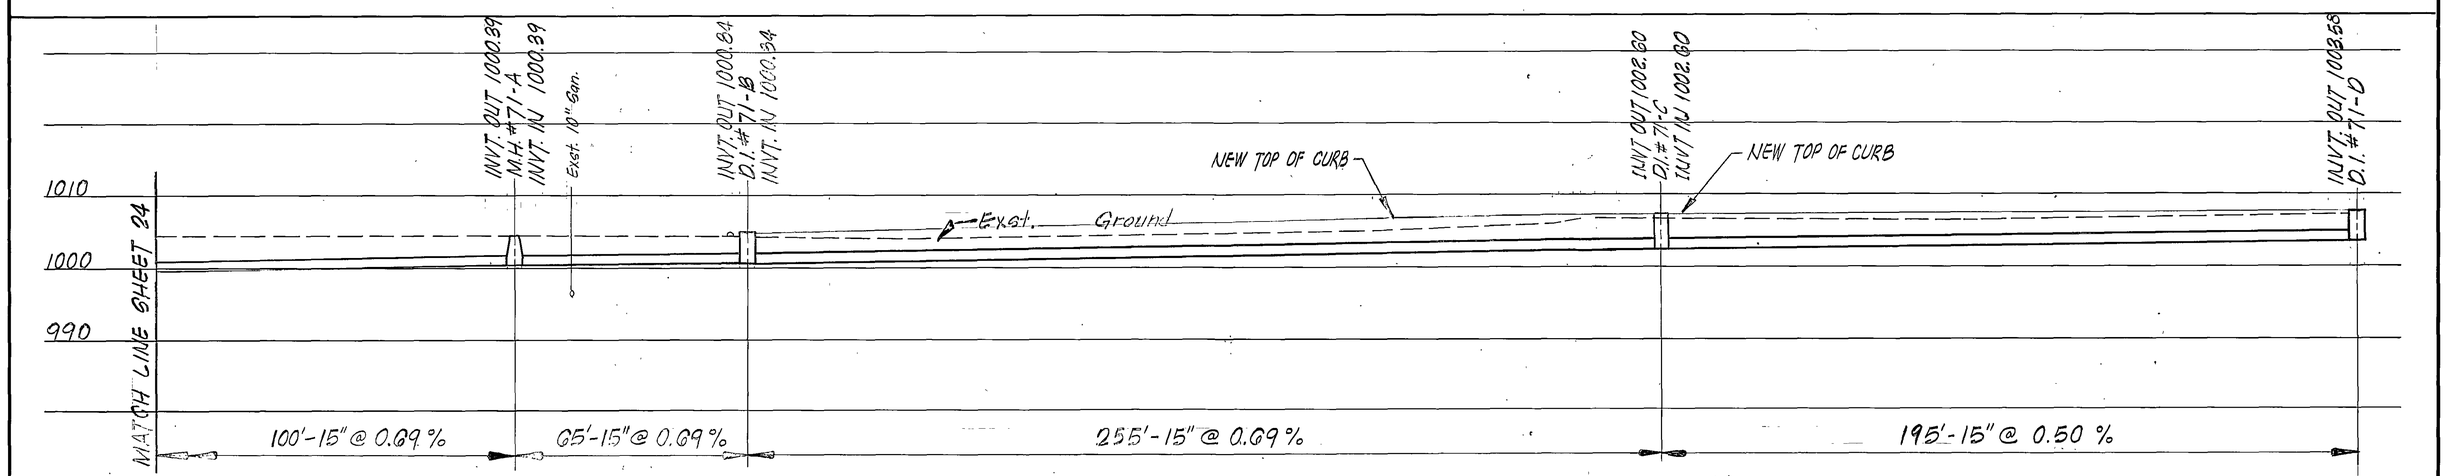

PROFILE - 15" S.D. KENNEDY ST.

AS-BUILT

Mattern & Craig
CONSULTING ENGINEERS
SUITE 401, 707 S. JEFFERSON STREET, ROANOKE, VIRGINIA 24011 (703) 345-9342

DESIGNED: CAT
CHECKED:
APPROVED:

COMMONWEALTH OF VIRGINIA
STEWART W. HUBBELL
No. 07420
PROFESSIONAL ENGINEER

NORTH

REVISION	DATE	DESCRIPTION	BY	APP.
1	11-10-86	RECORD DRAWINGS	JD	

DATE
JULY 1983
COMM. 428

WILLIAMSON ROAD STORM DRAIN - PHASE 1
CONTRACT I
ROANOKE, VIRGINIA

PLAN AND PROFILE

SHEET 25