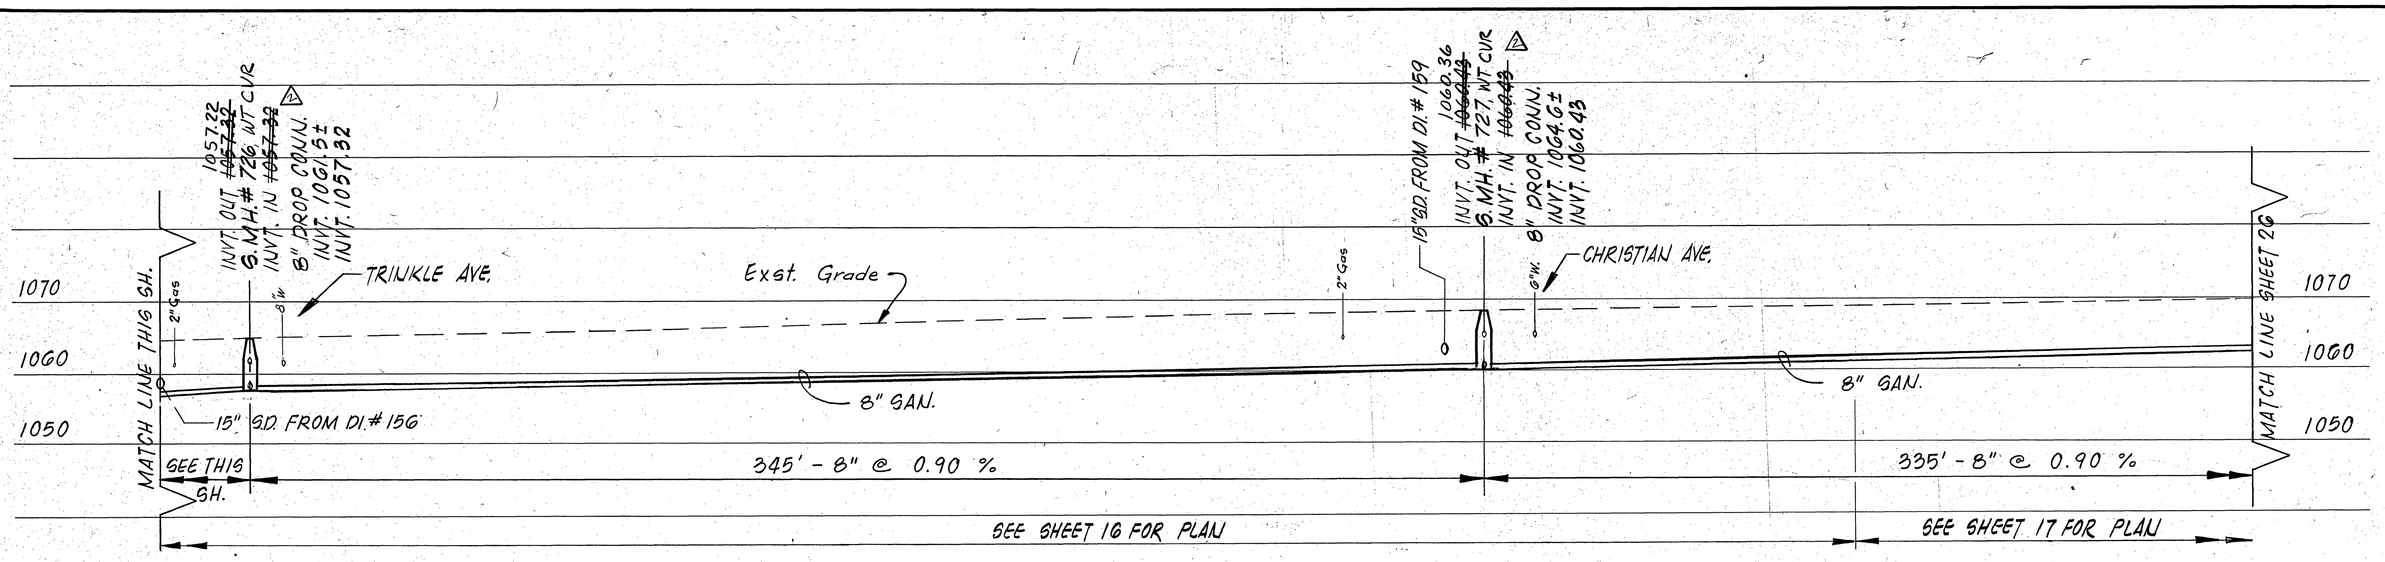

PROFILE - 8" SANITARY

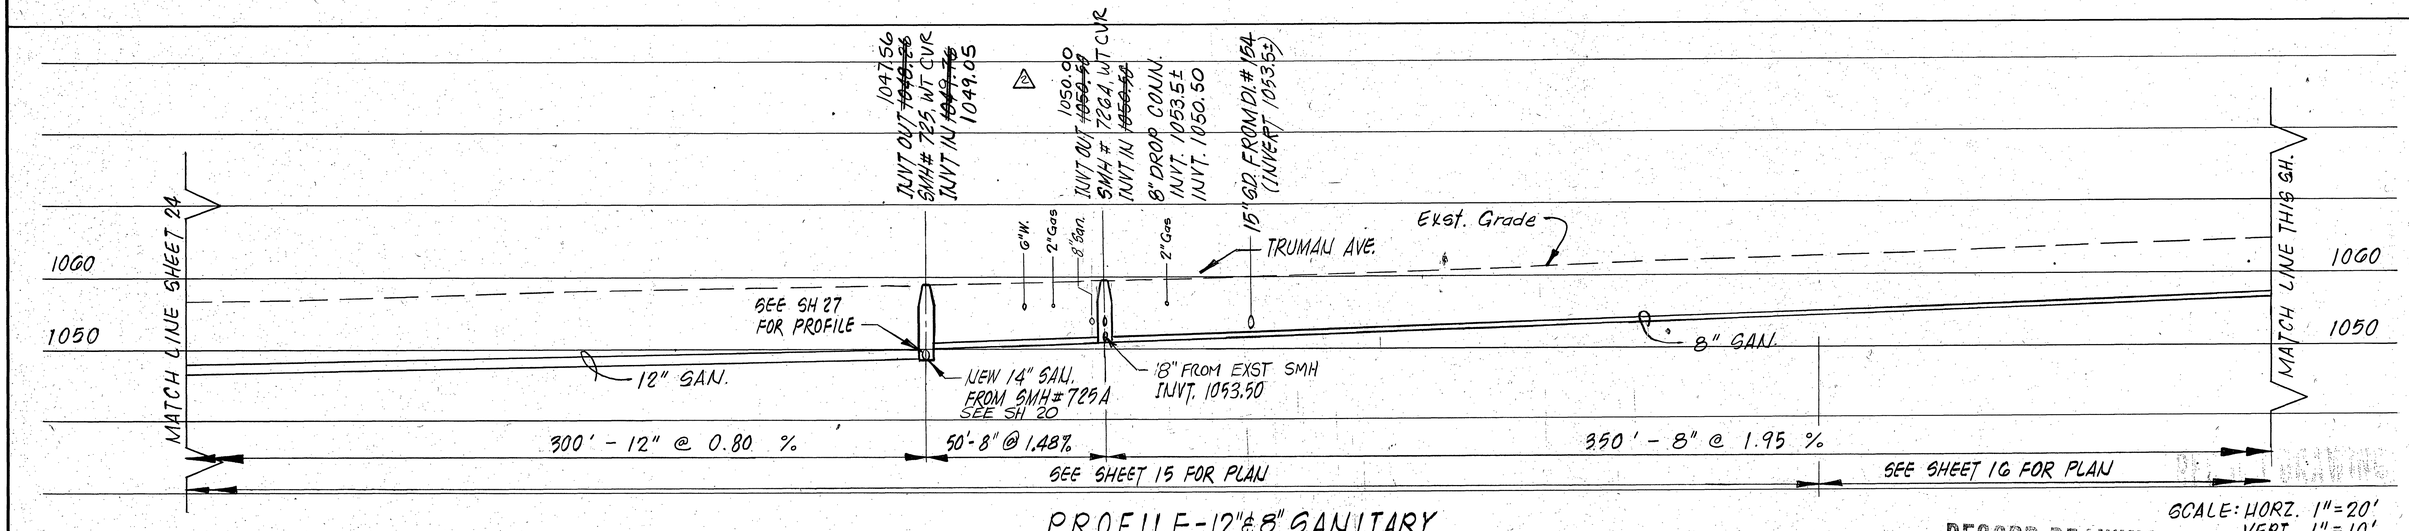

PROFILE - 12" & 8" SANITARY

SCALE: HORZ. 1" = 20'
VERT. 1" = 10'

RECORD DRAWING

Mattern & Craig
CONSULTING ENGINEERS
SUITE 401, 707 S. JEFFERSON STREET ROANOKE, VIRGINIA 24011 (703) 345-9342

DESIGNED: JWC
CHECKED: SWH
APPROVED:

COMMONWEALTH OF VIRGINIA
STEWART W. HUBBELL
07420
PROFESSIONAL ENGINEER

REVISION	DATE	DESCRIPTION	BY	APP.
1	1-11-86	REV. INVERTS		SWH
2	9/16/88	RECORD DWG		SWH

DATE
JULY 1983
COMM. 428

WILLIAMSON ROAD STORM DRAIN - PHASE 1
CONTRACT II
ROANOKE, VIRGINIA

SANITARY SEWER PROFILES

SHEET 25