


ABBREVIATIONS

SEE SHEET 3

LEGEND

SEE SHEET 3

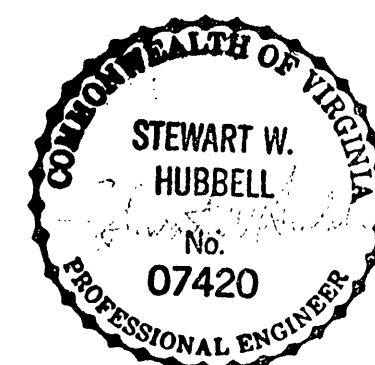

SUMMARY OF QUANTITIES

ITEM		UNIT	QUANTITY	
			PROPOSAL	ACTUAL
1.	MOBILIZATION	LS	1	1
2.	42" STORM DRAIN	LF	385	350
3.	36" STORM DRAIN	LF	1,232	1,120
4.	33" STORM DRAIN	LF	1,785	1,623
5.	21" STORM DRAIN	LF	849	772
6.	18" STORM DRAIN	LF	1,000	908
7.	16" DUCTILE IRON STORM DRAIN	LF	55	50
8.	15" STORM DRAIN	LF	555	505
9.	JUNCTION BOX BASE	EA	1	1
10.	6' DIA. SD MANHOLE BASE	EA	6	5
11.	5' DIA. SD MANHOLE BASE	EA	5	4
12.	4' DIA. SD MANHOLE BASE	EA	8	7
13.	4' DIA. SD MANHOLE RISER	VF	160	145
14.	STORM DRAIN MH FRAME & COVER	EA	19	17
15.	36" BEND	EA	1	1
16.	DI-3C INLET- 12' THROAT	EA	2	2
17.	DI-3C INLET- 8' THROAT	EA	1	1
18.	DI-3C INLET- 4' THROAT	EA	5	4
19.	DI-3A INLET	EA	15	13
20.	10" SANITARY SEWER - DUCTILE IRON	LF	2,809	2,554
21.	8" SANITARY SEWER - DUCTILE IRON	LF	947	861
22.	8" SANITARY SEWER - PVC	LF	395	359
23.	10" X 6" SANITARY WYE - DUCTILE IRON	EA	35	31
24.	8" X 6" SANITARY WYE - DUCTILE IRON	EA	12	10
25.	8" X 6" SANITARY WYE - PVC	EA	9	7
26.	SANITARY SEWER MANHOLE	VF	232	211
27.	SANITARY SEWER MH - FRAME & COVER	EA	23	21
28.	8" SANITARY SEWER DROP CONNECTION	VF	103	94
29.	SANITARY SEWER LATERAL - DUCTILE IRON	LF	1,065	968
30.	SANITARY SEWER LATERAL - PVC	LF	67	57
31.	AGGREGATE BASE MATERIAL	TN	4,639	4,217
32.	BITUMINOUS CONCRETE BASE MATERIAL	TN	2,528	2,298
33.	BITUMINOUS CONCRETE SURFACE MATERIAL	TN	1,044	949
34.	CONCRETE CURB AND GUTTER	LF	1,203	1,094
35.	CONCRETE SIDEWALK	SY	409	372
36.	CONCRETE ENTRANCES & DRIVEWAYS	SY	172	156
37.	TRENCH STABILIZATION MATERIAL	TN	550	500
38.	ROCK	CY	700	636
39.	SELECT BACKFILL MATERIAL	CY	378	344
40.	REINFORCED CONCRETE NOT FORMED	CY	120	109
41.	8" CLEANOUTS	EA	5	4

PROJECT NUMBER 5831

SHEET NUMBER 2 OF 46