NOTES:

1. SEE SH 42 FOR SANITARY SEWER PROFILE.
2. CONNECT EXST SANITARY SEWER LATERALS TO NEW SEWER.

SCALE: HORIZ 1"=20'
VERT 1"=10'

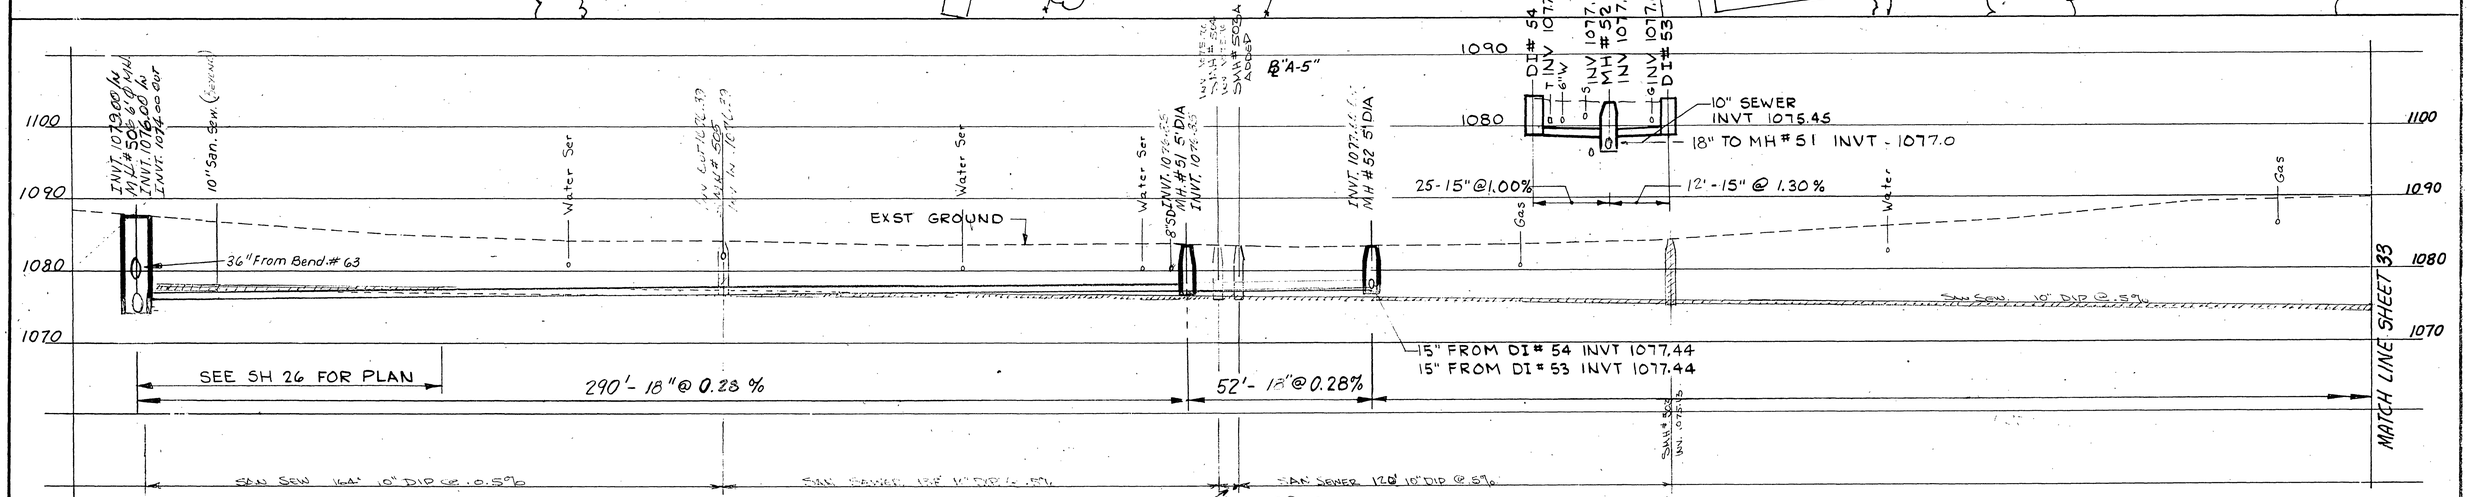

Mattern & Craig
CONSULTING ENGINEERS
SUITE 401 707 S. JEFFERSON STREET ROANOKE VIRGINIA 24011 (703) 345-9342

DESIGNED:	JLJ / SWH
CHECKED:	SWH
APPROVED:	SWH

NORTH

REVISION	DATE	DESCRIPTION	BY	APP

DATE
JULY 1986
COMM. 582

WILLIAMSON ROAD STORM DRAIN - PHASE 2
CONTRACT I-C

ROANOKE, VIRGINIA

PLAN AND PROFILE

SHEET 32

PLAN NO. 5831