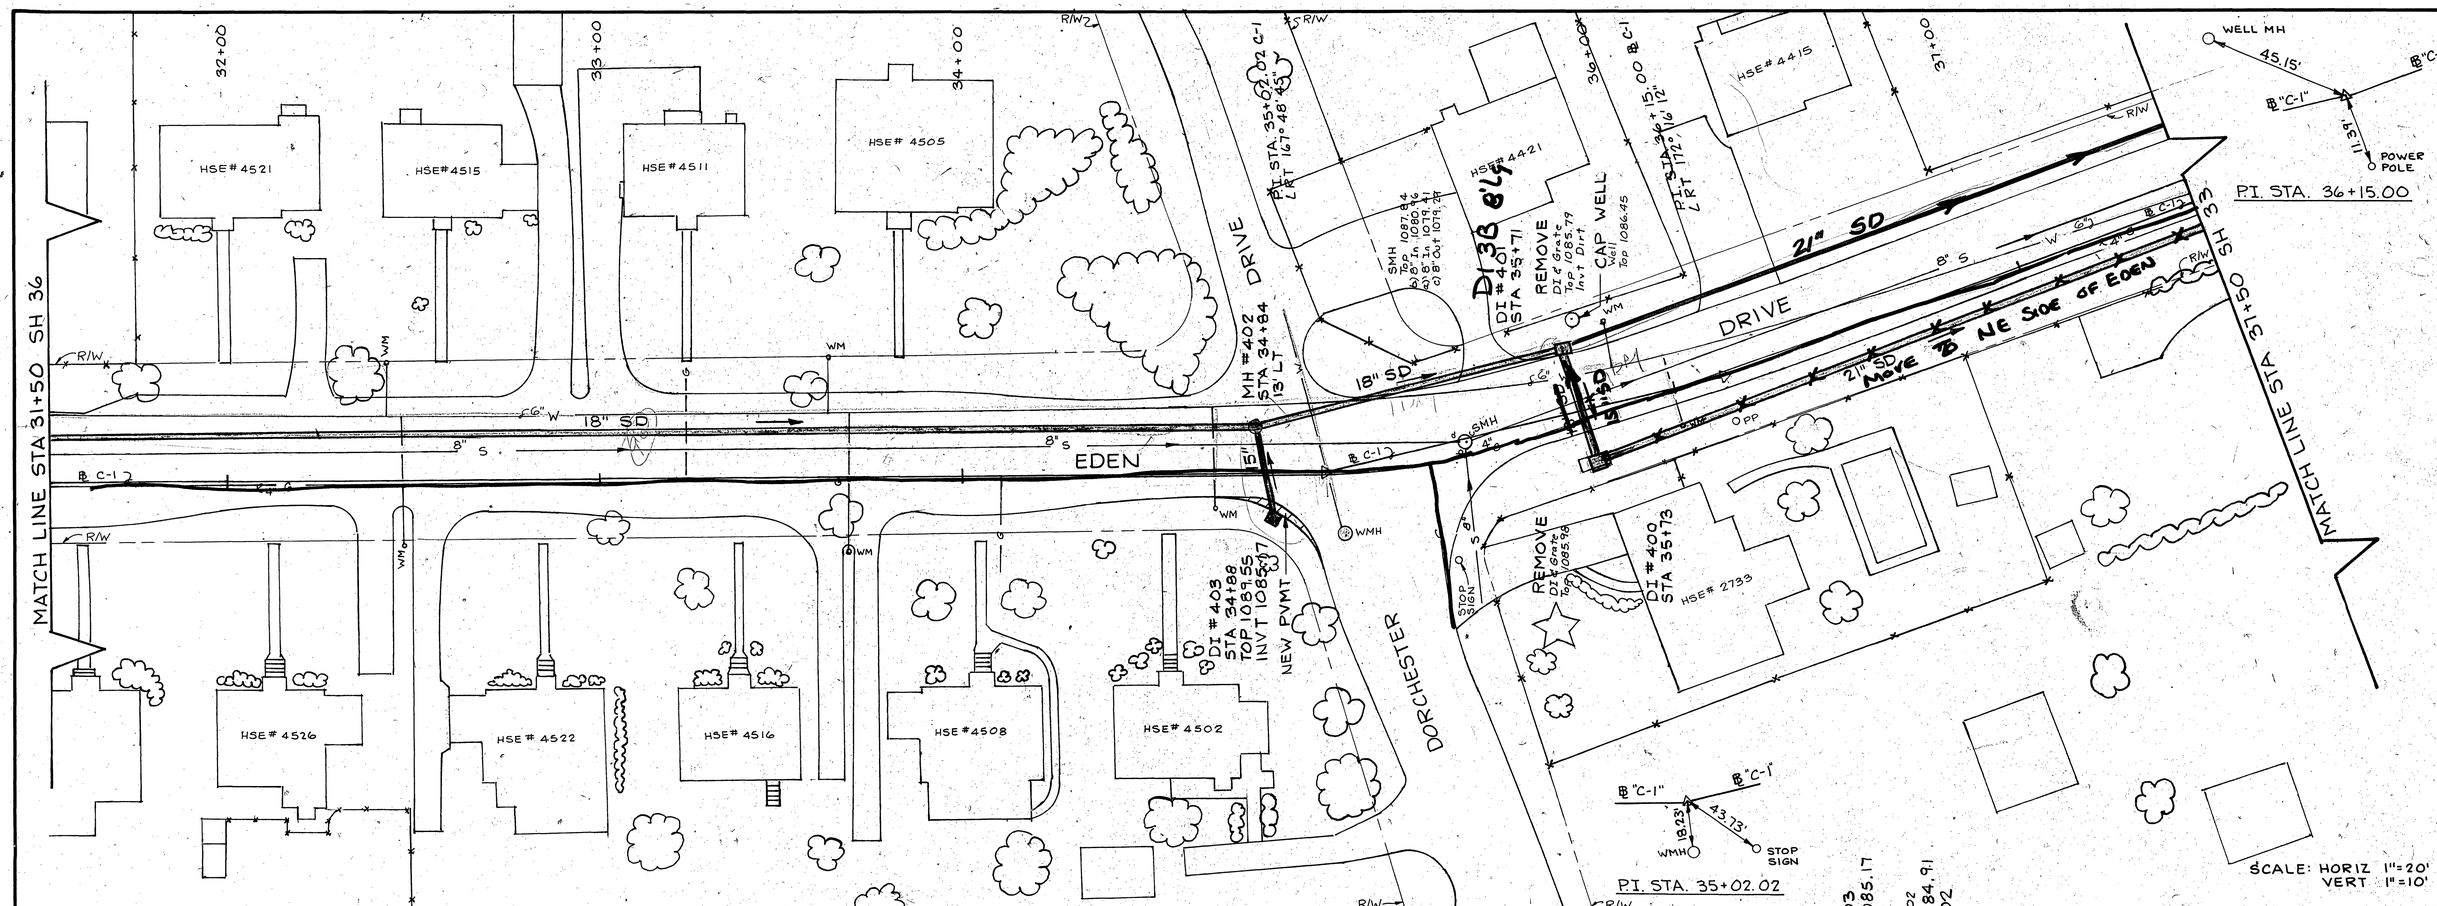


Mattern & Craig
CONSULTING ENGINEERS
SUITE 401, 707 S. JEFFERSON STREET, ROANOKE, VIRGINIA 24011, (703) 345-9342

DESIGNED: JLJ / SWH
CHECKED: SWH
APPROVED: SWH

STEPHANIE W. HUBBELL 07420

NORTH

| REVISION | DATE | DESCRIPTION | BY | APP. |
|---|---|---|---|---|
| | | | | |

DATE
JULY 1986
COMM. 582

**WILLIAMSON ROAD STORM DRAIN - PHASE 2**
**CONTRACT I-C**
**ROANOKE, VIRGINIA**

**PLAN AND PROFILE**

SHEET 35

PLAN NO. 5831