(FOR SANITARY PROFILE SEE SHEET 51)

SAN. MH. #110
STA. 31+65.5,
22' LT. ℄ A

MATCH LINE STA. 32+25 SH. 9

P.I. STA. 28+35.17
222°30'42" ℄ A
RT.

28+00

29+00

30+00

PAVED PARKING LOT

D.I.
Top 973.25
Invt. In 968.85
Invt. Out 968.65

D.I.
Top 972.85
Invt. Out 969.35

D.I.
Top 977.18
Invt. In 972.88
Invt. Out 972.58

D.I.
Top 975.77
Invt. Out 973.47

P/P C&P 2102 A
254-4037

San MH.
Top 972.09
10" Invt. In 964.69
6" Invt. In 965.29
Invt. Out 964.49

Guy

P/P C&P 2002 A
P.K. NAIL
Guy

SAN. MH. #108
STA. 28+46,
26.5' LT. ℄ A

SAN. MH. #109
STA. 30+84,
22' LT. ℄ A

GRASS FIELD

PLUG

SAN. MH. #107
STA. 28+7.5,
12' LT. ℄ A

REPLACE WITH NEW
CURB AND GUTTER

REPLACE SEWER
LATERAL

COURTLAND ROAD

54" SD

Bit. Pavement

CONSTR. ℄ A

P.K. NAIL

JB. #10
STA. 28+50,
18.5' LT. ℄ A

45° BEND #11
STA. 30+86,
16' LT. ℄ A

32+00
45° BEND #12
STA. 31+63.5,
16' LT. ℄ A

P.K. NAIL
P/P 2104 D
254-2102
Guy
WM
San. MH. (Clean Out)
Top 977.86

P.I. STA.
31+24.56 ℄ A
89°38'45" RT.

SYCAMORE AVE.

THURSTON AVENUE

HSE. #102
HSE. #106
HSE. #107
HSE. #110
HSE. #114
HSE. #118

MATCH LINE STA. 27+50 SH. 7

San MH.
Top 972.48
(a) Invt. In 969.28
(b) Invt. In 968.08
(c) Invt. In 963.28
Invt. Out 963.18

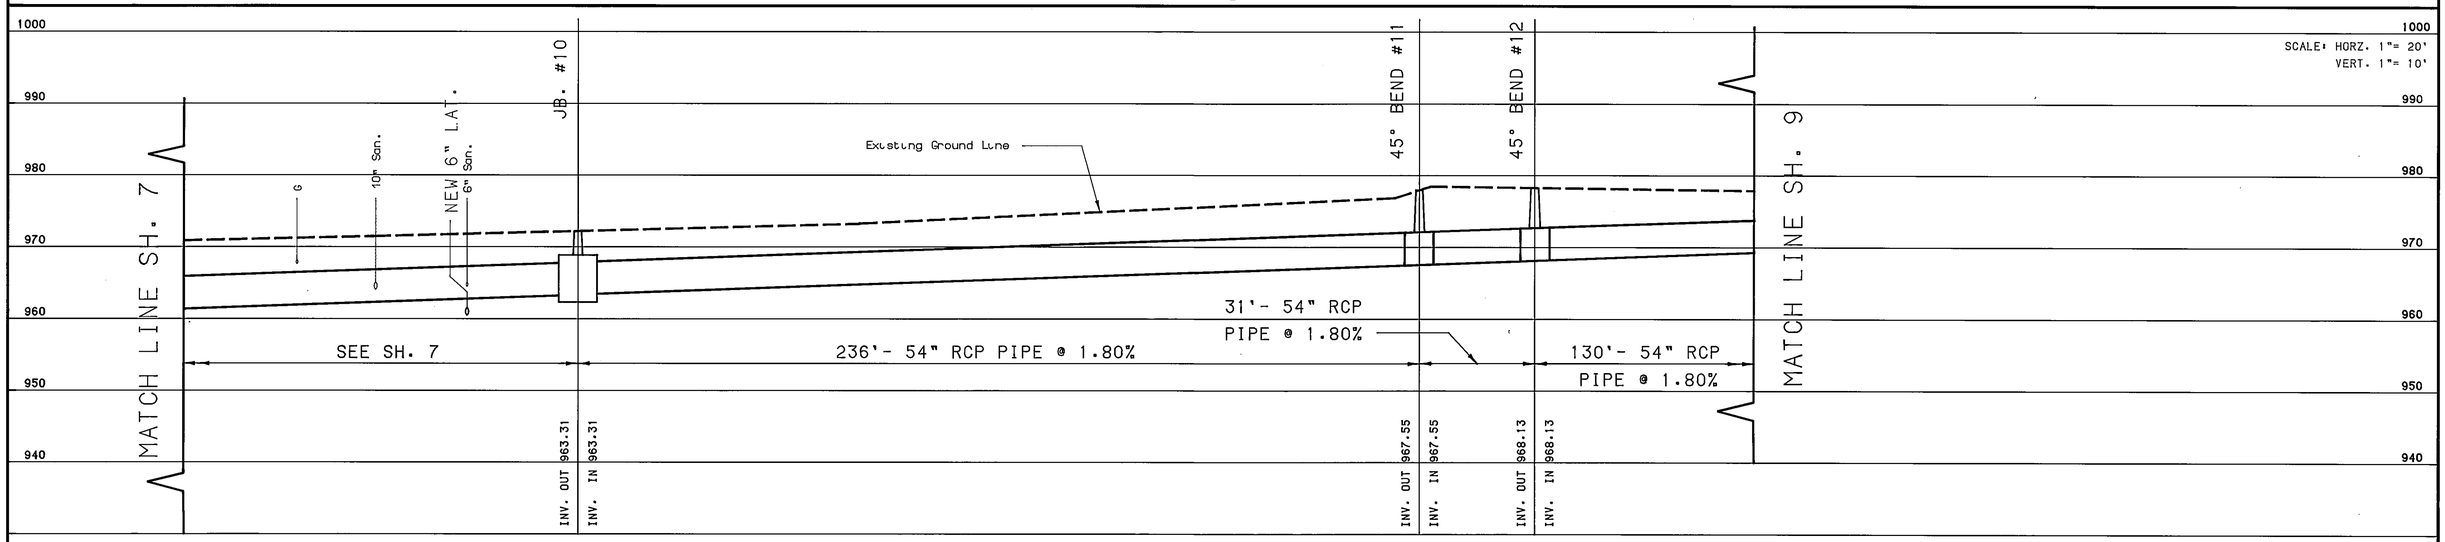

Mattern & Craig
CONSULTING ENGINEERS - SURVEYORS
701 FIRST STREET, ROANOKE, VIRGINIA 24016, (703) 345-9342

DESIGNED: ARB/SWH
CHECKED: SHM
APPROVED:

COMMONWEALTH OF VIRGINIA
STEWART W. HUBBELL
No. 07420
PROFESSIONAL ENGINEER

NORTH

REVISION	DATE	DESCRIPTION	BY	APP.
1	DEC. 89	RECORD DRAWING	JLJ	SWH

DATE
JULY
1987
COMM.
580/581

WILLIAMSON ROAD STORM DRAIN- PHASE 2
CONTRACT II-A
ROANOKE, VIRGINIA

PLAN AND PROFILE

SHEET
8

PLAN NO. 5826