JB #21
STA. 43+14.5,
9' LT. ℄ A

SAN. MH. #120
STA. 43+20.5,
17' LT. ℄ A

P.I. STA. 43+24.19 ℄ A
269°14'33" RT.

LIMIT OF PVMT. OVERLAY

LIMIT OF PVMT. OVERLAY

BACKFILL BEHIND NEW CURB

NEW CG-6

B.M. #6

P/P C&P 2110 A
254-4065
P.K. NAIL

Anchor Pole
C&P 2107 F
254-4082
P.K. NAIL

60" SD

72" SD

12" SD

MATCH LINE STA. 42+00 SH. 10

MATCH LINE STA. 44+00 SH. 19

B.M. #6- TOP OF FLANGE BOLT ON FRONT SIDE OF FIRE HYDRANT ON N.E. CORNER OF COURTLAND ROAD AND CLOVER AVE.
ELEV. 1003.39

(FOR SANITARY PROFILE SEE SHEETS 52 AND 53)

NOTE: 1. CONN. EXST. HOUSE LATERALS TO NEW 12" SEWER IN CLOVER AND COURTLAND

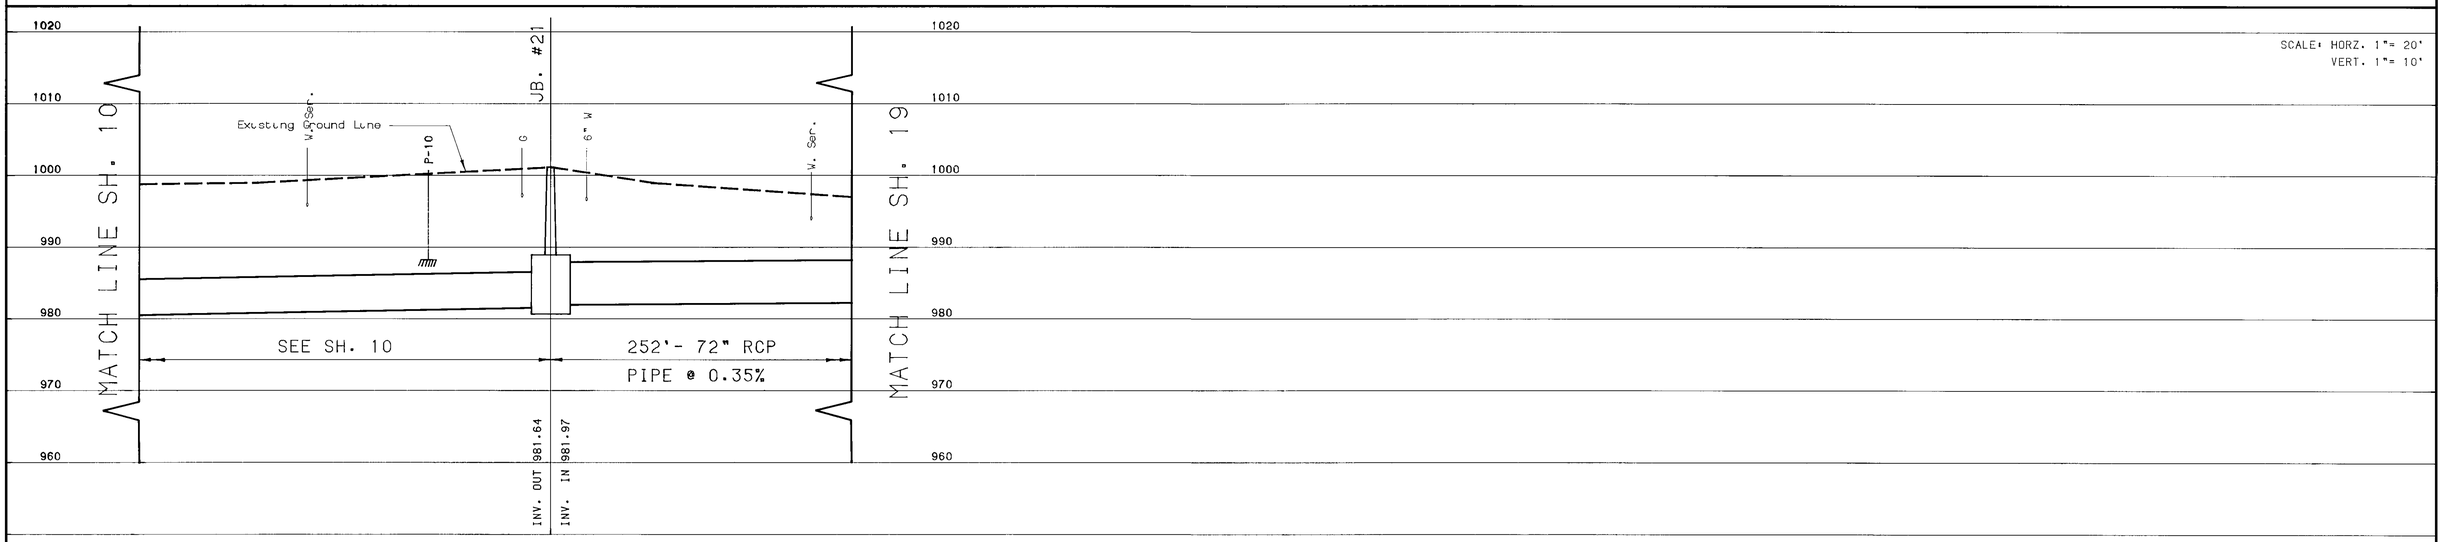

Mattern & Craig
CONSULTING ENGINEERS - SURVEYORS
701 FIRST STREET, ROANOKE, VIRGINIA 24016, (703) 345-9342

DESIGNED: ARB/SWH
CHECKED: SHM
APPROVED:

COMMONWEALTH OF VIRGINIA
STEWART W. HUBBELL
No. 07420
PROFESSIONAL ENGINEER

NORTH

REVISION	DATE	DESCRIPTION	BY	APP.
1	DEC. 89	RECORD DRAWING	JLJ	SWH

DATE
JULY
1987
COMM.
580/581

WILLIAMSON ROAD STORM DRAIN- PHASE 2
CONTRACT II-A
ROANOKE, VIRGINIA

PLAN AND PROFILE

SHEET
11

PLAN NO. 5826