(FOR SANITARY PROFILE SEE SHEET 56)

66+00 67+00 68+00 69+00 70+00

MATCH LINE STA. 10+90 SH. 32

LIMIT OF REGRADE AND PVMT. OVERLAY

(ABANDON)
San. MH.
(Located From City Sewer Maps)

(CAP)
Drainage Well No. 58
Top 1007.40
Invt. In 1001.60
Top Of Casing 1001.42

NEW CONC. ENTR.

NEW CG-6

RELOCATE GAS LINE

REPLACE EXST. C & G WITH NEW CG-6 AT NEW LOCATION

HSE. #2702 HSE. #2710 HSE. #2704 HSE. #2537 HSE. #2538 HSE. #2707 HSE. #2711 HSE. #2719

DRIVE GRAVEL PAVED DRIVE PAVED R/W WM P/P

54" SD

HILLCREST AVENUE

12" S 8" W 12" E 18" SD

E.P.

LIMIT OF PVMT. OVERLAY

OVERLAY STREET

SAN. MH. #137
STA. 69+40,
6' LT. ℄ A

MH. TEE #42
STA. 69+44,
12' LT. ℄ A

REPLACE PVMT. ONLY OVER TRENCH

P/P #230- 3697

P/P #230- 3633

N 353,200 E 1,581,200

N 353,000 E 1,581,000

REMOVE EXST. 8" SAN.

SAN. MH. #136
(REPLACE)
San. MH.
Top 1009.61

P.O.T. STA. 69+29.73 ℄ A=
180°00'00" RT.
B.O.L. STA. 10+00.00 ℄ F=
90°39'12" RT.

MATCH LINE STA. 65+90 SH. 16

MATCH LINE STA. 71+00 SH. 22

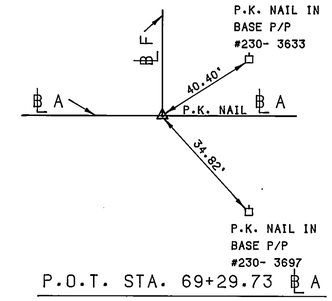

P.O.T. STA. 69+29.73 ℄ A

SCALE: HORZ. 1"= 20'
VERT. 1"= 10'

1030 1020 1010 1000 990 980 970

MATCH LINE SHEET 16

MATCH LINE SHEET 22

W. Ser. W. Ser. W. Ser. P-108

Existing Ground Line

Gas NEW 6" W P-109

MH. TEE #42

8" SAN

NEW 18" SD FROM MH. #43

INV. OUT 995.63

INV. IN 995.63

INV. IN 1001.11

SEE SHEET 16

281'- 54" RCP PIPE @ 0.86%

Mattern & Craig
CONSULTING ENGINEERS - SURVEYORS
701 FIRST STREET, ROANOKE, VIRGINIA 24016, (703) 345-9342

DESIGNED: ARB/SWH
CHECKED: GRN
APPROVED:

COMMONWEALTH OF VIRGINIA
STEWART W. HUBBELL
No. 07420
PROFESSIONAL ENGINEER

NORTH

REVISION	DATE	DESCRIPTION	BY	APP.
1	DEC. 89	RECORD DRAWING	JLJ	SWH

DATE
JULY 1987
COMM.
580/581

WILLIAMSON ROAD STORM DRAIN- PHASE 2
CONTRACT II-A
ROANOKE, VIRGINIA

PLAN AND PROFILE

SHEET 21

PLAN NO. 5827